


1,000 NORTH

1,000 NORTH

14,000 EAST

15,000 EAST

16,000 EAST

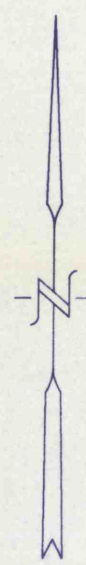

ZERCO COAL CO.
#11 Vein

NUMBER 12 COAL CO.

MARQUETTE COAL CO.

BUFFALO EXHAUST FAN
1,750 RPM, WG = 1"

TRAILER OFFICE
HOIST NO.


BIG PINE COAL CO.

TAGLIERI COAL CO.

CHESTNUT COAL CO.


O-NORTH
O-SOUTH

O-NORTH
O-SOUTH

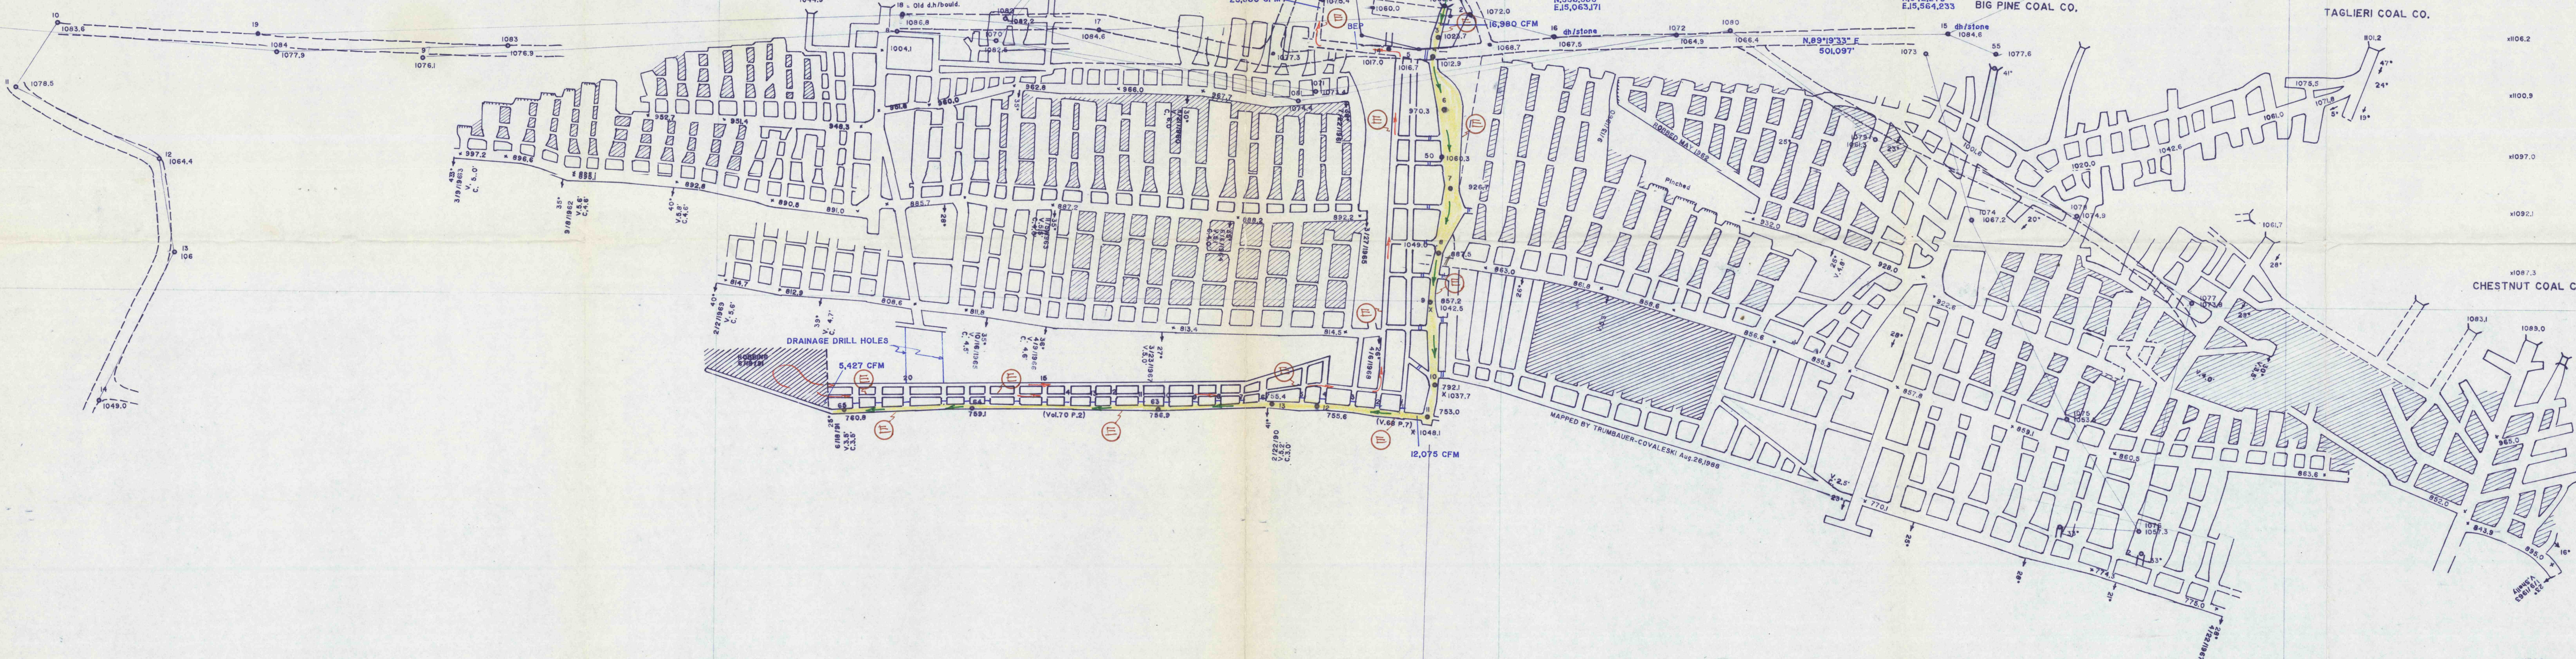


MINE MAP of the
12 COAL COMPANY
situate on the
South Dip #12 Vein
Zerbe Township, Northumberland County
I.D. #36-07773

Copy - 12 VEIN COAL
Mine - 12 VEIN SLOPE
ID#36-07773

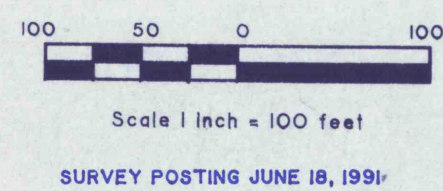

VENTILATION SYMBOLS	
(F)	= Main Fan
(A)	= Auxiliary Fan
→	= Air Flow - Intake
←	= Air Flow - Exhaust
—	= Permanent Stopping
- - -	= Temporary Stopping
⊗	= Air Bridge
R	= Regulator
∇	= Man Door
V	= Velocity, fpm
Q	= Quantity, cfm
WG	= Water Gauge
(E)	= Escapeway
BEP	= Bleeder Evaluation Point

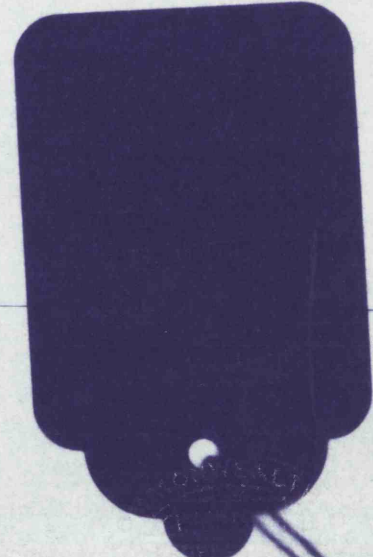

Alfred B. Riedel

289