



 

LEGEND
① ESCAPEWAY - AIRWAY
→ INTAKE AIRWAY
← RETURN AIRWAY
F - SURFACE FAN
II PERMANENT STOPPINGS
GREEN DENOTES MIDDLE BULK
ORANGE DENOTES BOTTOM BULK
I TEMPORARY STOPPINGS.

MINE MAP
CASE TAP SURVEY
SHOWING BOK MTH MINE OF CHARLES SOROKACH
SURVEYED OCT. 23, 1933 SCALE 1"=100'
WALTER J. MANHART E.D. 14128E

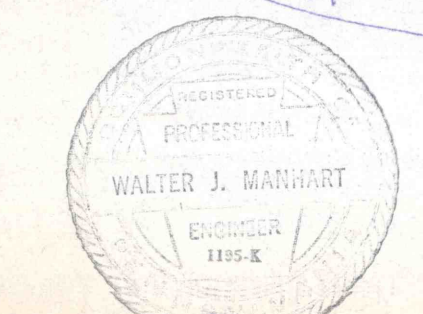

Walter J. Manhart

DATUM 600 LOOKING WEST SCALE 1"=100'
SECTION NO. 29 115 WEST OF
CHARLES SOROKACH SLOPE