


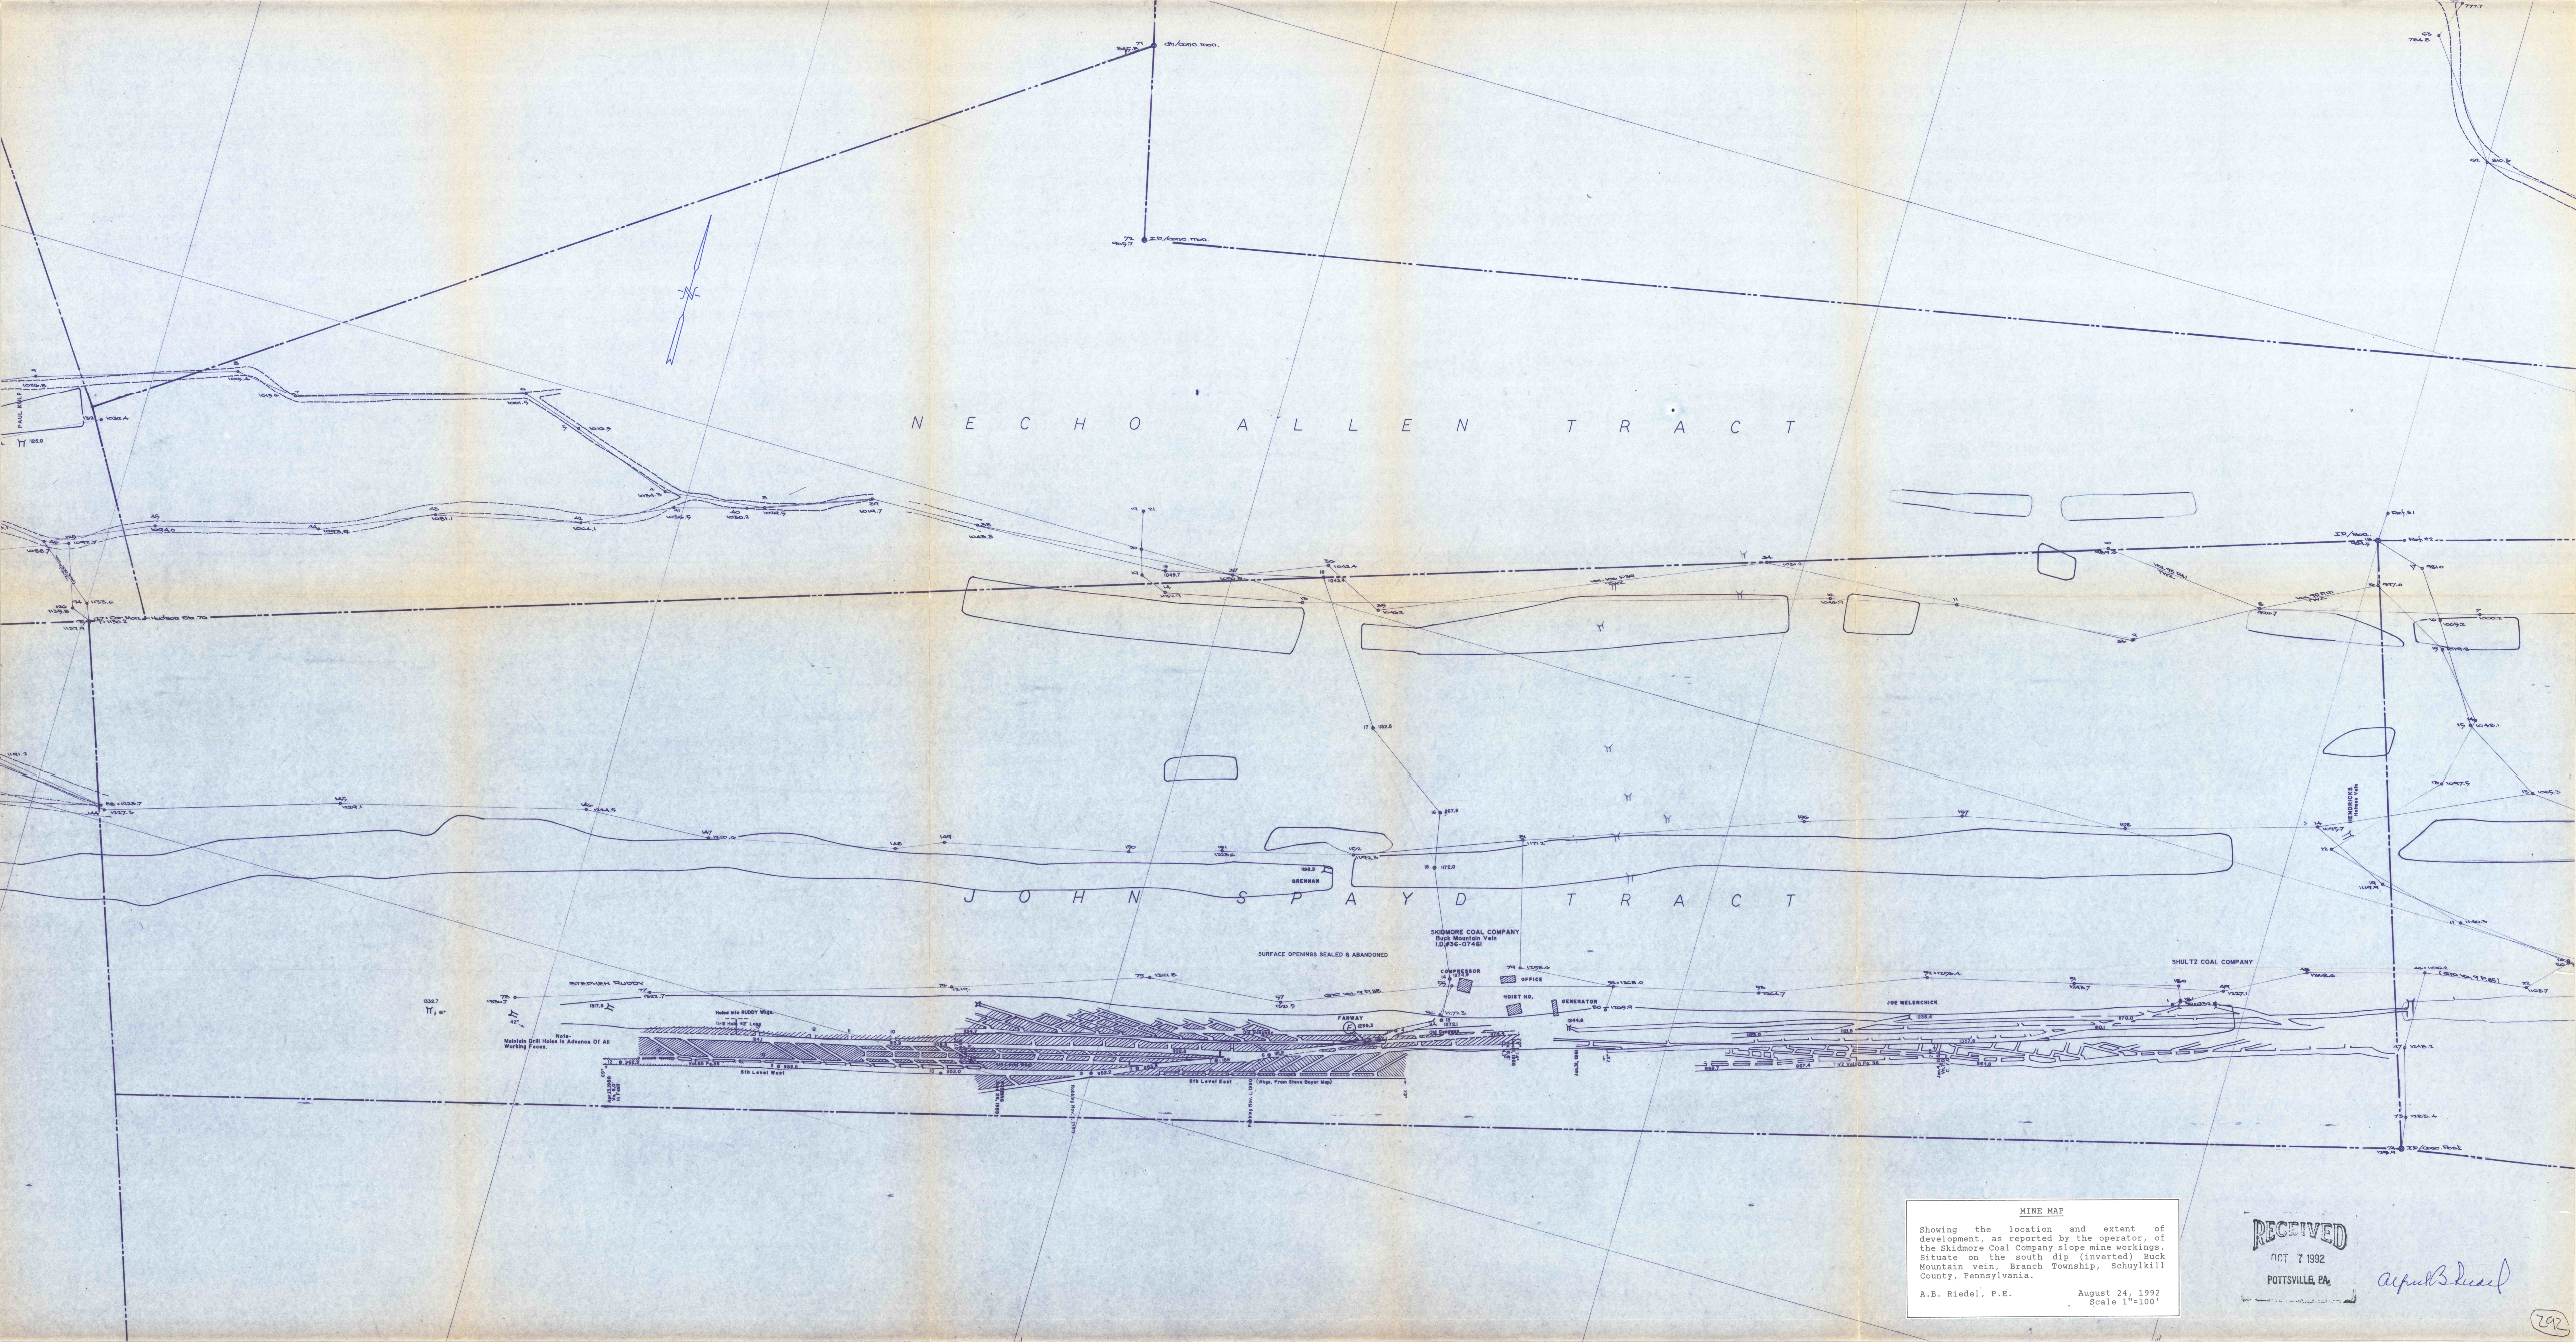

N E C H O A L L E N T R A C T

J O H N S P A Y D T R A C T

SKIDMORE COAL COMPANY
Buck Mountain Vein
(LURSE-0748)

SHULTZ COAL COMPANY

JOE MELENCHICK

Note:
Maintain Drill Holes in Advance of All
Working Faces.

MINE MAP
Showing the location and extent of
development, as reported by the operator, of
the Skidmore Coal Company slope mine workings.
Situate on the south dip (inverted) Buck
Mountain vein, Branch Township, Schuylkill
County, Pennsylvania.
A.B. Riedel, P.E.
August 24, 1992
Scale 1"=100'

RECEIVED
OCT 7 1992
POTTSVILLE, PA.

A. B. Riedel