



READING ANTHRACITE CO.

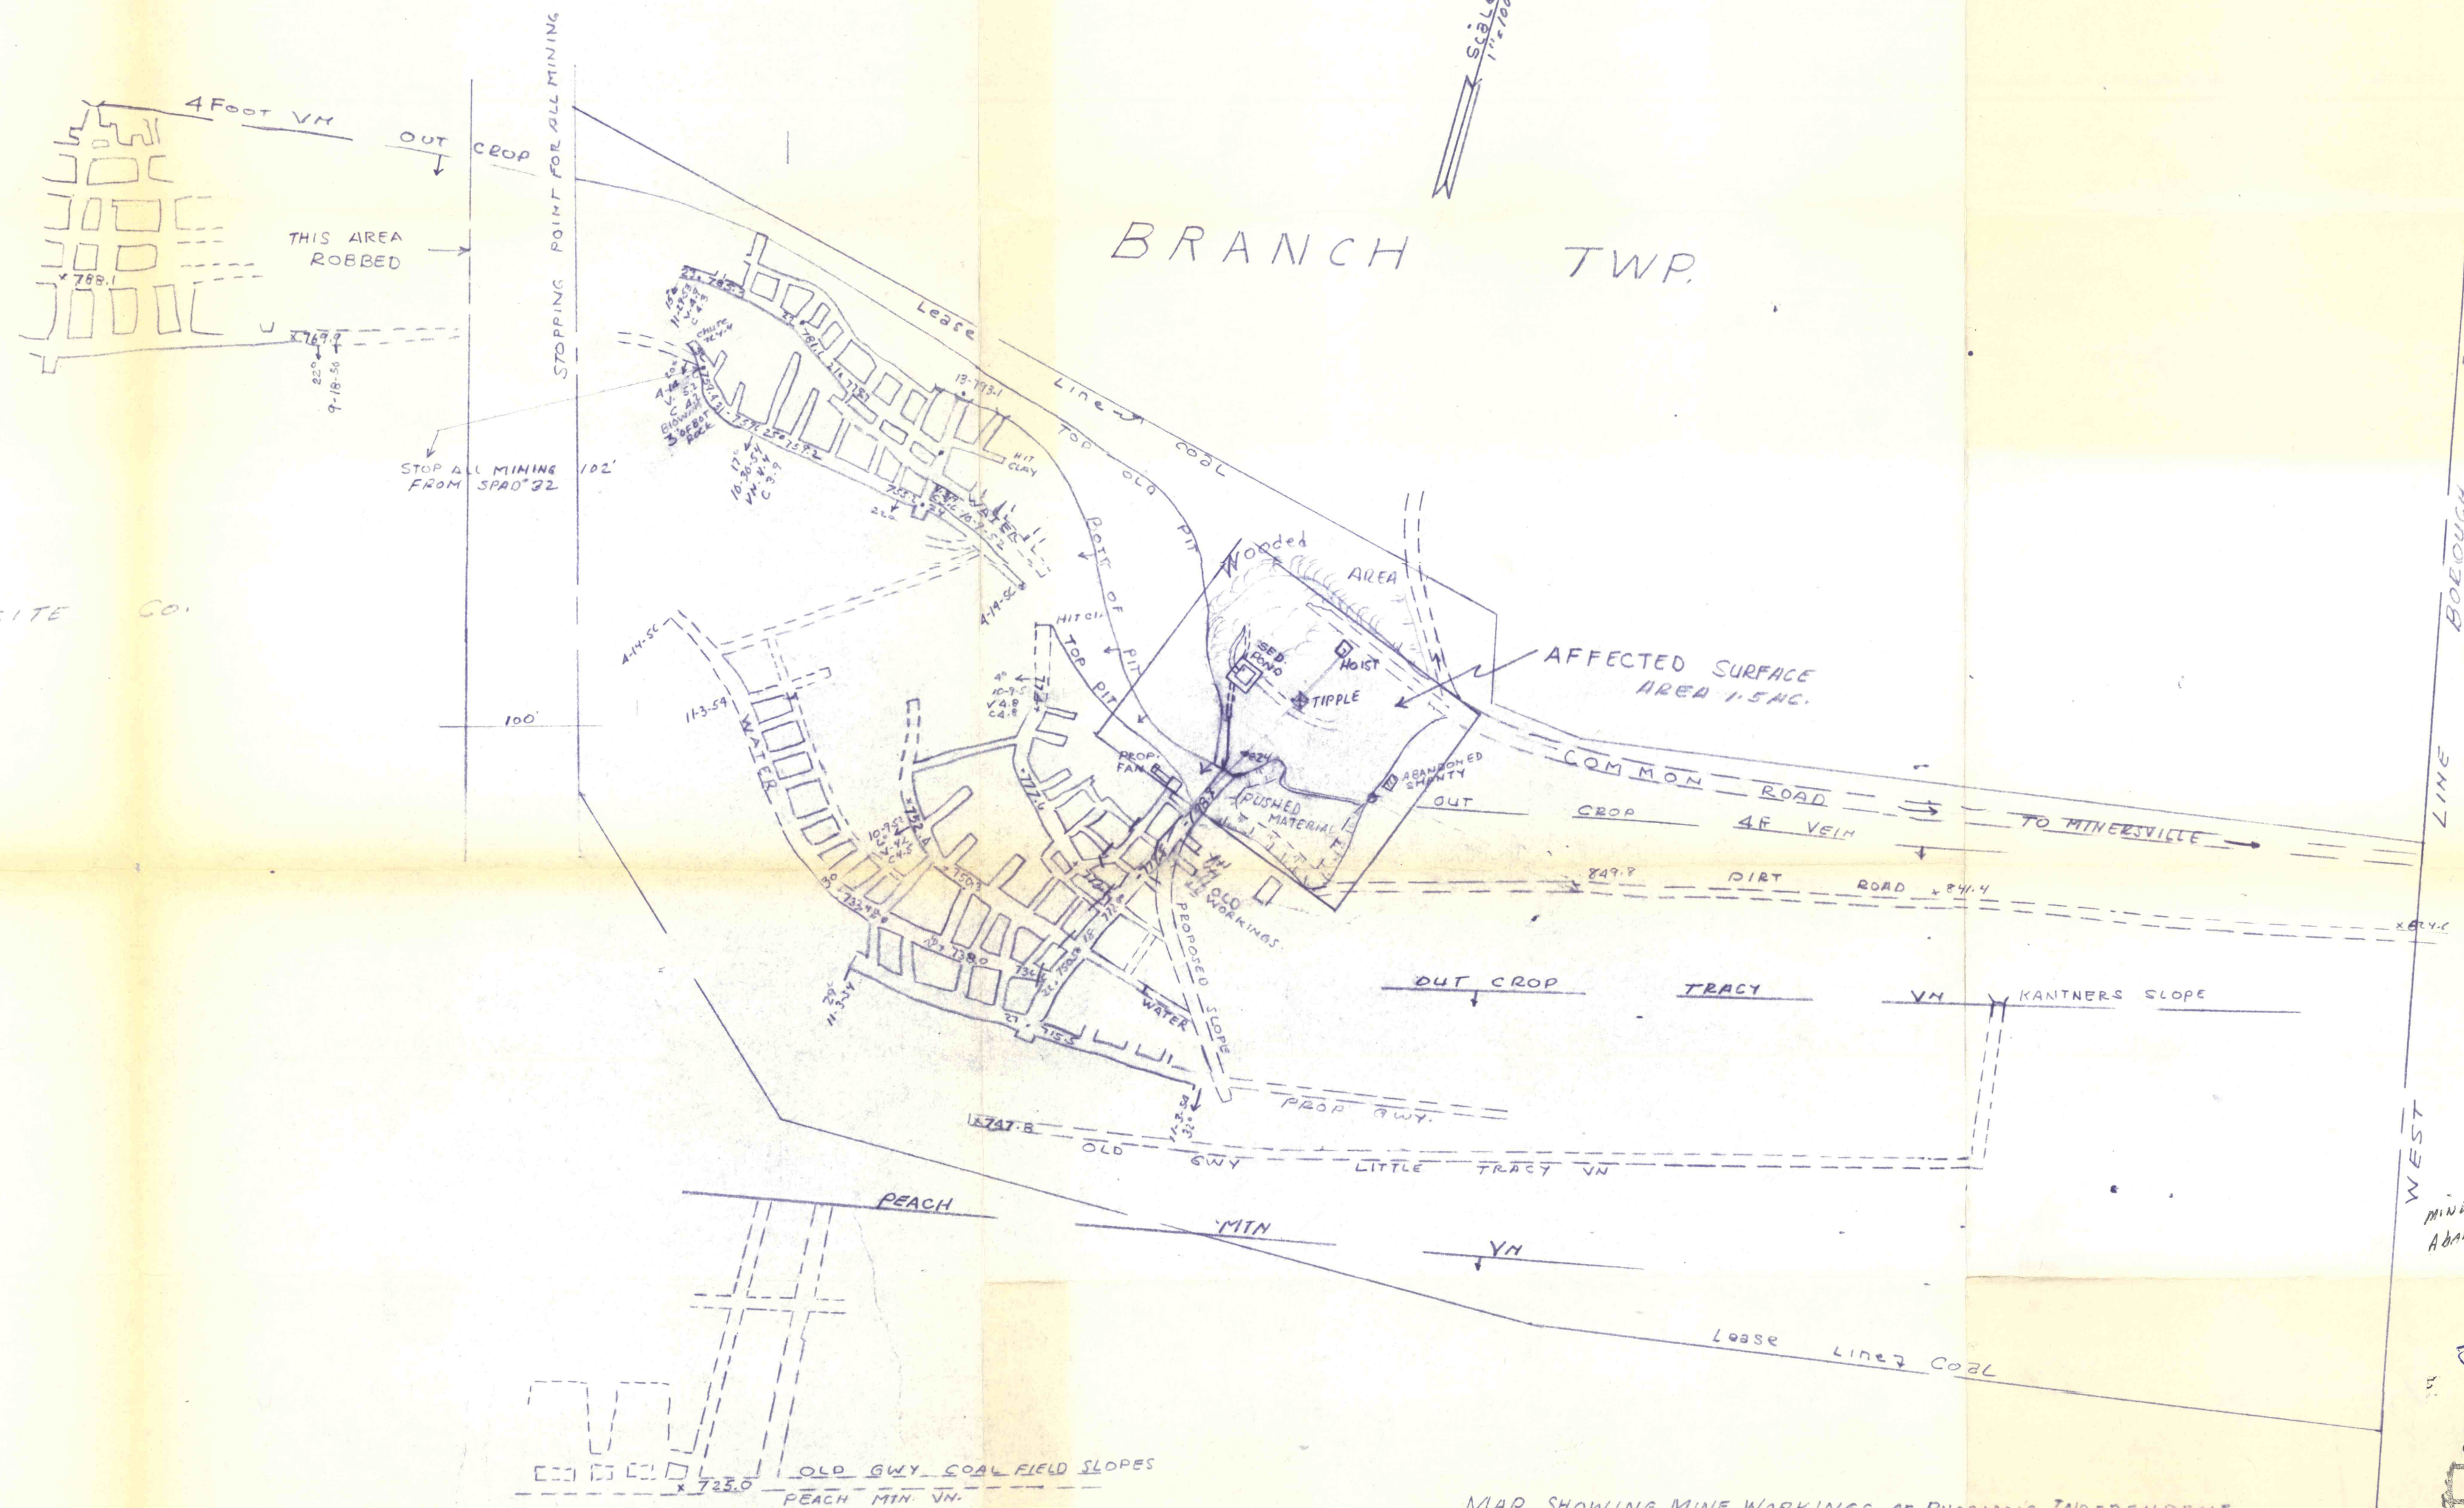

MAP SHOWING MINE WORKINGS OF RUSSIAN'S INDEPENDENT  
MINE- NOW LEASED BY L & P. COAL COMPANY  
BRANCH TOWNSHIP, SCHUYLKILL COUNTY, PA

MINE DEVELOPMENT MAP  
ID-36-07452  
4 foot slope

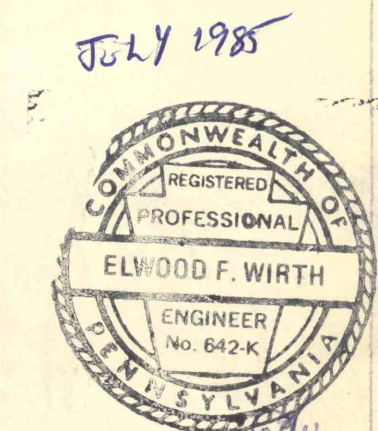

DWG. No. 1