


SECTION A-A  
1" = 100'  
DATUM - 600

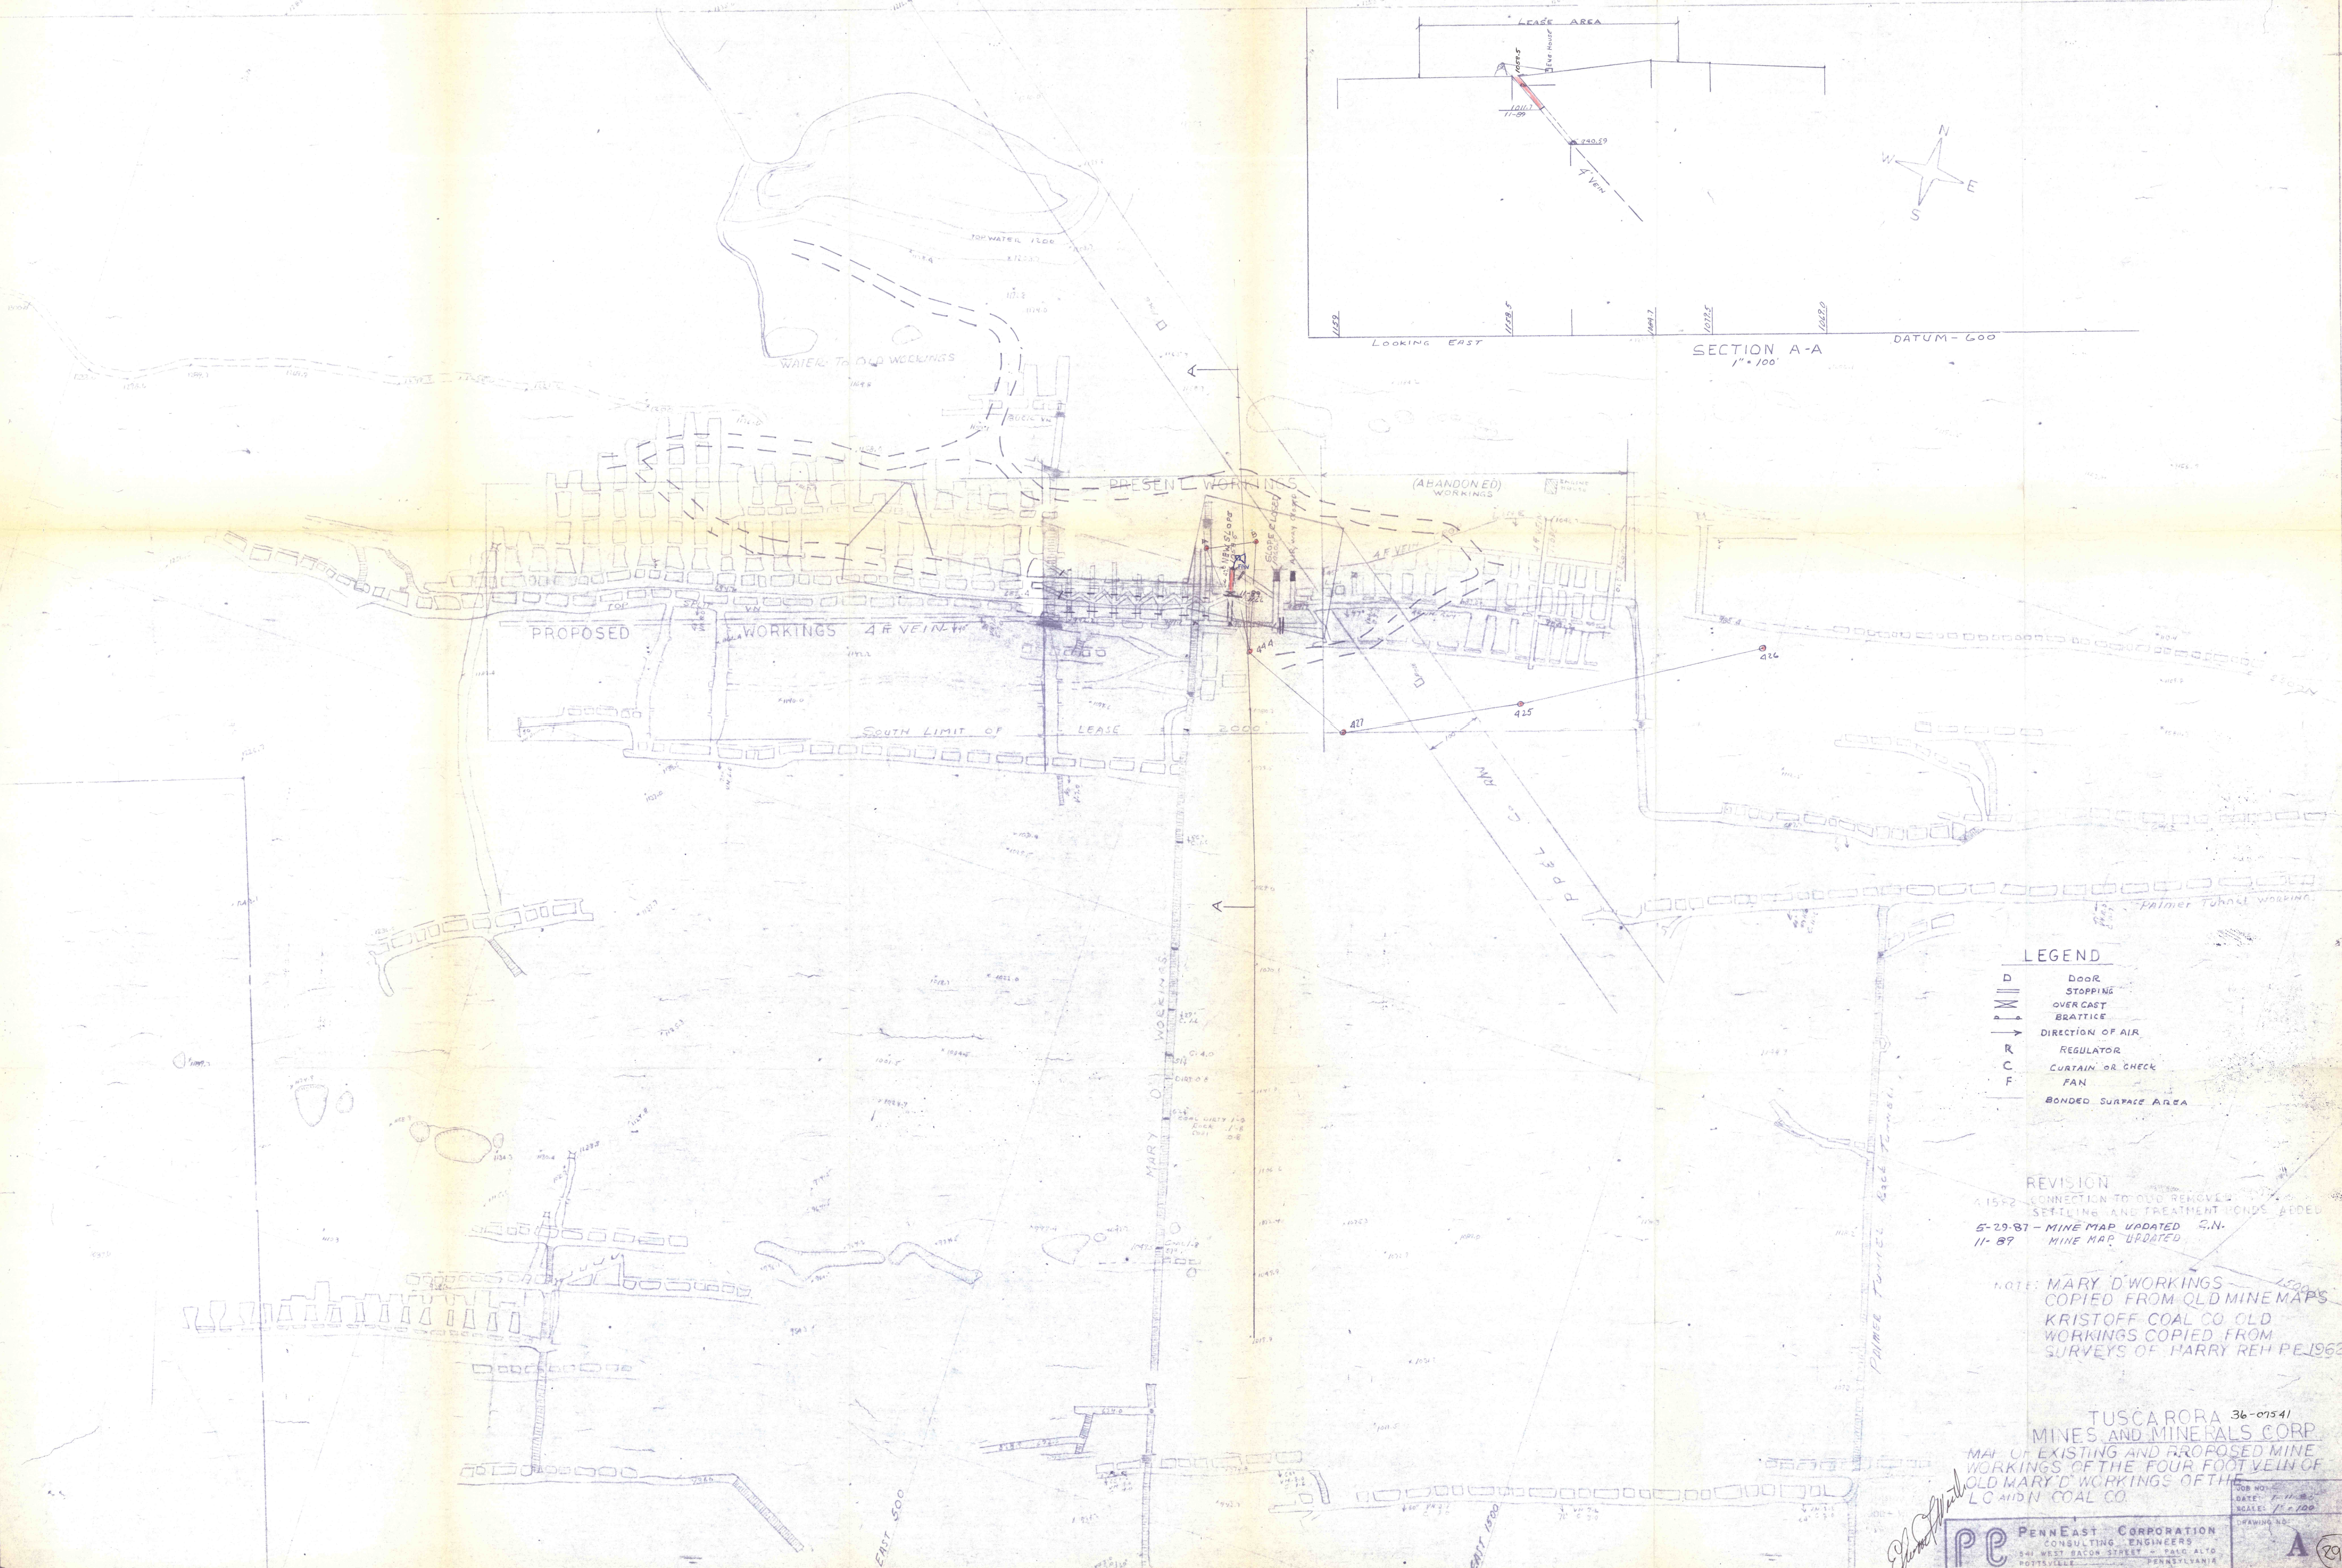

**LEGEND**

D	DOOR
—	STOPPING
—	OVERCAST
—	BRATTICE
→	DIRECTION OF AIR
R	REGULATOR
C	CURTAIN OR CHECK
F	FAN
—	BONDED SURFACE AREA

**REVISION**

4-15-82 CONNECTION TO OLD REMOVED  
SETTLING AND TREATMENT PONDS ADDED

5-29-87 - MINE MAP UPDATED S.N.

11-87 MINE MAP UPDATED

NOTE: MARY D WORKINGS  
COPIED FROM OLD MINE MAPS  
KRISTOFF COAL CO OLD  
WORKINGS COPIED FROM  
SURVEYS OF HARRY REH PE 1962

TUSCARORA 36-07541  
MINES AND MINERALS CORP.  
MAP OF EXISTING AND PROPOSED MINE  
WORKINGS OF THE FOUR FOOT VEIN OF  
OLD MARY D WORKINGS OF THE  
LC AND N COAL CO.

PE PENNEAST CORPORATION  
CONSULTING ENGINEERS  
241 WEST BACON STREET - PAID ALSO  
POITTSVILLE PENNSYLVANIA

DATE: 7-11-88  
SCALE: 1" = 100'  
DRAWING NO. A 294