


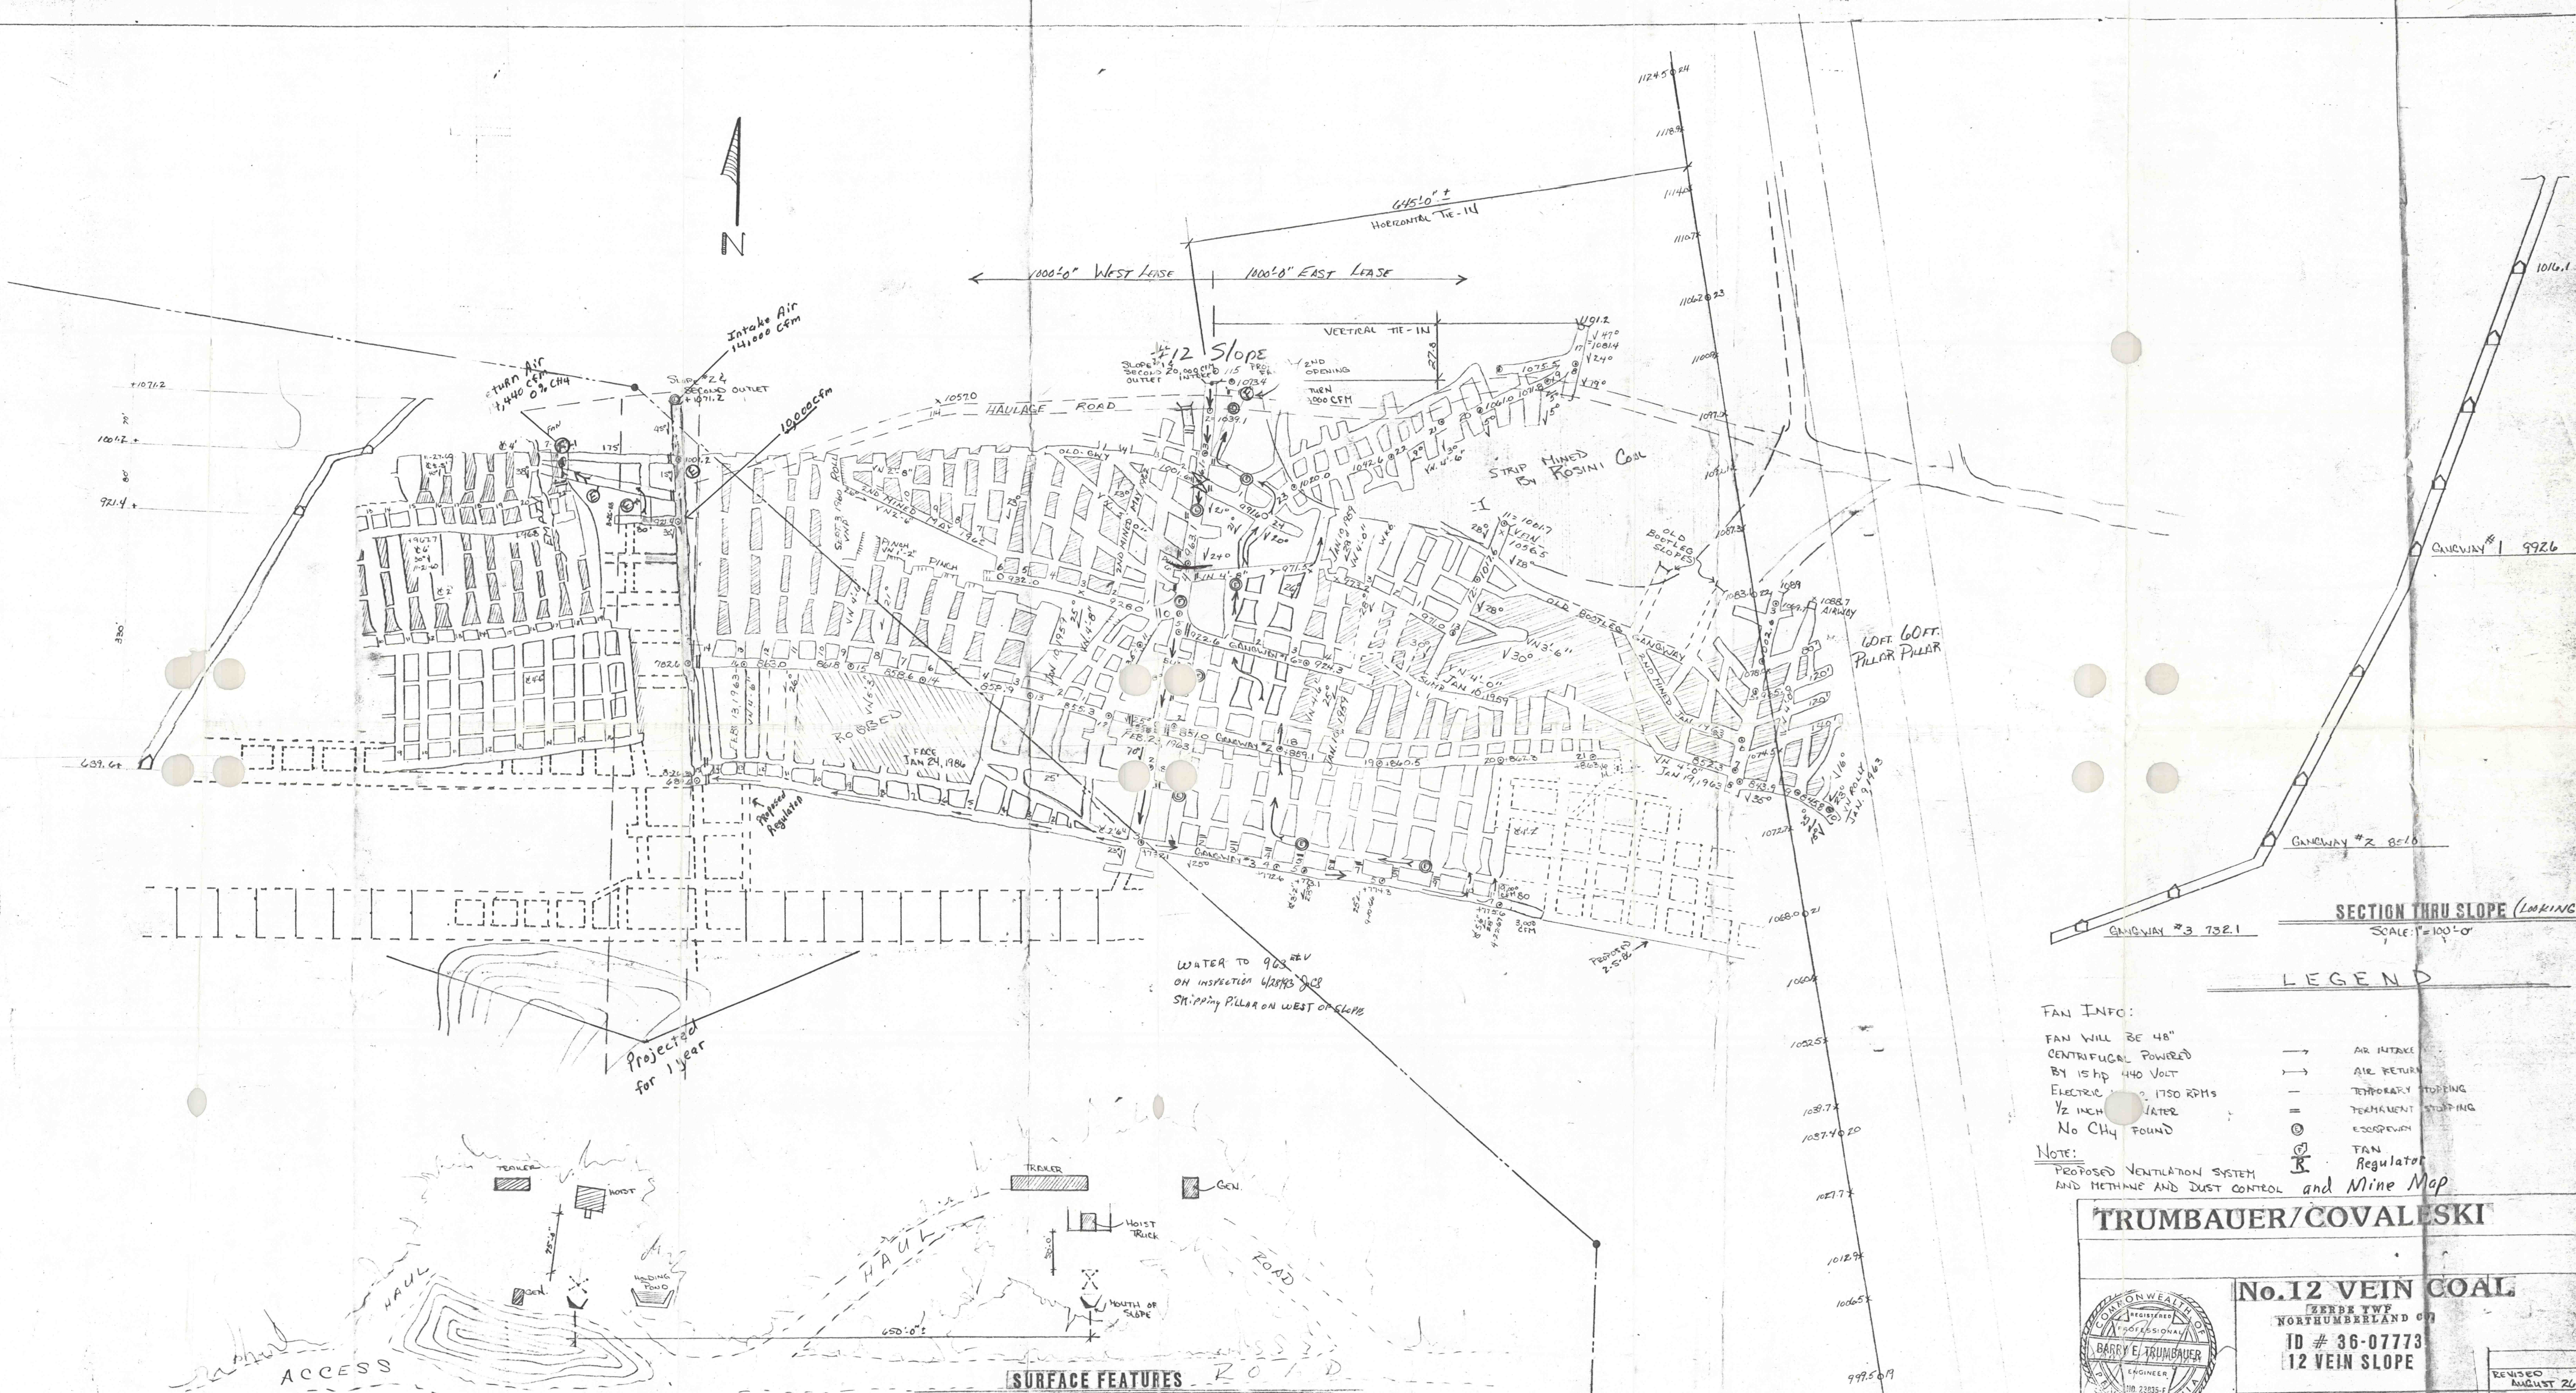

SECTION THRU SLOPE (LOOKING WEST)
 SCALE: 1"=100'-0"


LEGEND

FAN INFO:
 FAN WILL BE 48"
 CENTRIFUGAL POWERED
 BY 15 HP 440 VOLT
 ELECTRIC 1750 RPMs
 1/2 INCH WATER
 NO CH₄ FOUND

NOTE:
 PROPOSED VENTILATION SYSTEM
 AND METHANE AND DUST CONTROL and Mine Map

LEGEND:
 → AIR INTAKE
 ← AIR RETURN
 --- TEMPORARY STOPPING
 = PERMANENT STOPPING
 ⊙ ESCAPEMENT
 ⊙ FAN
 ⊙ Regulator

TRUMBAUER/COVALESKI

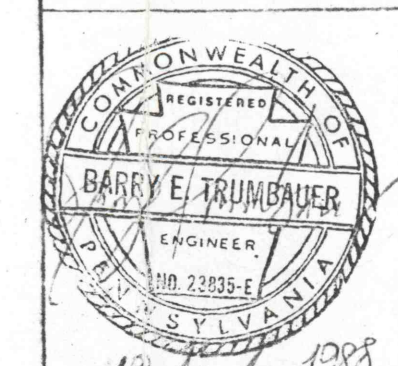

No. 12 VEIN COAL
 NORTHUMBERLAND CO
 ID # 36-07773
 12 VEIN SLOPE

REVISED
 AUGUST 26

JULY 1

SCALE: 1"=100'-0"

OPERATION PLAN MAP for NO. 12 VEIN COAL

SURFACE FEATURES
 SCALE: 1"=100'-0"