
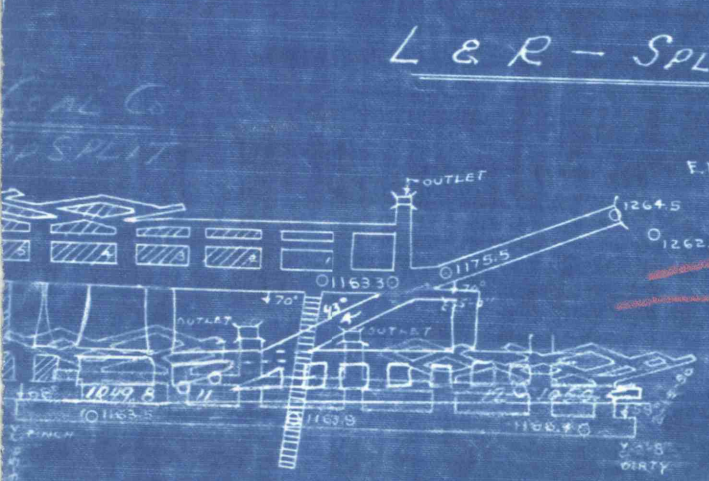


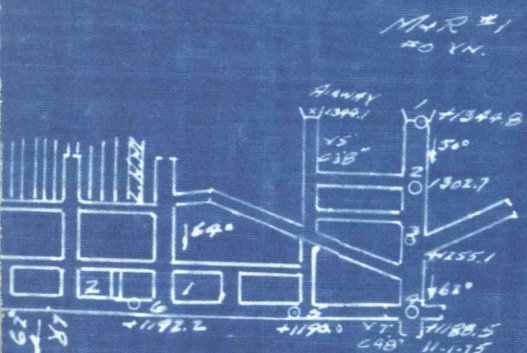

L & R - SPLIT VEIN COAL CO


ELWOOD SWANK MINE

TREVORTON ESTATE

ASSOCIATE LANDS

- INTAKE AIR
- EXHAUST AIR
- STOPPINGS
- POWER CABLE

LEASE 1000' LEASE 1000'

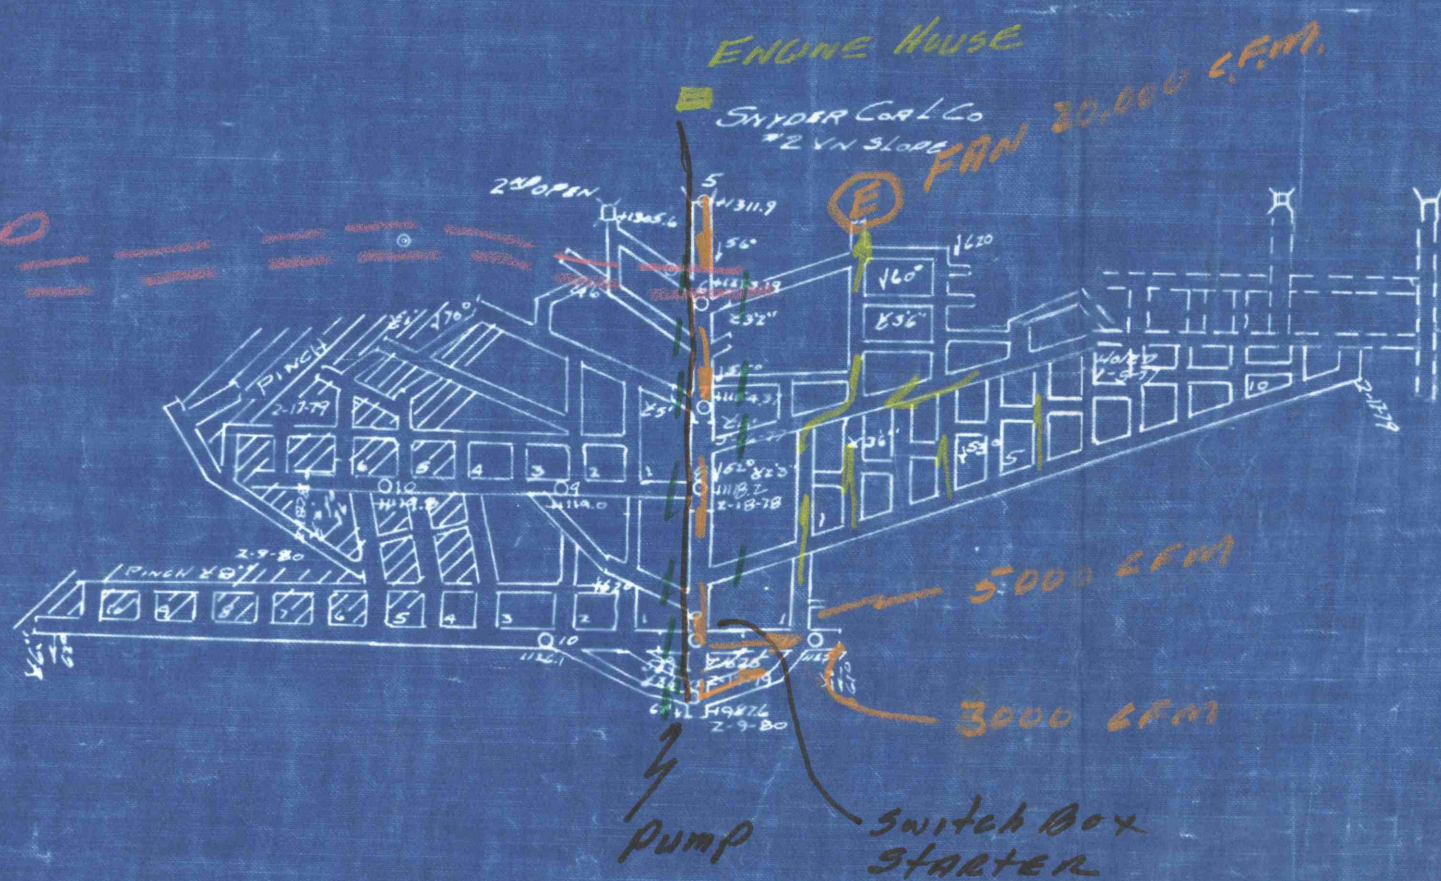

I.D. 36-06160
 SNYDER COAL COMPANY
 2 V IN 3100
 ZERBE TOWNSHIP
 NORTHUMBERLAND CO PA

1"=100' 2-9-80

