


MAR #1
20 YN.

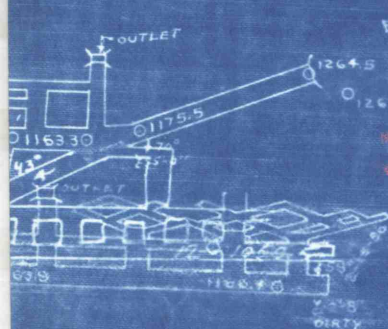


L & R - SPLIT VEIN COAL CO

TREVORTON ESTATE

ASSOCIATE LANDS

- Intake Air
- Exhaust Air
- Shipping
- Power Cable

LEASE 1000' LEASE 1000'

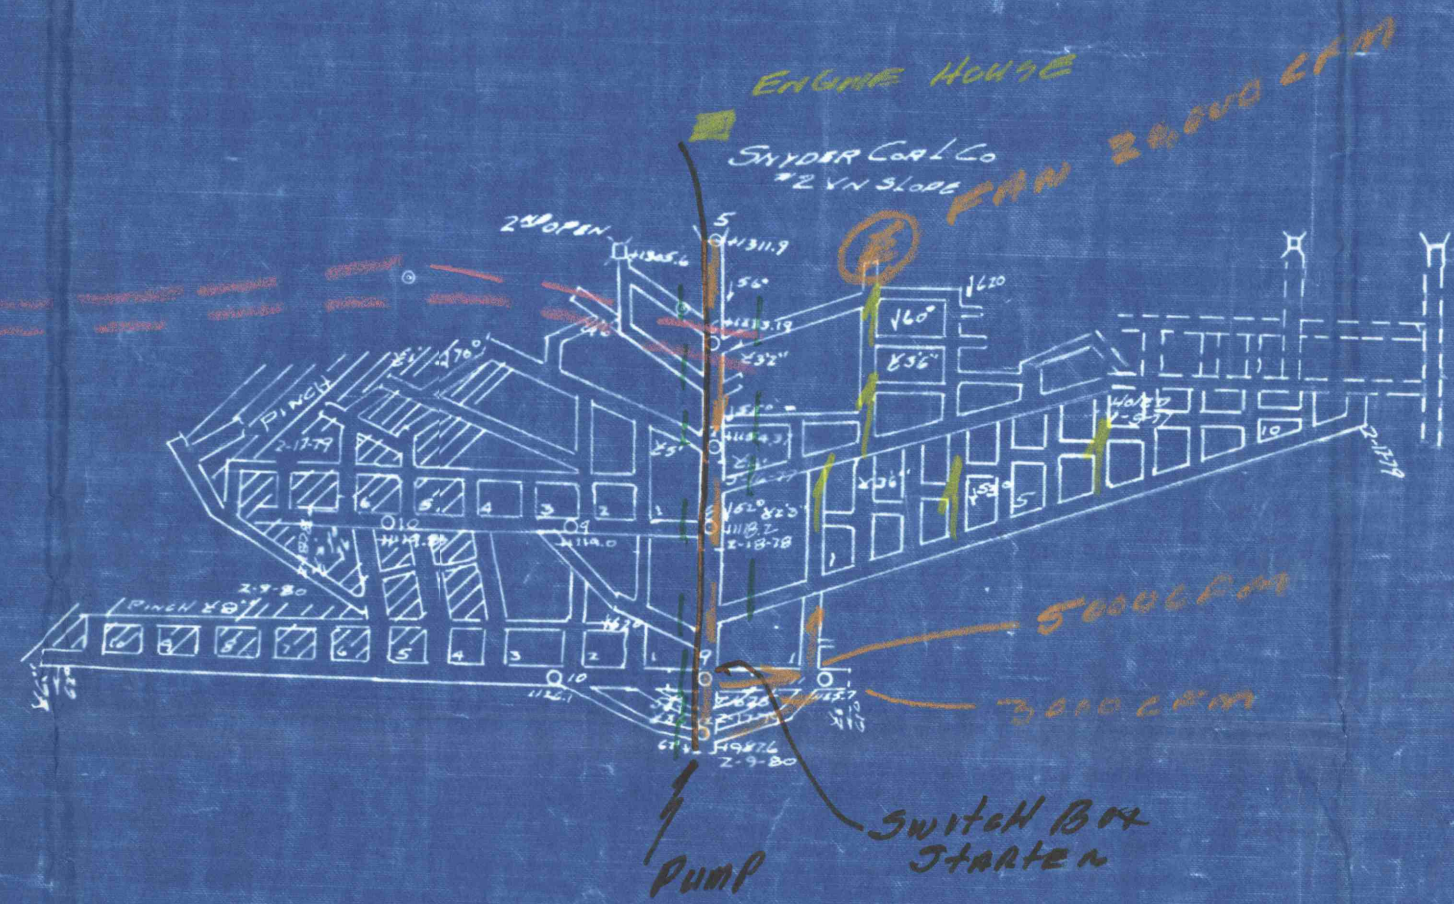

I.D. 36-06160
SNYDER COAL COMPANY
#2 VY SHAFT
ZERBOW TOWNSHIP
NORTHAMPTON CO PA

1"=100'

2-9-80

