


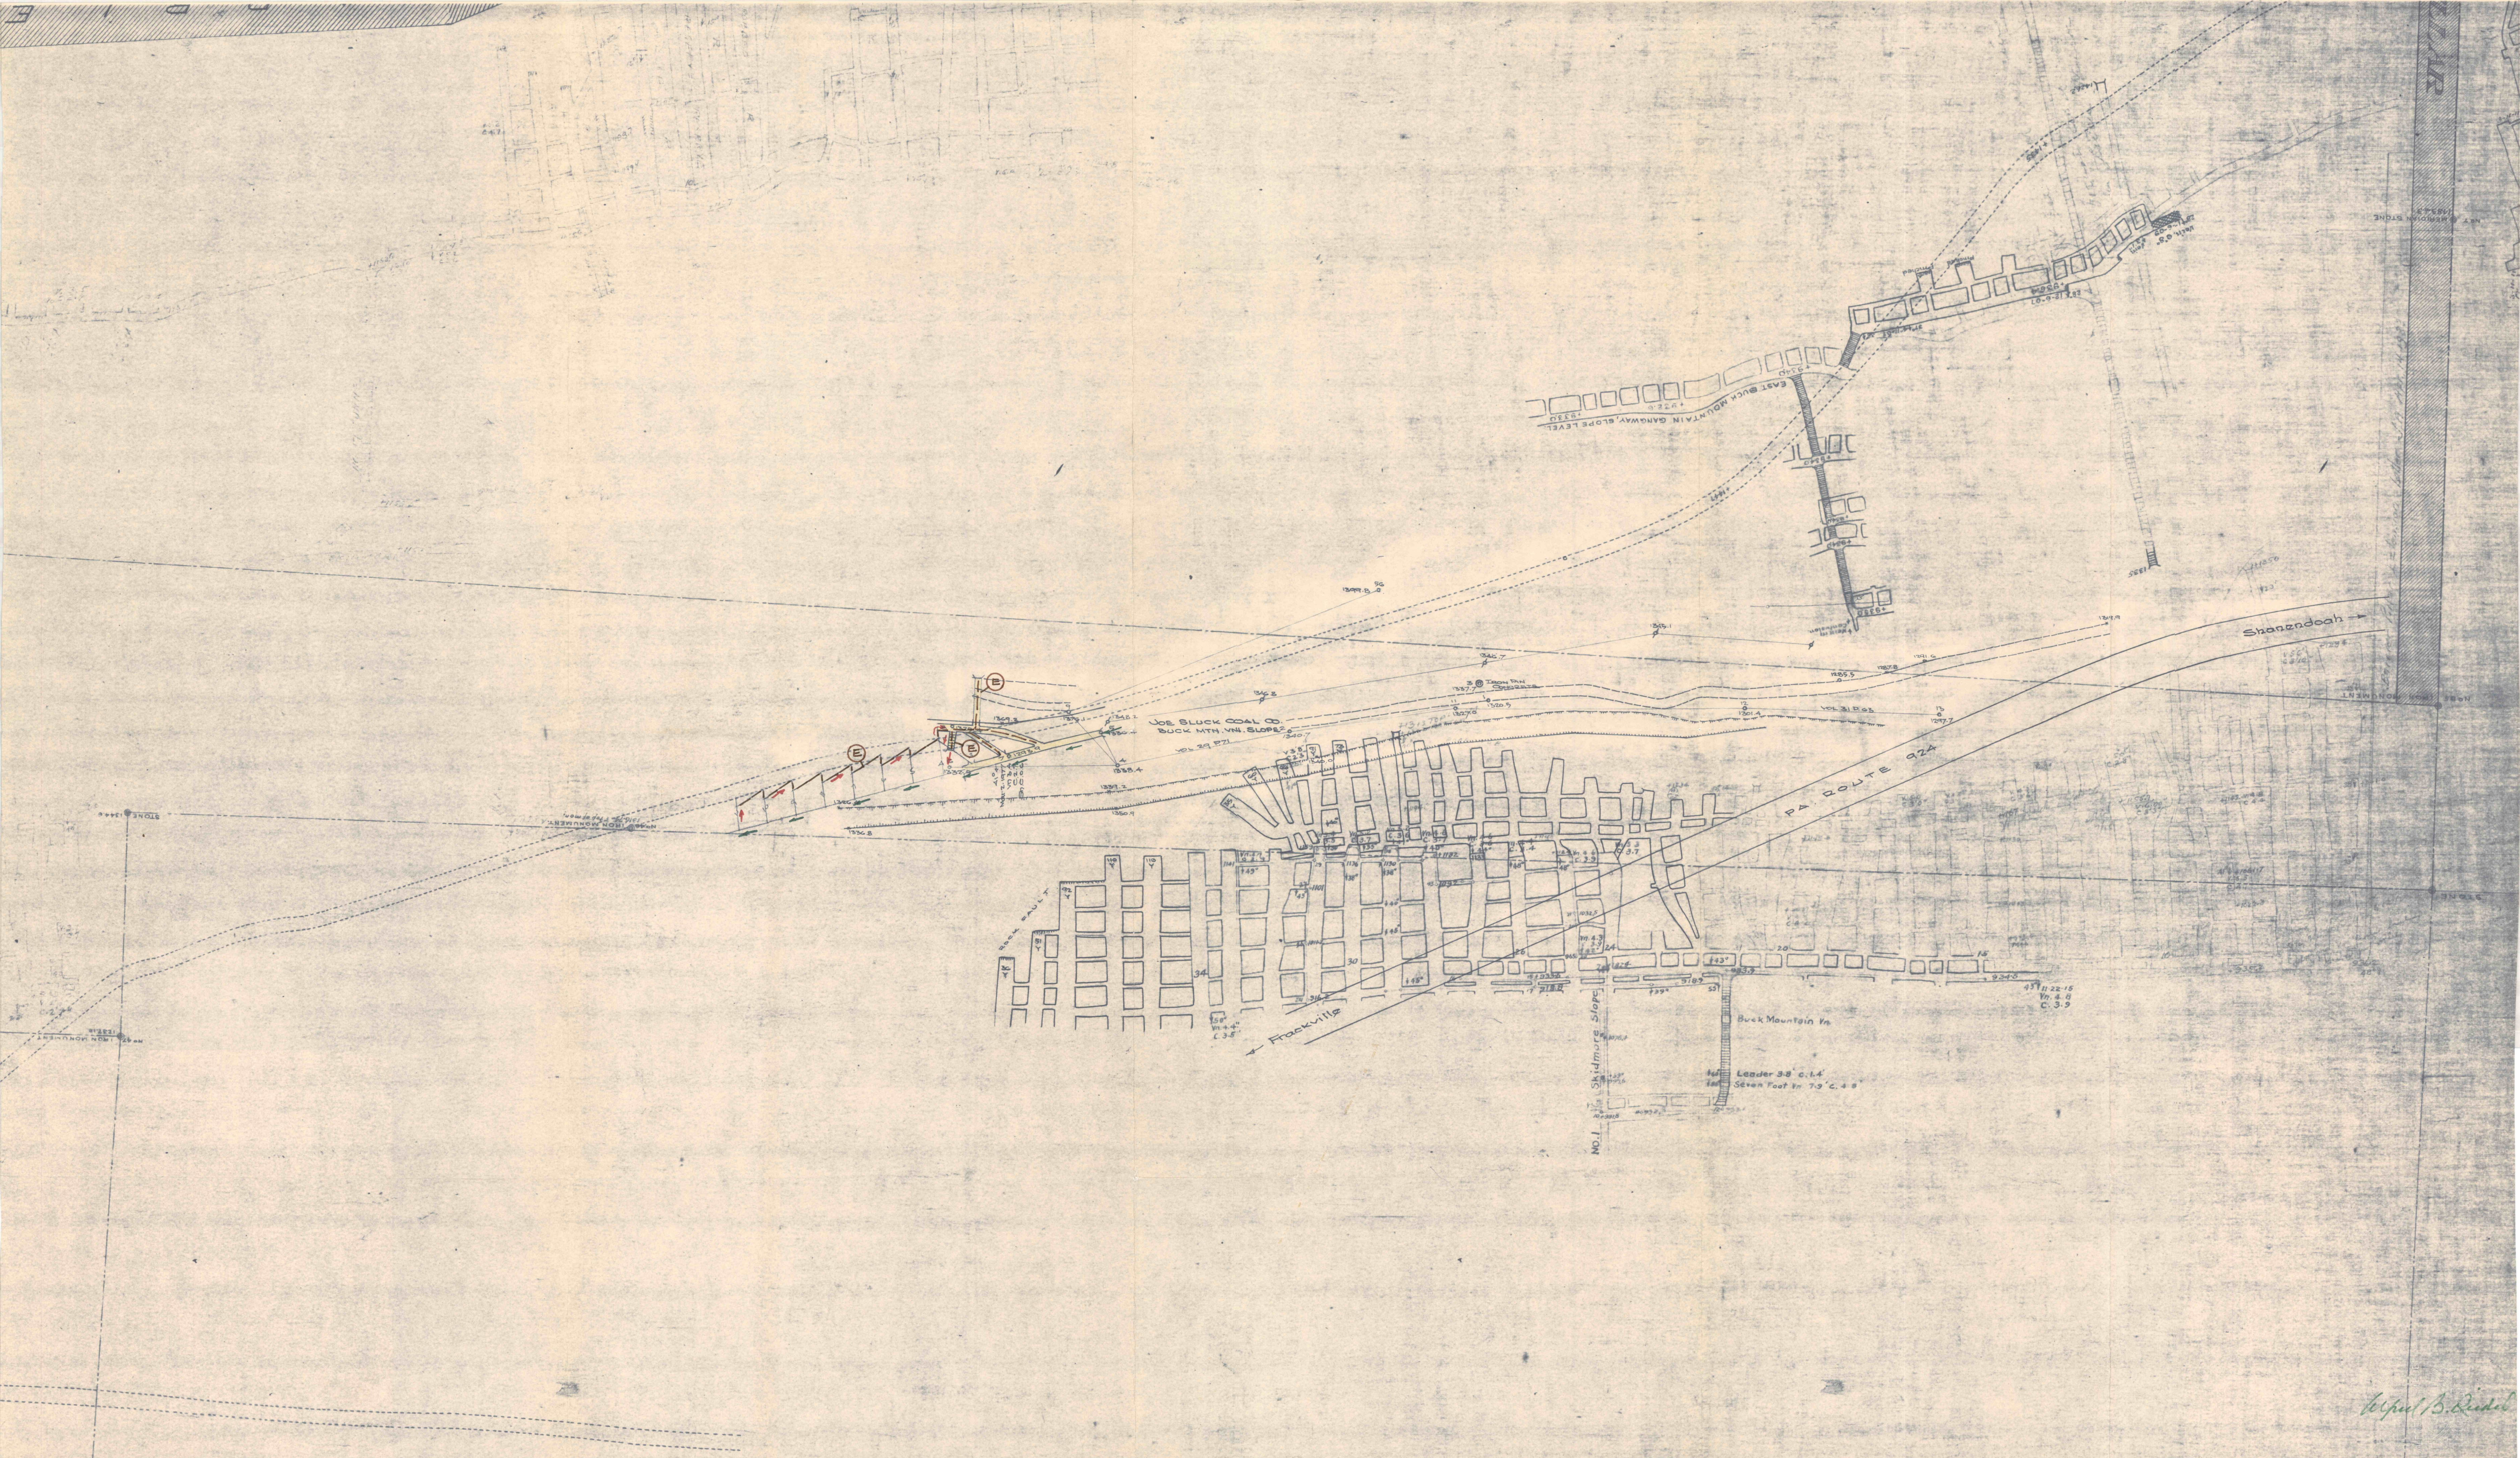

MINE MAP
 Showing the location and extent of development of the Joe Sluck Coal Co. Slope Mine. Situate on the So. dip Buck Mtn. Vein, West Mahanoy Twp., Schuylkill County, Pa.
 A.B. Riedel, P.E. March 2, 1977
 Scale 1"=100'