



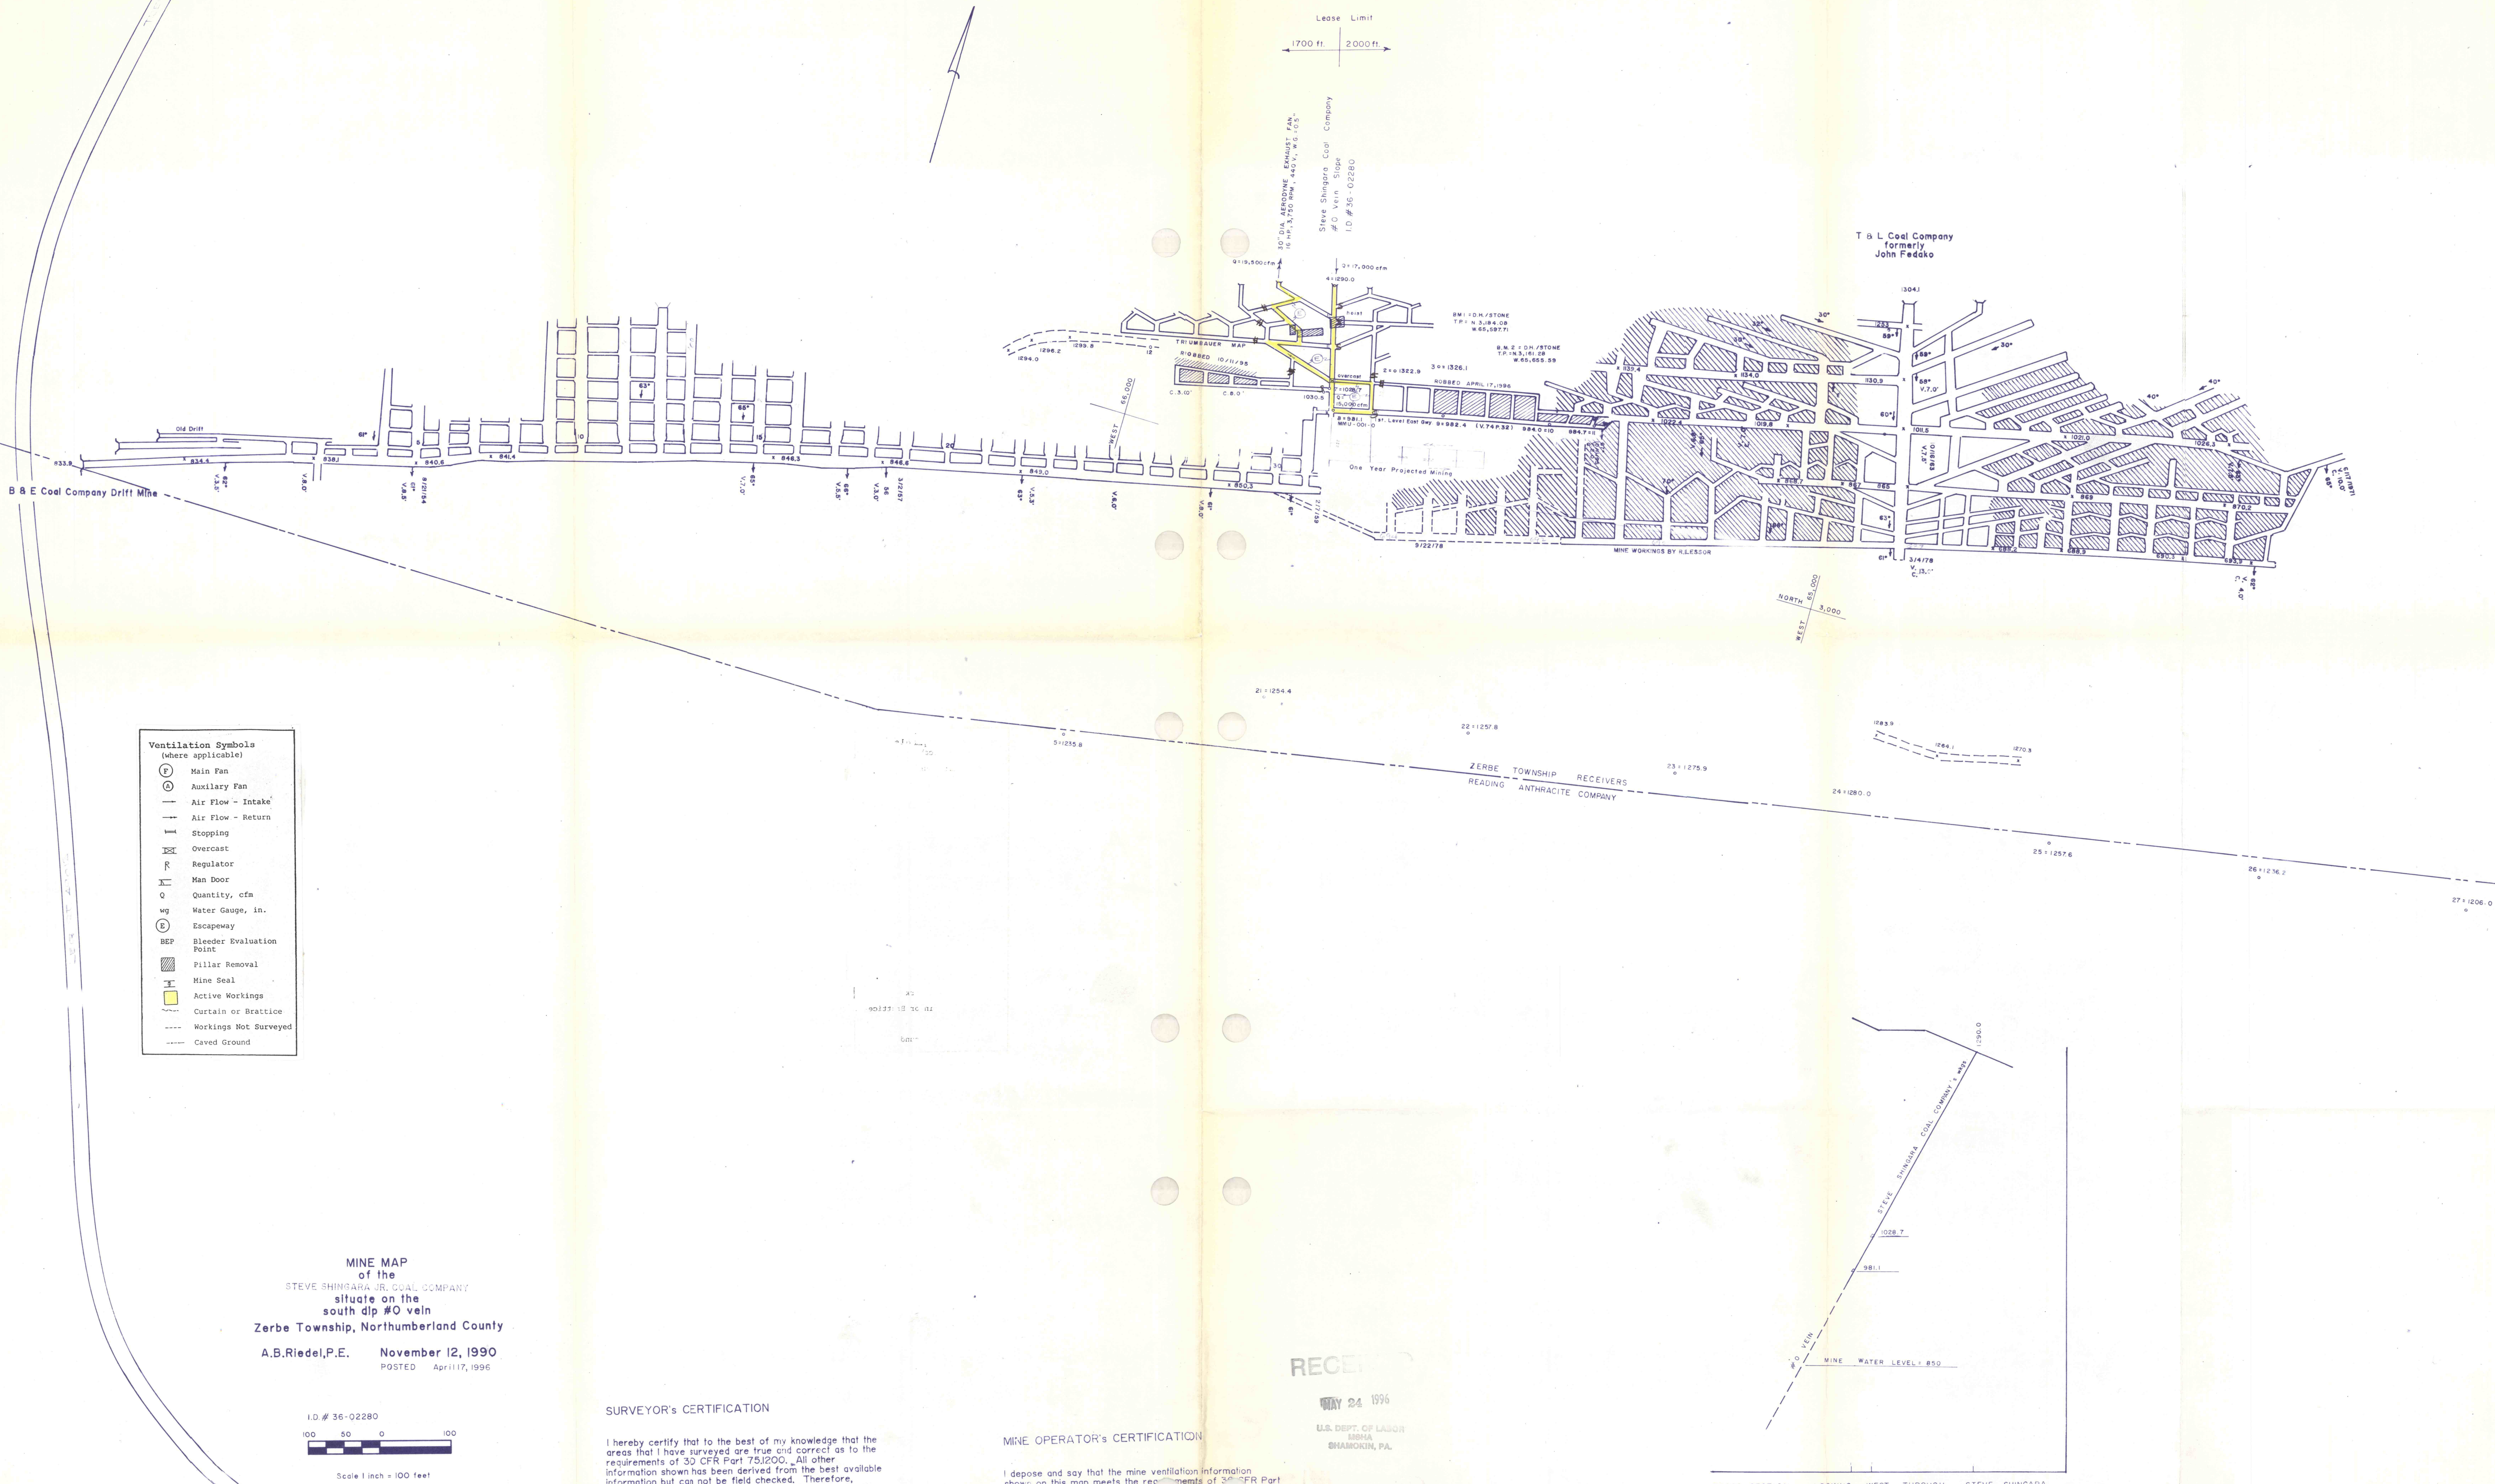

- Ventilation Symbols**
(where applicable)
- ⊕ Main Fan
 - ⊙ Auxiliary Fan
 - Air Flow - Intake
 - ← Air Flow - Return
 - ⊥ Stopping
 - ⊥ Overcast
 - ⊥ Regulator
 - ⊥ Man Door
 - Q Quantity, cfm
 - wg Water Gauge, in.
 - ⊕ Escapeway
 - BEP Bleeder Evaluation Point
 - ▨ Pillar Removal
 - ⊥ Mine Seal
 - ▨ Active Workings
 - ▨ Curtain or Brattice
 - Workings Not Surveyed
 - Caved Ground

MINE MAP
of the
STEVE SHINGARA JR. COAL COMPANY
situate on the
south dip #0 vein
Zerbe Township, Northumberland County
A.B. Riedel, P.E. November 12, 1990
POSTED April 17, 1996

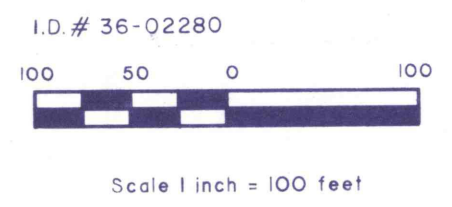

SURVEYOR'S CERTIFICATION


David L. Williams
Surveyor

MINE OPERATOR'S CERTIFICATION

I depose and say that the mine ventilation information shown on this map meets the requirements of 33 CFR Part 75.372 and was prepared by me or under my supervision for which I accept full responsibility.

Stephen Shingara
Mine Foreman

RECEIVED
MAY 24 1996
U.S. DEPT. OF LABOR
MSHA
SHAMOKIN, PA.

JUN 8 1996
U.S. DEPT. OF LABOR
MSHA
WILKES-BARRE, PA.

