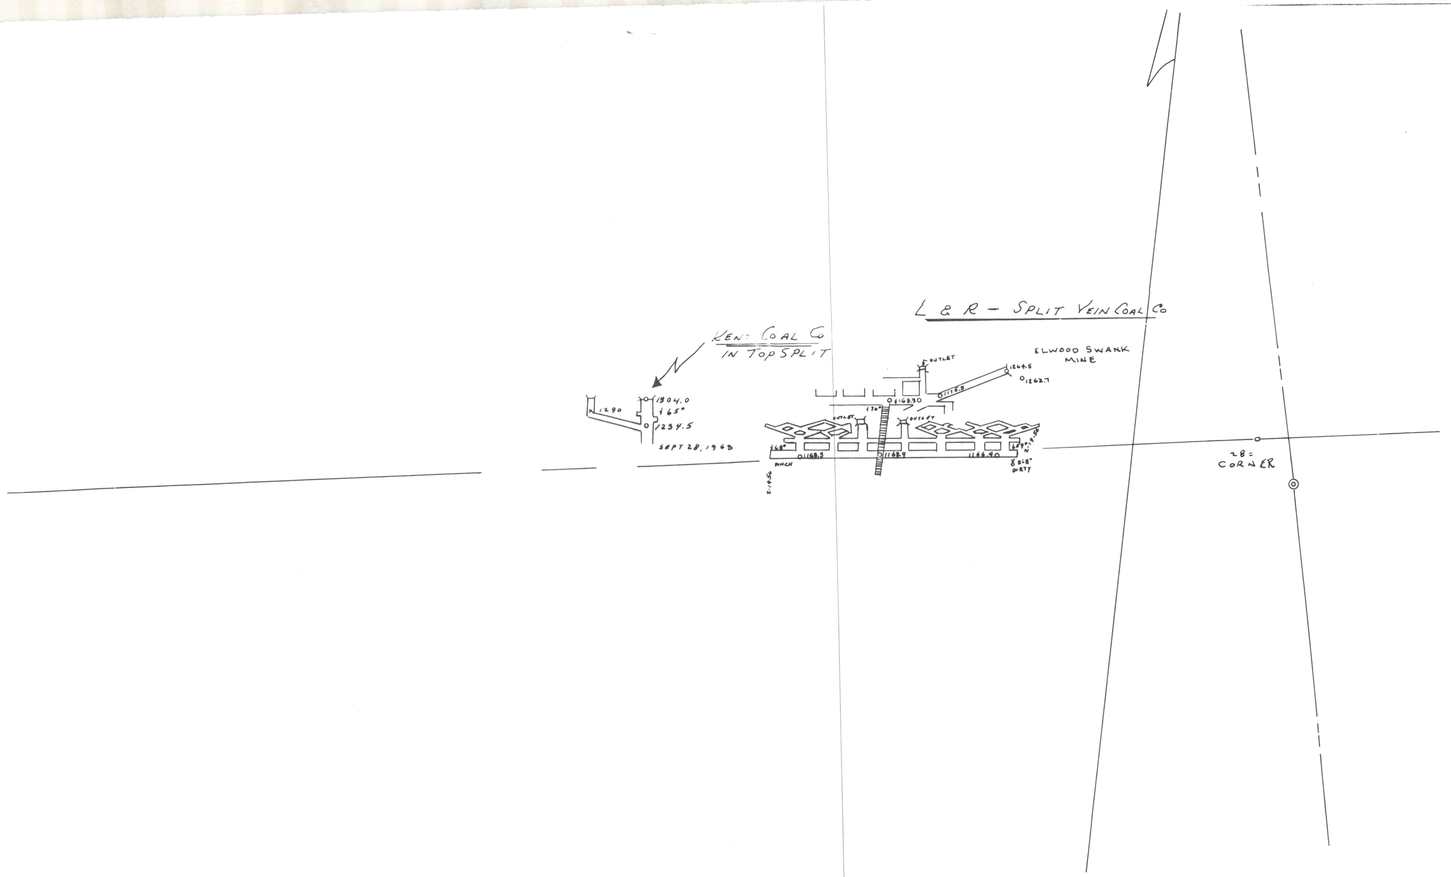

TRACED FROM PLAN
OF
NORTH FRANKLIN COLLIERY
VAINS #2, 3 & 5
SCALE: 1" = 100'
PLAN #5 OF 6