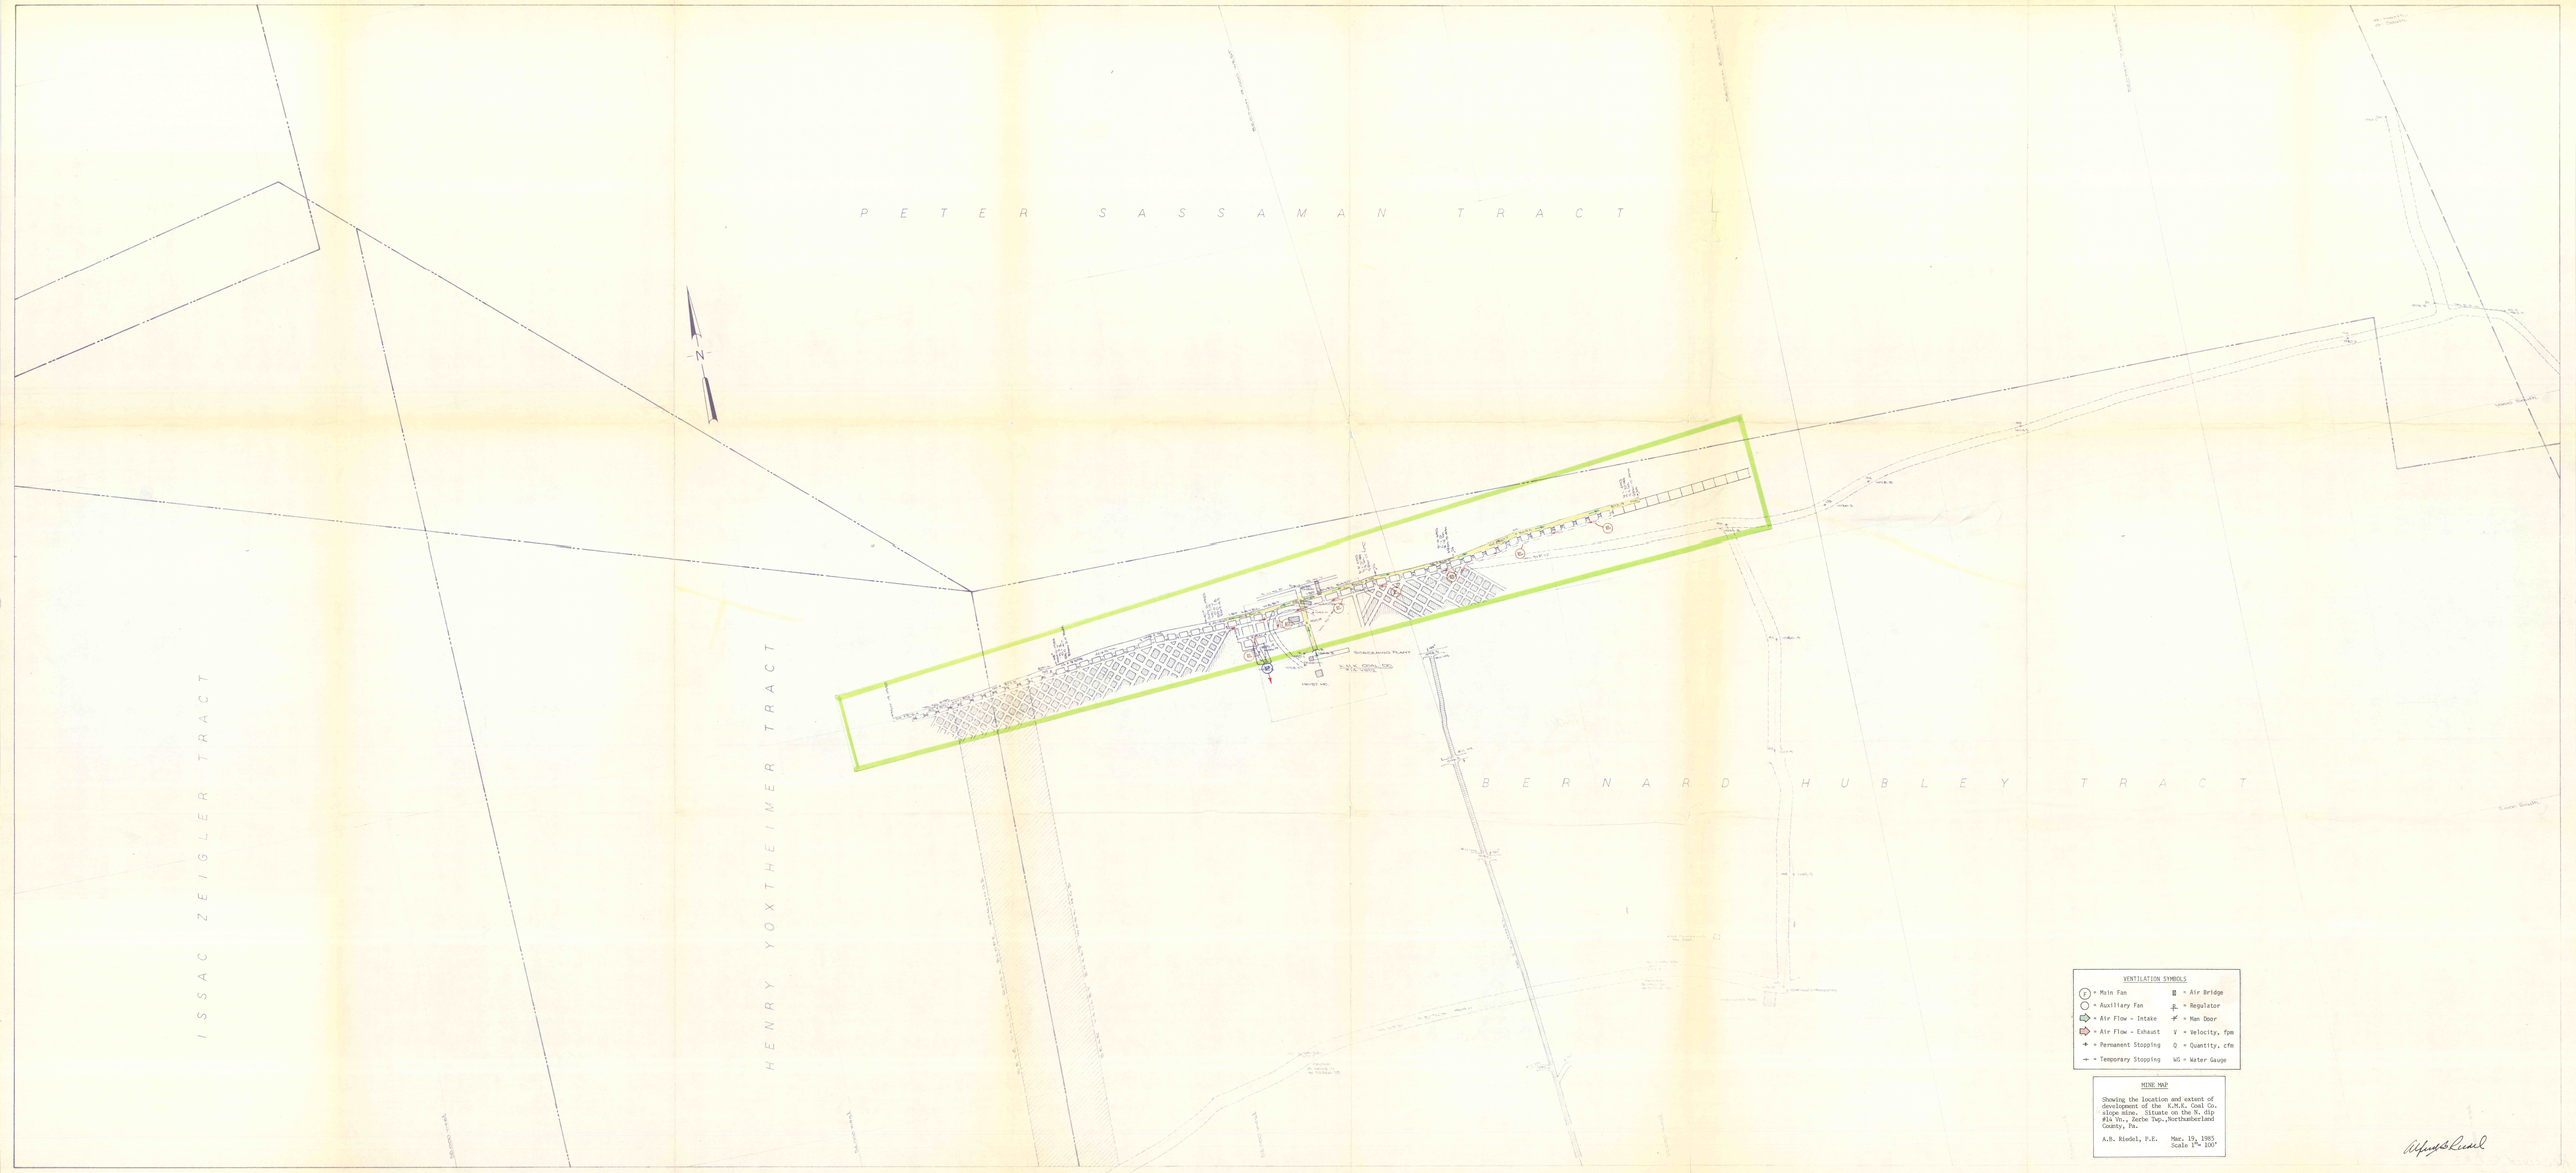
PETER SASSAMAN TRACT
N
ISSAC ZEIGLER TRACT
HENRY YOXTHEIMER TRACT
BERNARD HUBLEY TRACT
SCREENING PLANT
N.K. COAL CO.
PO. 1000'
VENTILATION SYMBOLS
= Main Fan
= Auxiliary Fan
= Air Flow - Intake
= Air Flow - Exhaust
= Permanent Stopping
= Temporary Stopping
= Air Bridge
= Regulator
= Man Door
V = Velocity, fpm
Q = Quantity, cfm
WG = Water Gauge
MINE MAP
Showing the location and extent of development of the N.M.A. Coal Co. slope mine. Situate on the N. dip #1& Vn., Zerbe Twp., Northumberland County, Pa.
A.B. Riedel, P.E.
Mar. 19, 1983
Scale 1"= 100'