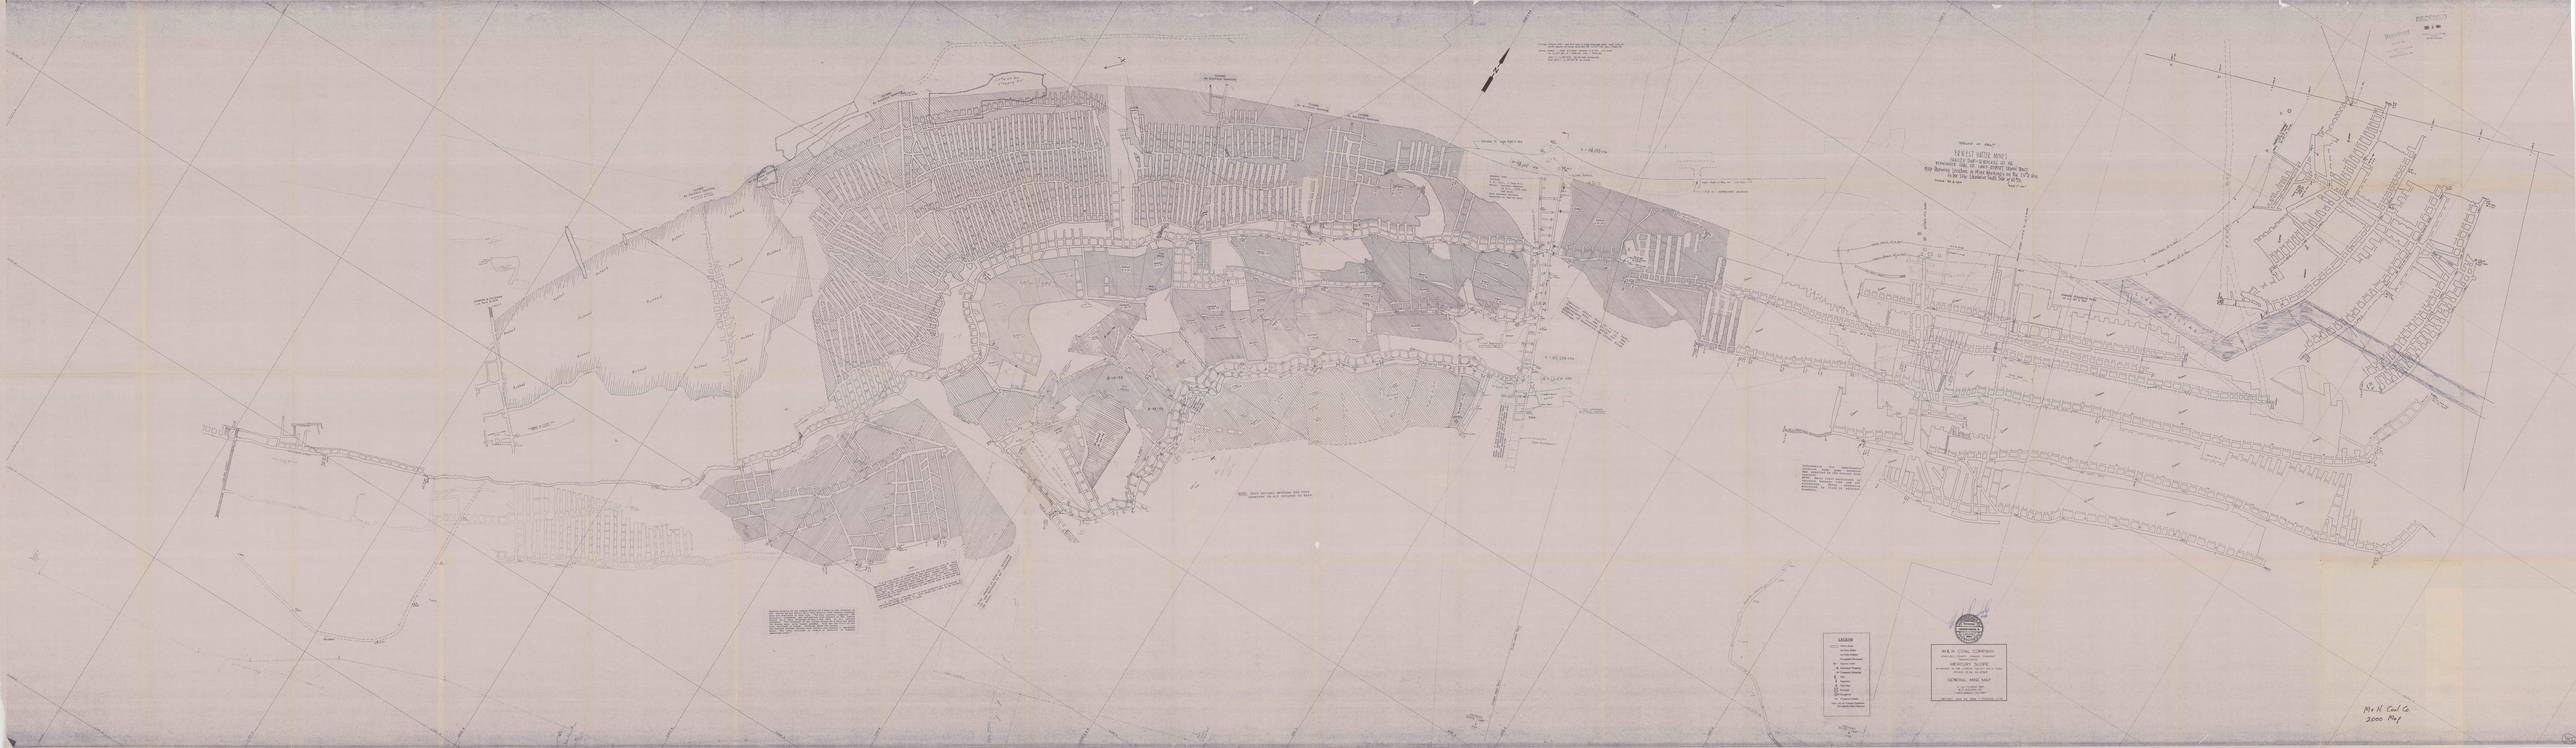
TRUE NORTH
GRID N
MAGNETIC NORTH
VARIES
TRUE NORTH
GRID N
MAGNETIC NORTH
VARIES
LEGEND
M & H COAL COMPANY
MERCURY SLOPE
GENERAL MINE MAP
M+H Coal Co.
2000 Map