

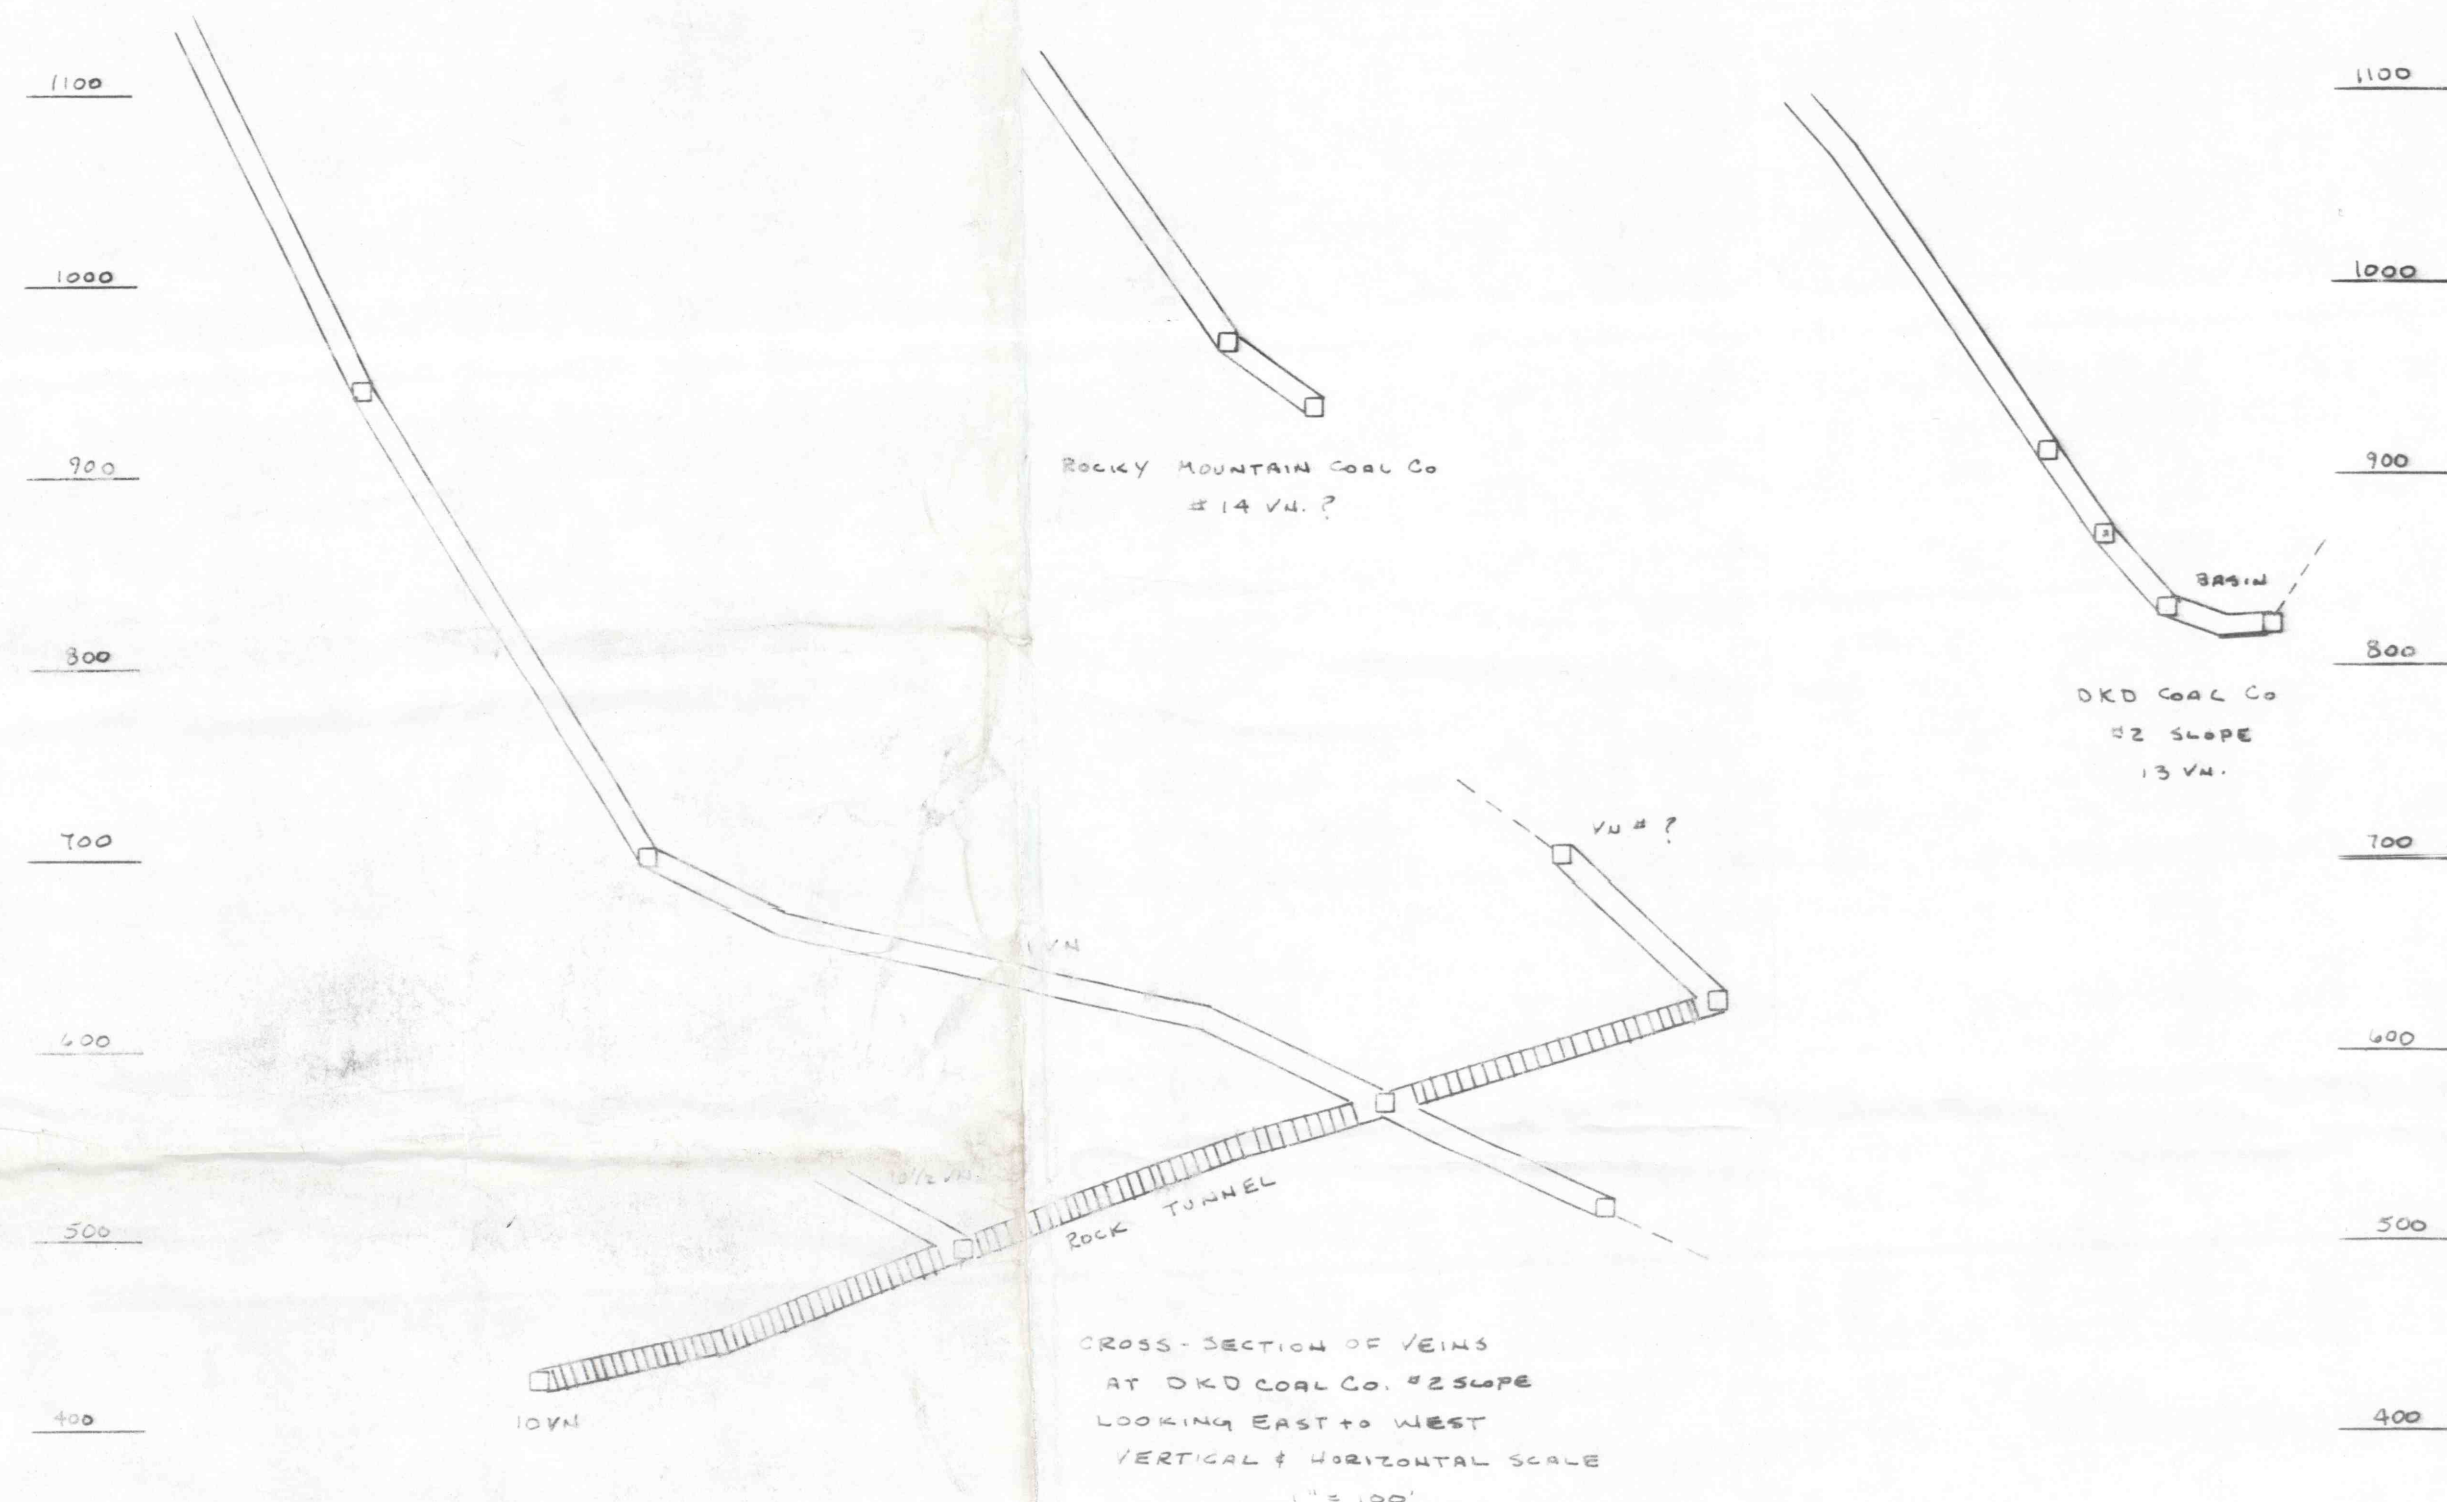
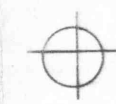
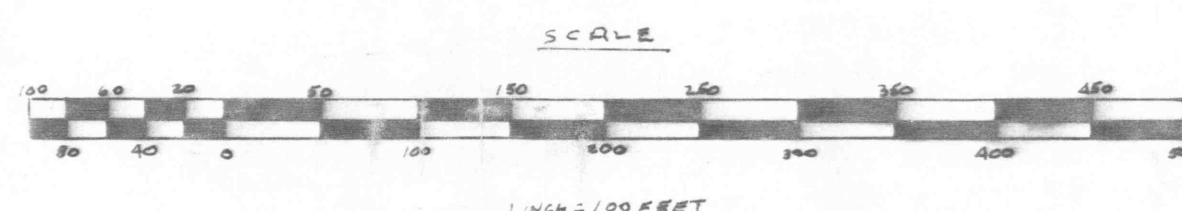


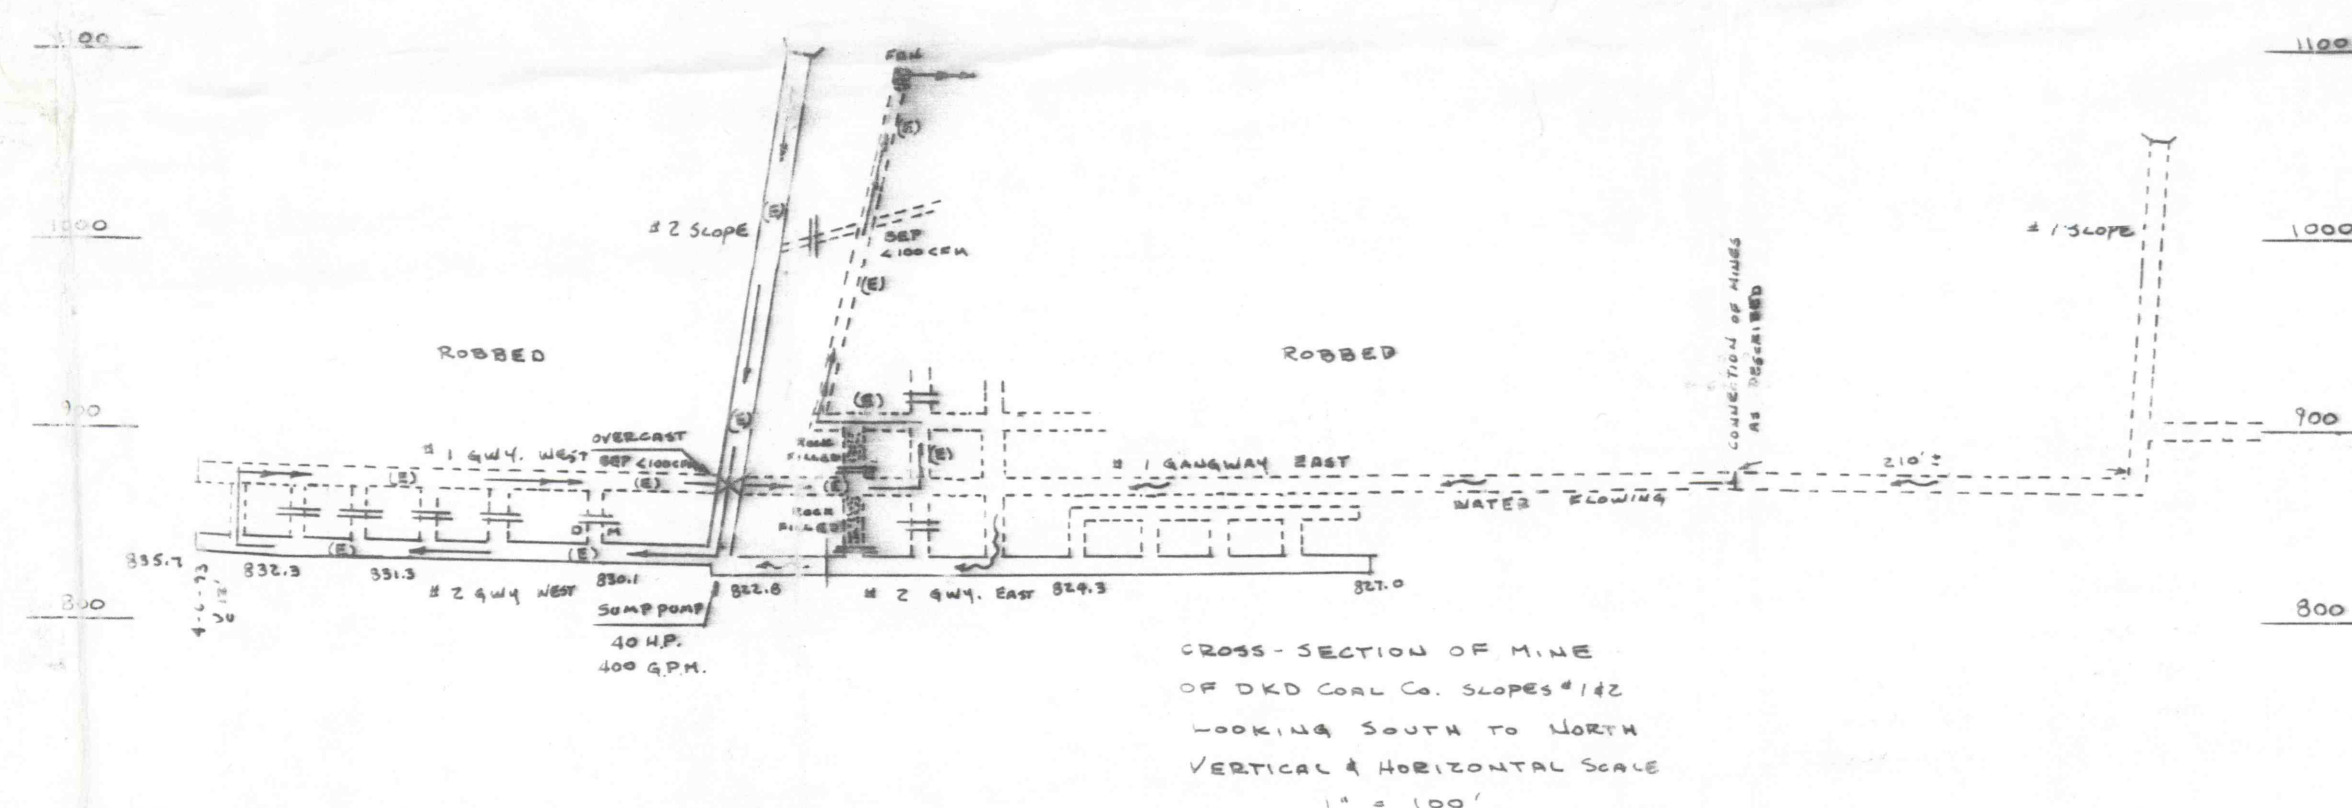

Z

SEE SPECIAL NOTES

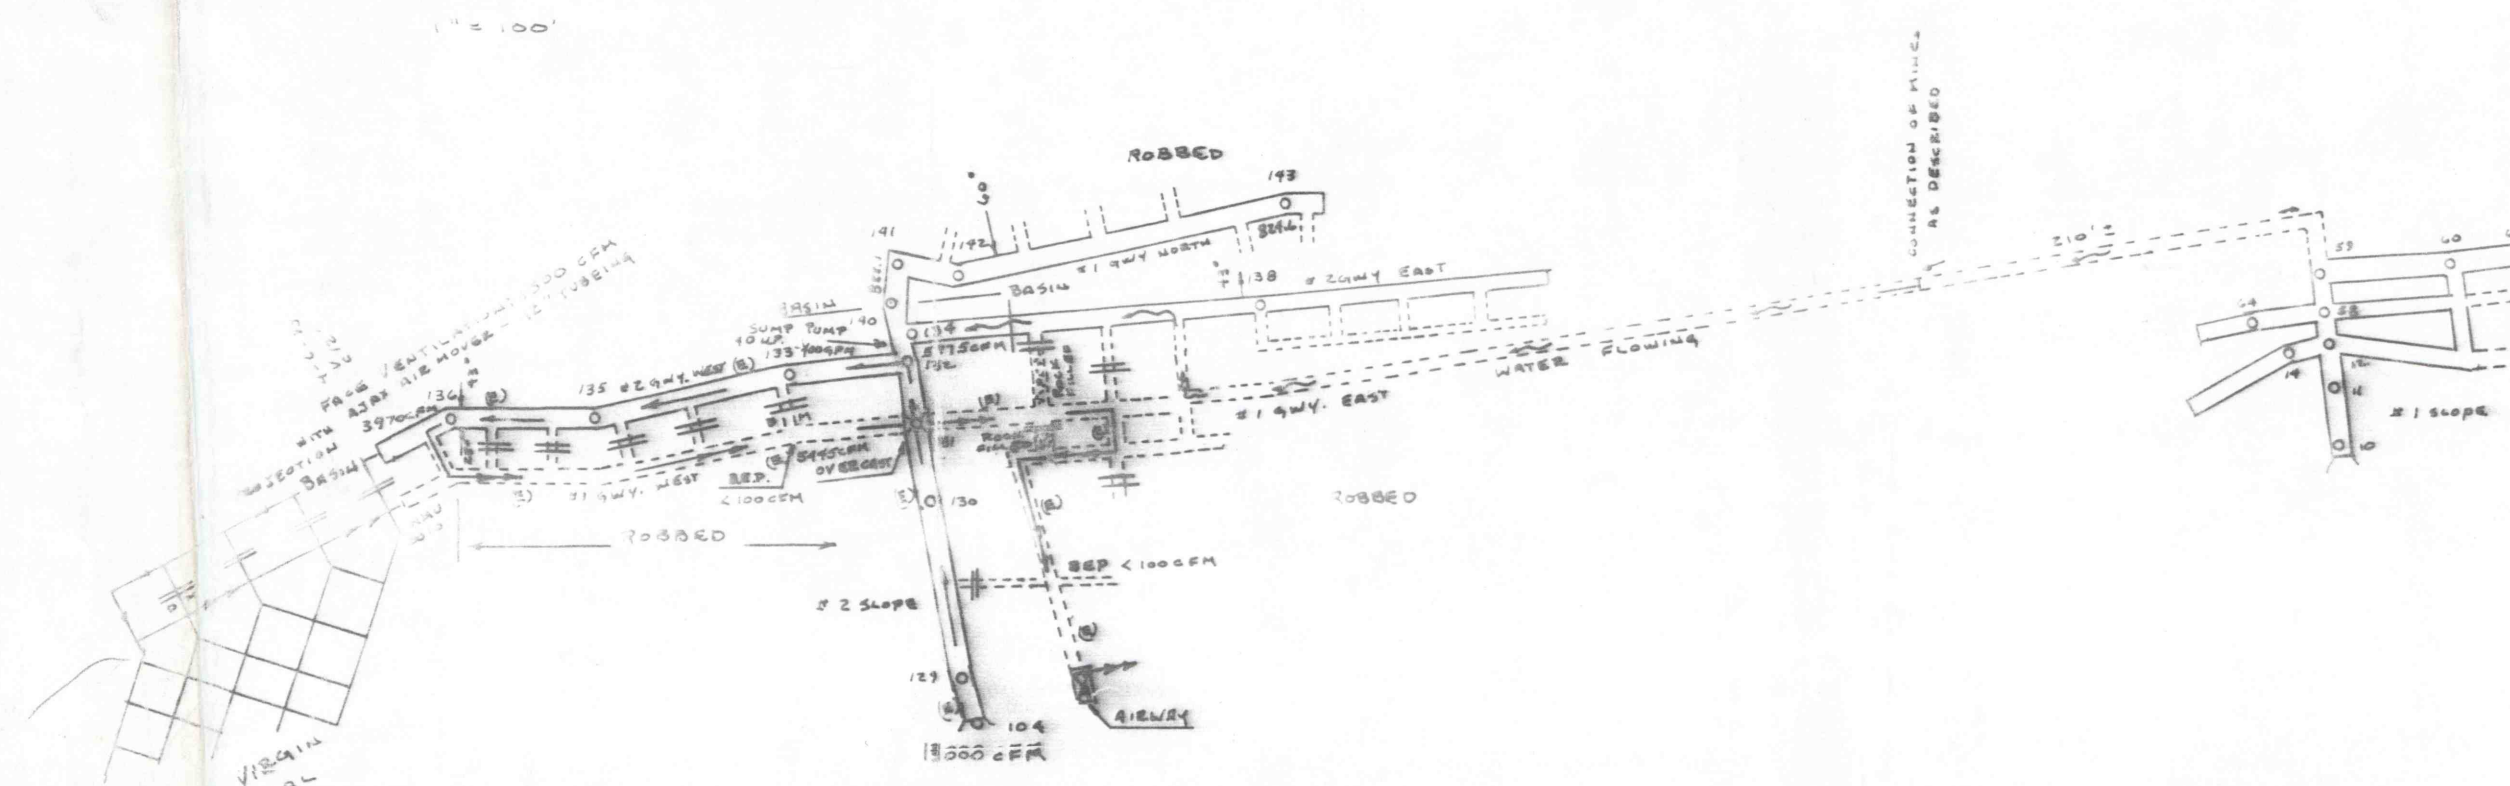

WILLIAM J. MESSING, P.L.S.
R.D. #1 BOX 1073
HERNDON, PA. 17033
(717) 758-9265
SU-28849-E

Walter James Messing

PLAN OF
MINE
AND
VENTILATION
FOR
D.K.D. COAL COMPANY
MSHA I.D. #34-08220
DER I.D. #49881304
715 MAHONEY STREET
TREVORTON, PA. 17881
(717) 777-3050
LOCATED IN
NO. 1 & 2 SLOPES
NO. 13 VEIN - NORTH DIP
BEAR VALLEY
TOWNSHIP OF ZERBY
COUNTY OF NORTHUMBERLAND
COMMONWEALTH OF PENNSYLVANIA
SCALE: AS NOTED
DATE: JUNE 1, 1993
FILE: D.K.D. COAL
PLAN: 2 OF 5