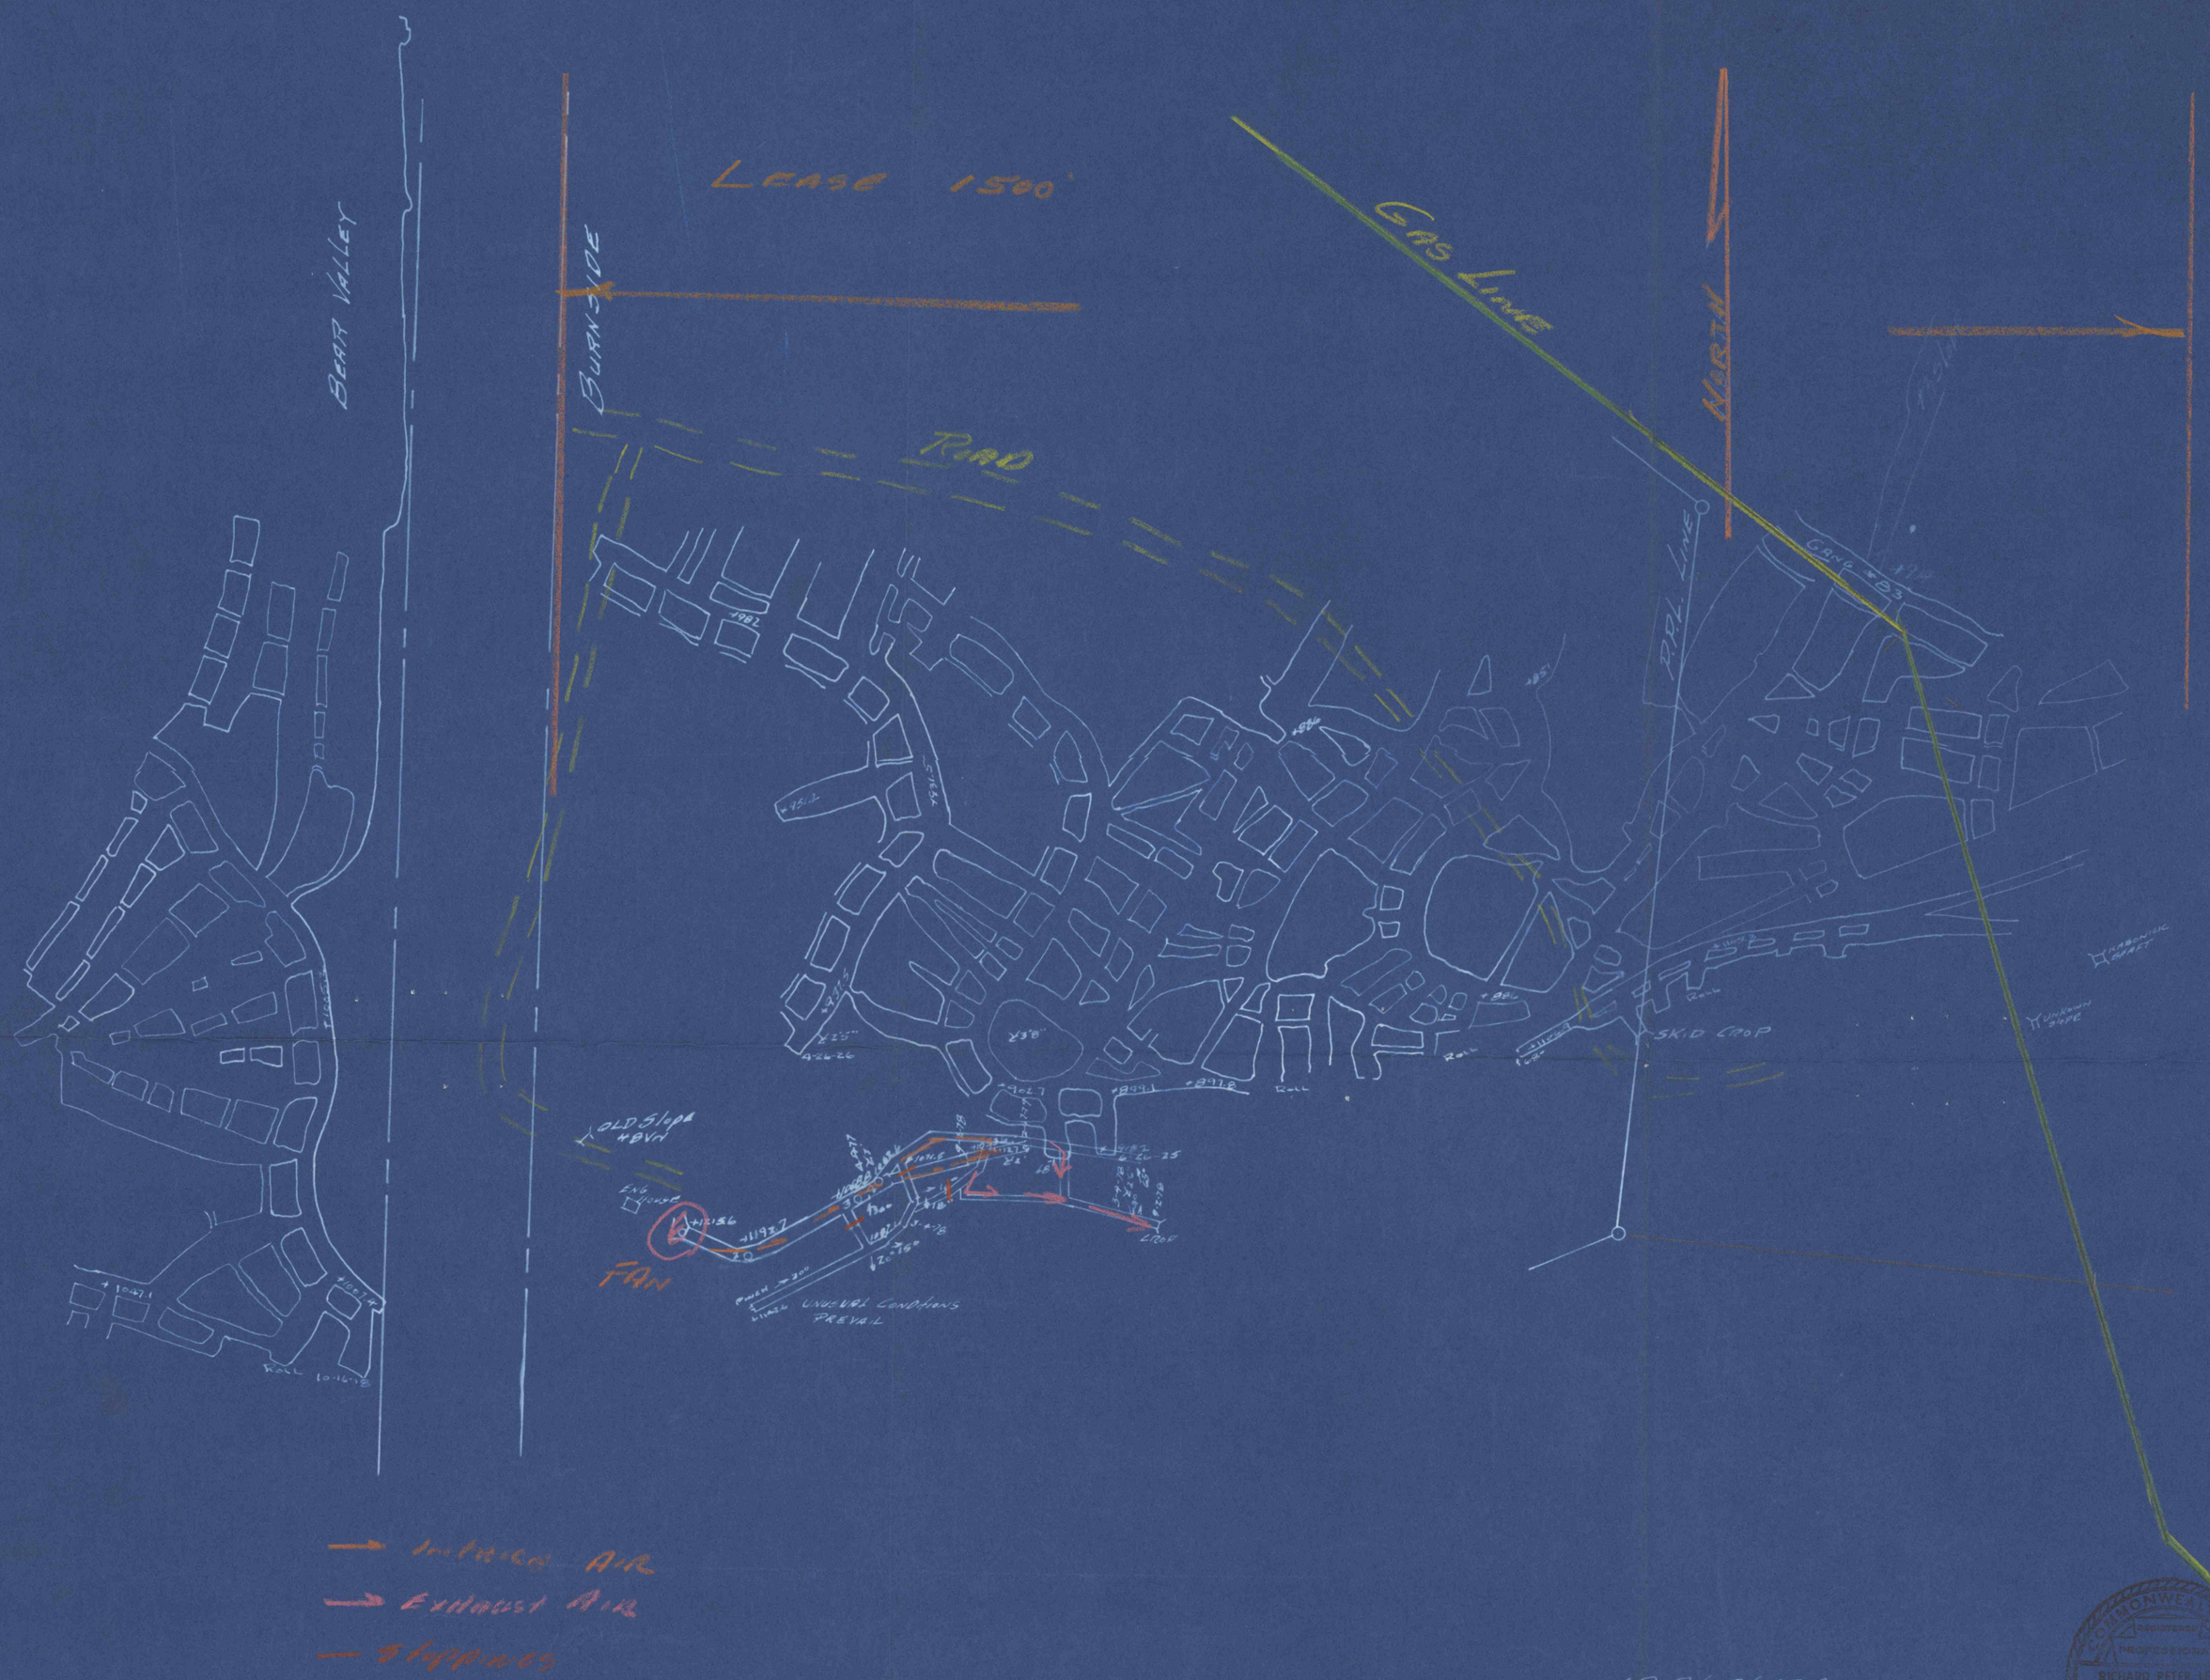

→ Intake Air

→ Exhaust Air

— Stoppings

I.D. 36-06024

K. & W. Coal Co

#7 VEIN

Burnside Colliery Workings

Coal Township Penna

1" = 100'

4-9-77
3-4-78
9-2-78
2-17-79
9-22-79

COMMONWEALTH OF PENNSYLVANIA
REGISTERED PROFESSIONAL
RICHARD PETER LESSER
ENGINEER
No. 8864
PENNSYLVANIA