


NORTHUMBERLAND COUNTY
COLUMBIA COUNTY

MOUNT CARMEL TOWNSHIP
CONYNGHAM TOWNSHIP

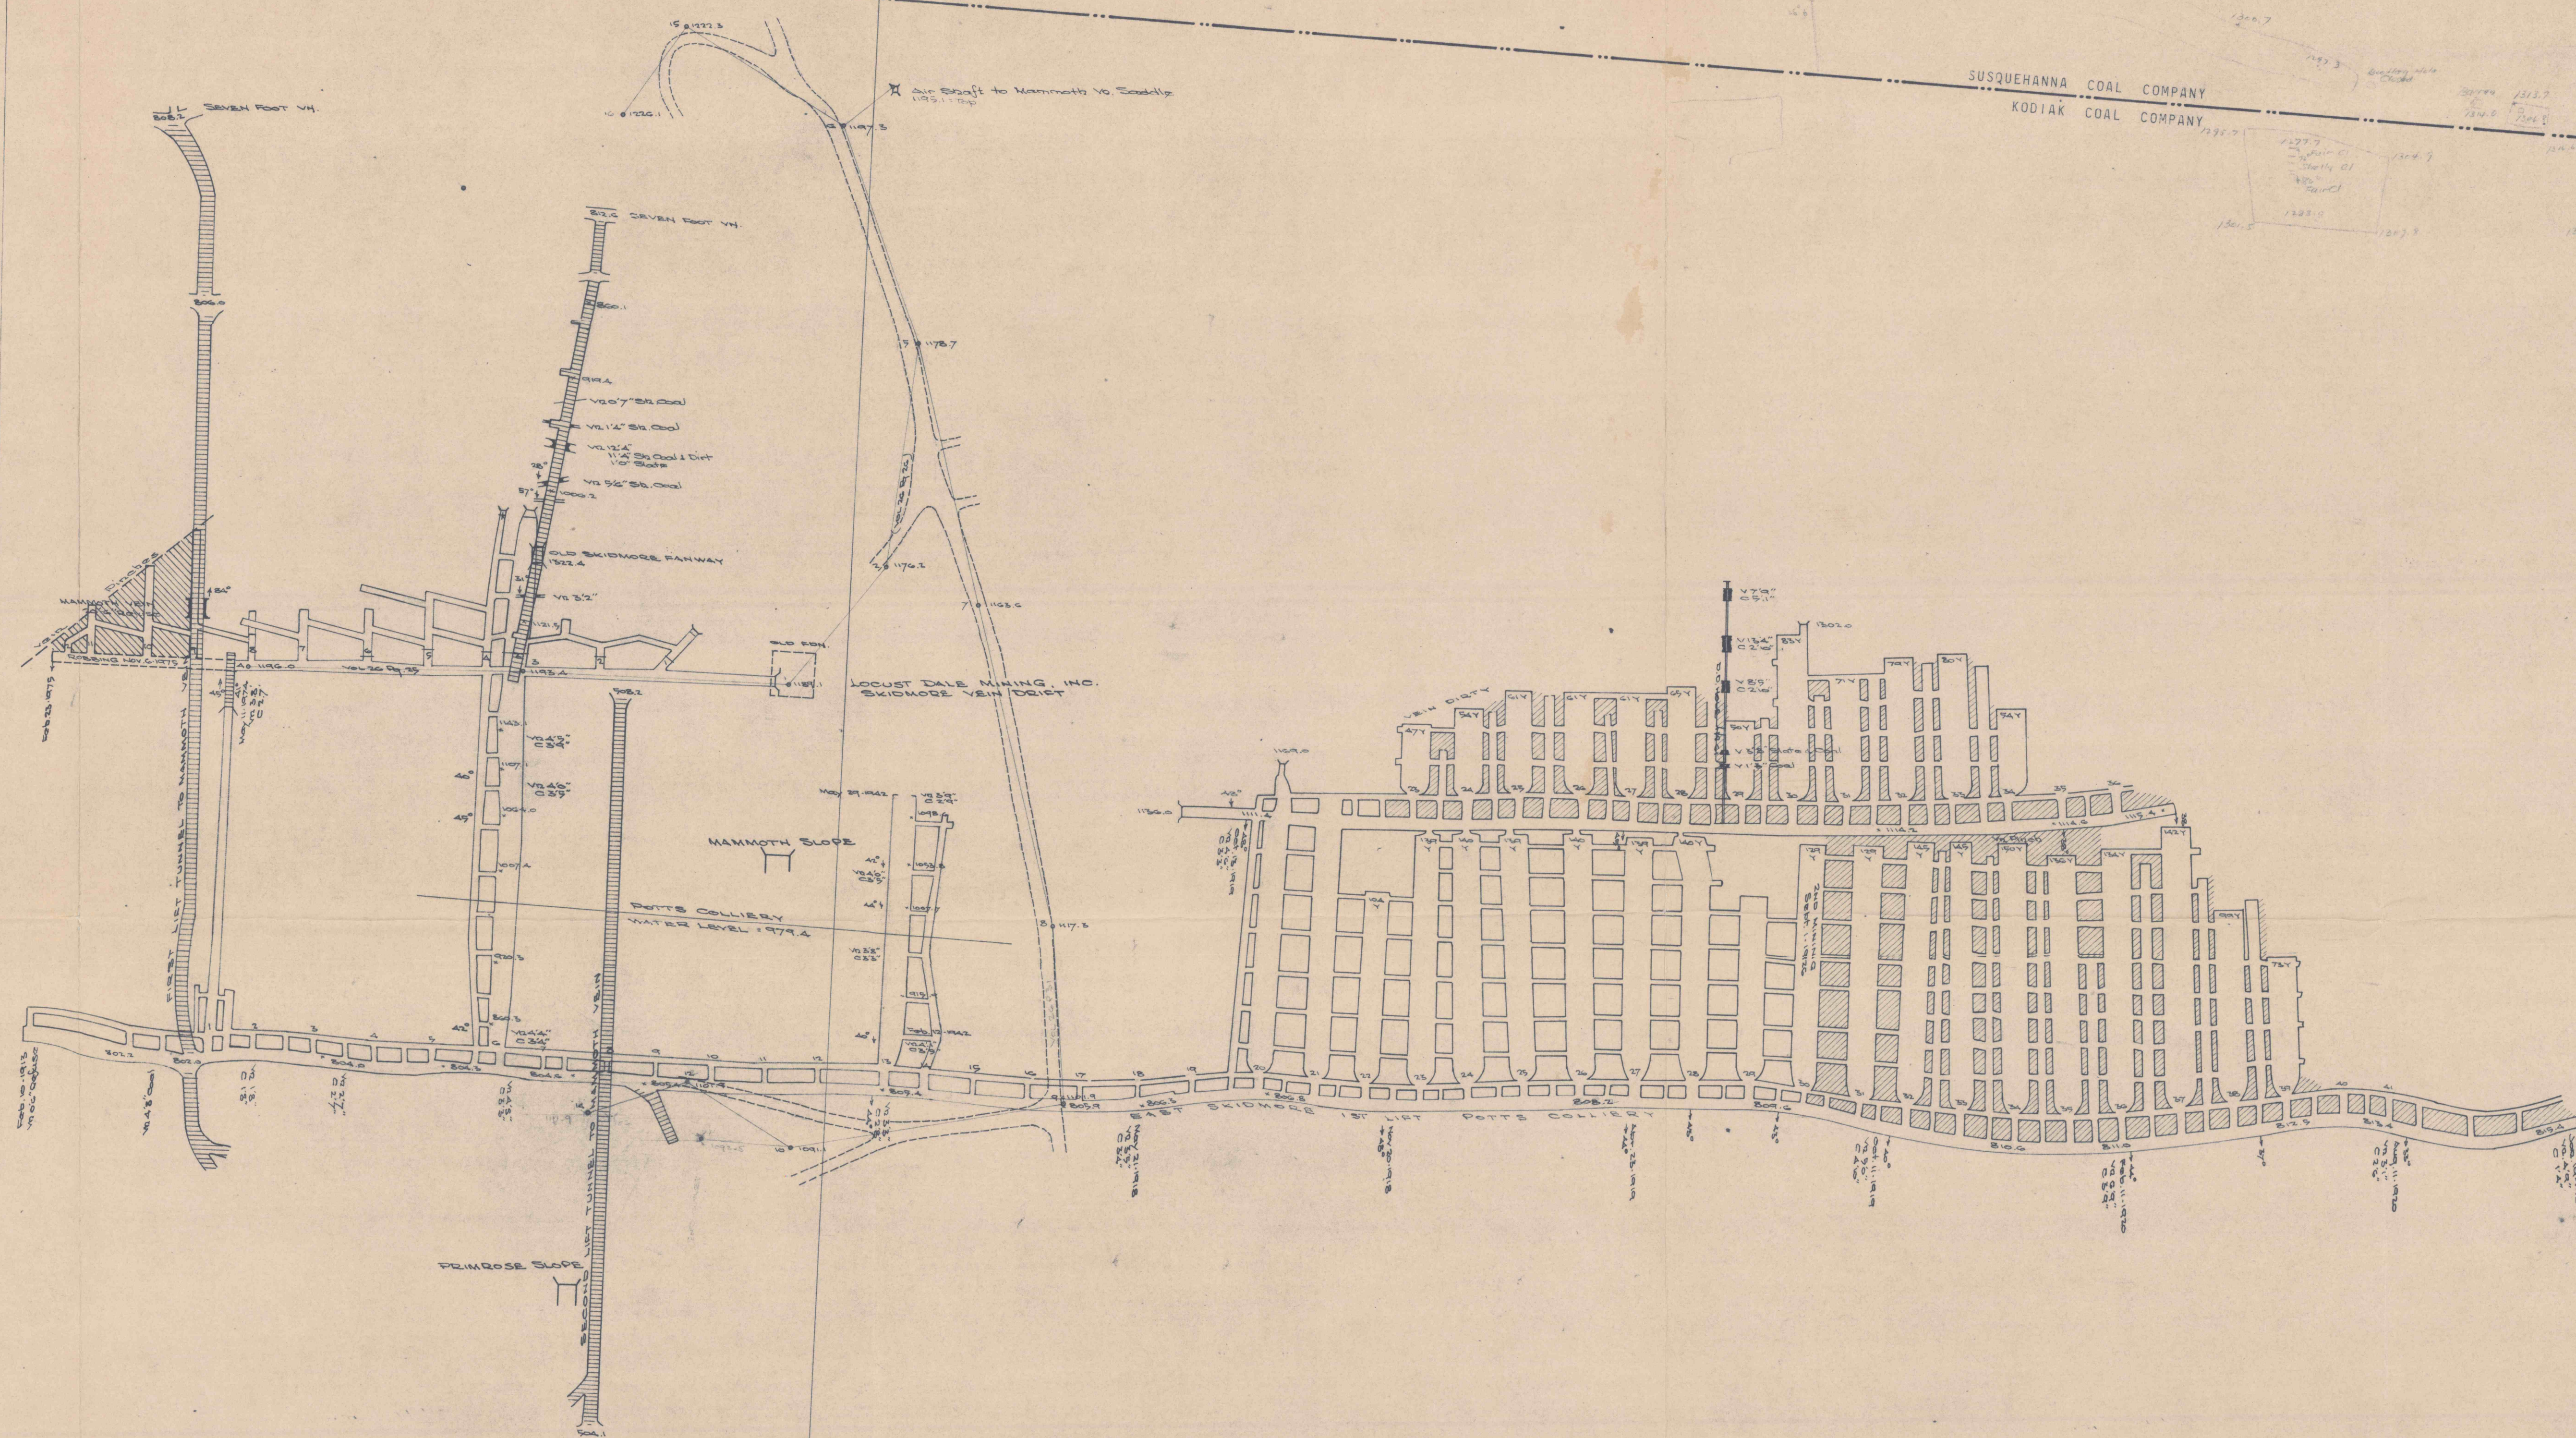

MINE MAP
Showing the location and extent
of development of the Locust Dale
Mining, Inc. Drift Mine. Situate
on the South dip Skidmore Vein,
Conyngham Twp., ~~Butler~~ Columbia County,
Pennsylvania.
A.B. Riedel, P.E. Nov. 6, 1975
Scale 1"=100'

CONYNGHAM TOWNSHIP
BUTLER TOWNSHIP
COLUMBIA COUNTY