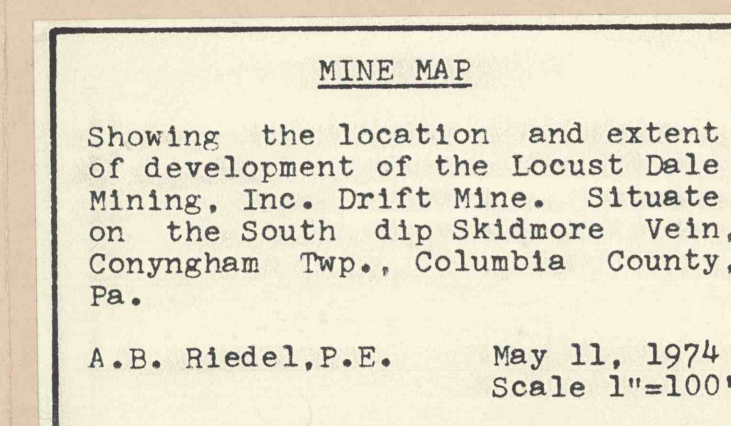
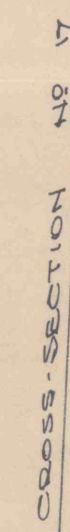
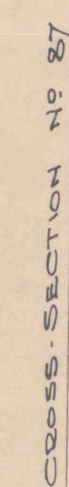
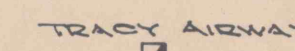
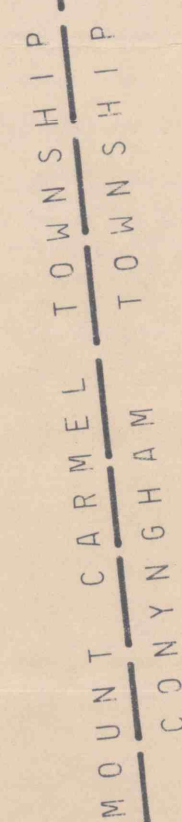
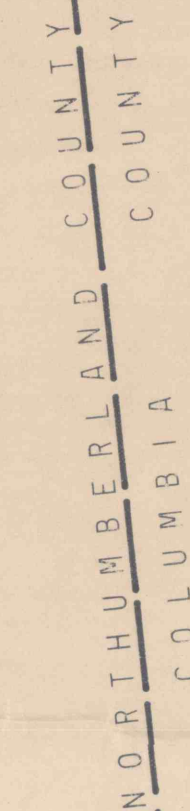


August B. Rind