



VENTILATION SYMBOLS

- = MAIN FAN
- = AUXILIARY FAN
- ➔ = AIR FLOW - INTAKE
- ➔ = AIR FLOW - RETURN
- + = PERMANENT STOPPING
- + = TEMPORARY STOPPING
- ⊠ = AIR BRIDGE
- ⊥ = REGULATOR
- ⊥ = MAN DOOR
- V = VELOCITY, FPM
- Q = QUANTITY, CFM

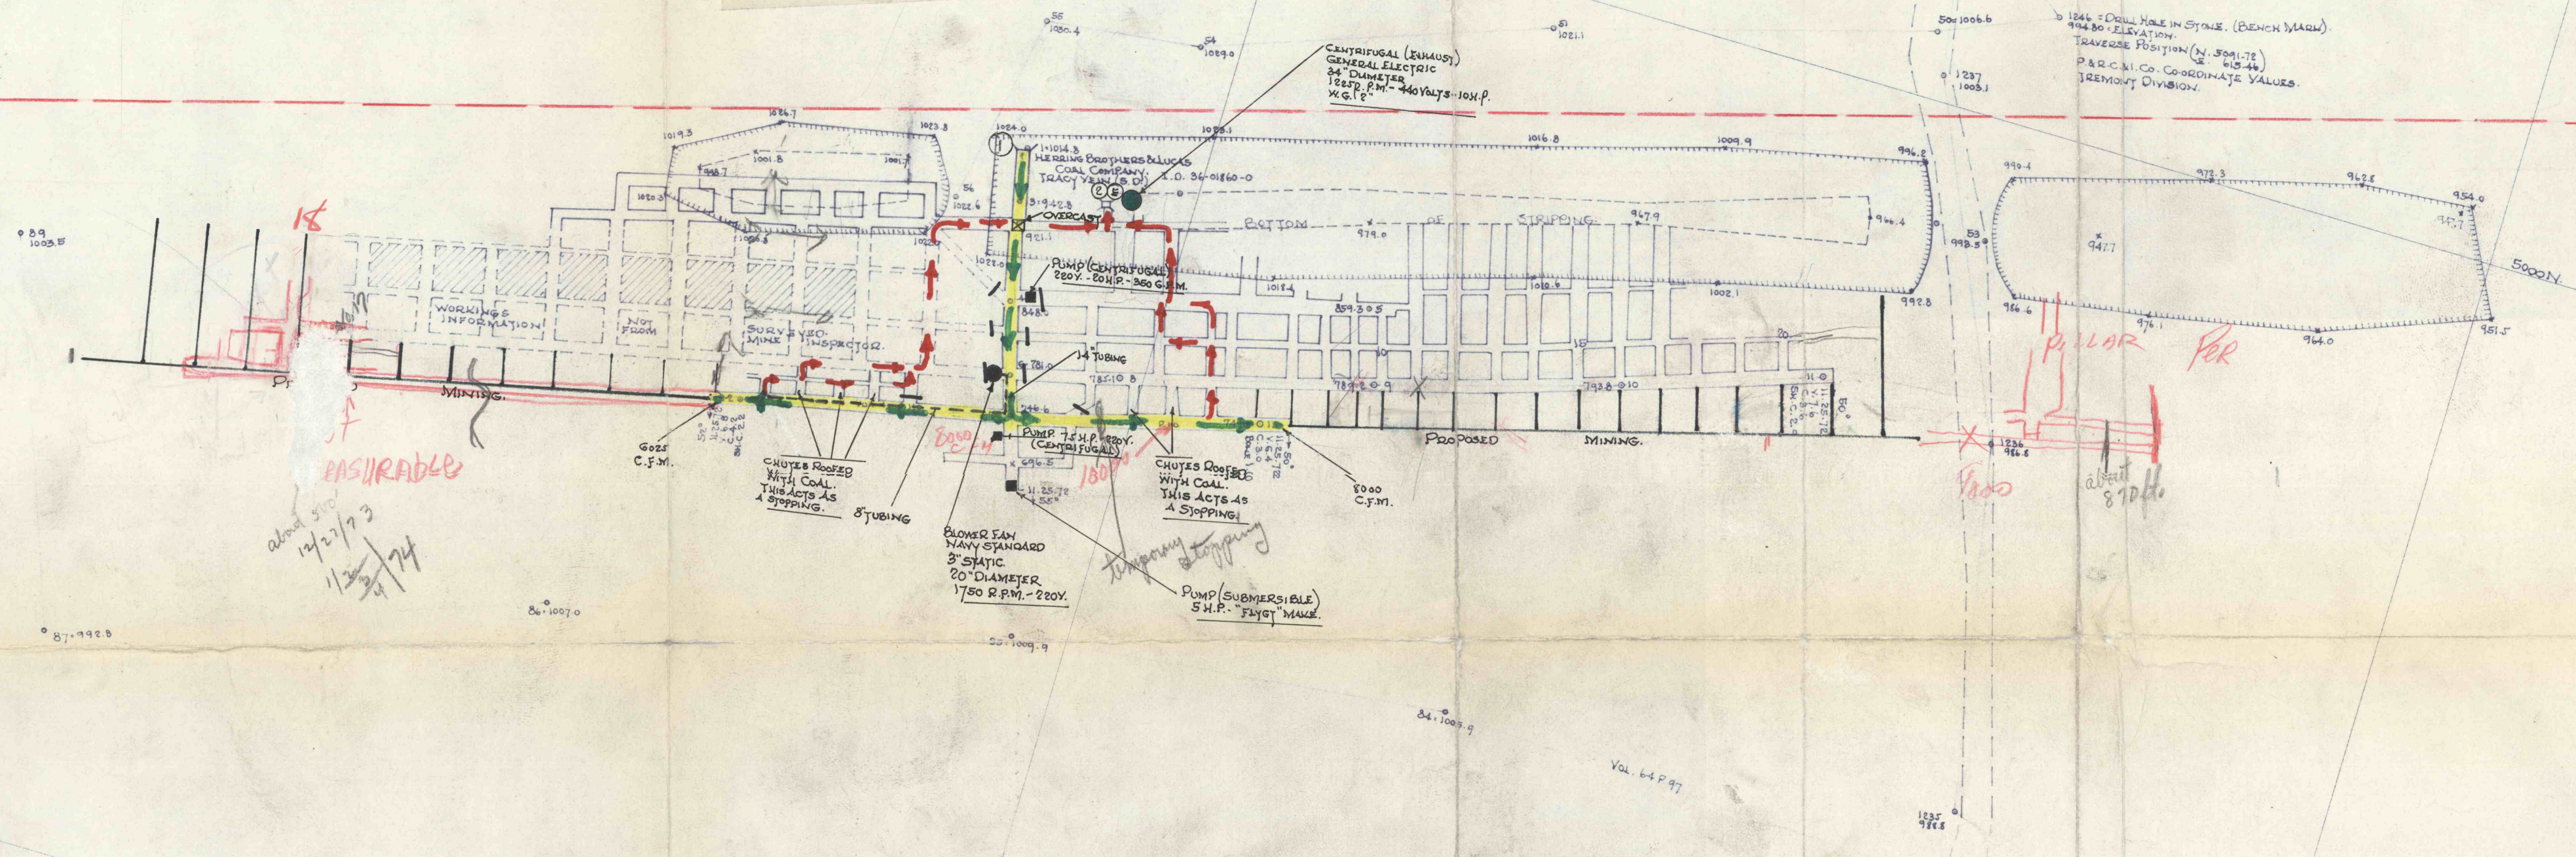

PLAN SHOWING VENTILATION SYSTEM IN HERRING BROTHERS & LUCAS
SLOPE IN TRACY VEIN (S.D.)
FRALLEY TWP. SCHUYLKILL COUNTY PENNA.
DEC. 1-1972
G.T. CURRAN & ASSOCIATES.
SCALE: 1"=100'

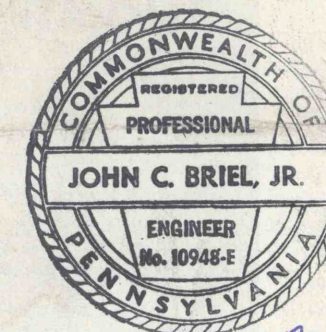

John C. Briel, Jr.