


WILLIAM LAMBERT TRACT


THOMAS REESE JR. TRACT

WILLIAM LANE TRACT

MARY LANE TRACT

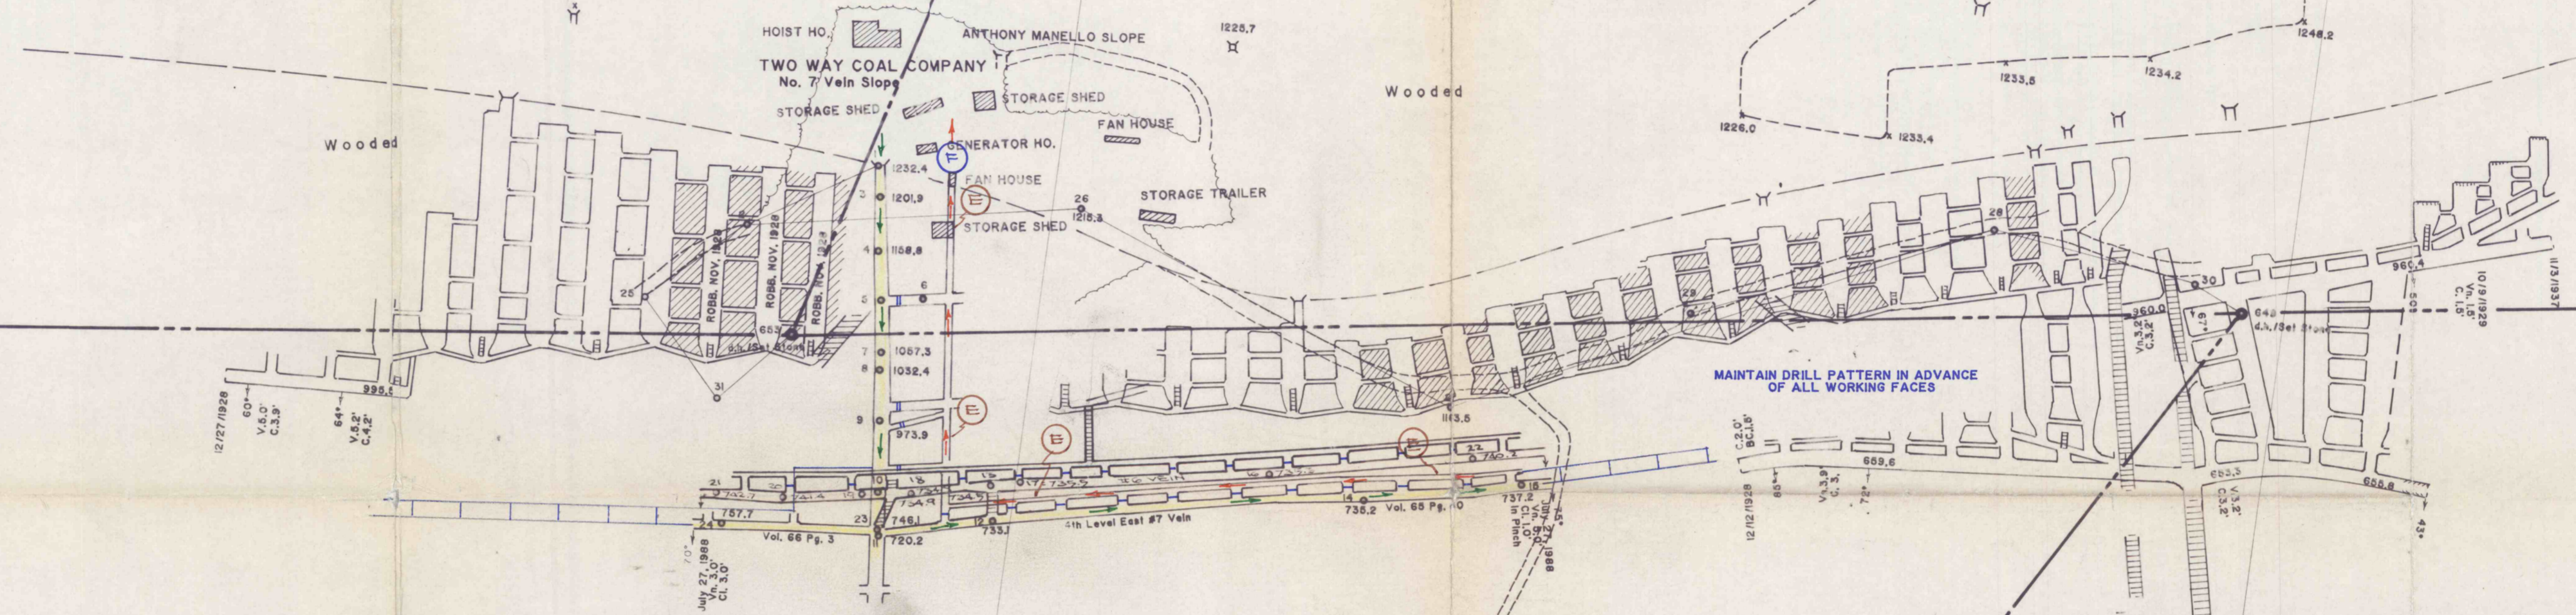

TWO WAY COAL COMPANY
No. 7 Vein Workings - Hickory Swamp Area
Coal Township, Northumberland County

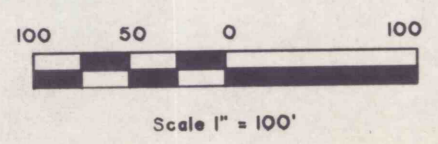

VENTILATION SYMBOLS	
(F) = Main Fan	(A) = Air Bridge
(O) = Auxiliary Fan	(R) = Regulator
(I) = Air Flow - Intake	(M) = Man Door
(E) = Air Flow - Exhaust	V = Velocity, fpm
(+) = Permanent Stopping	Q = Quantity, cfm
(+) = Temporary Stopping	WG = Water Gauge

MINE MAP
Showing the location and extent of development of the Two Way Coal Co. # 7 Vein workings. Situate in the Hickory Swamp Area of Coal Twp., Northumberland County, PA. 36-07171
A.B. Riedel P.E. July 27, 1988
Scale 1" = 100'

A.B. Riedel