

WILLIAM LAMBERT TRACT


THOMAS REESES JR. TRACT

WILLIAM LANE TRACT

MARY LANE TRACT

TWO WAY COAL COMPANY

No. 5 Vein Workings - Hickory Swamp Area
Coal Township, Northumberland County

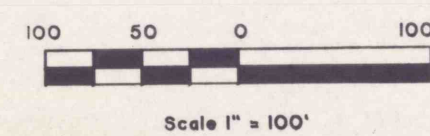

No. 1 SLOPE

VENTILATION SYMBOLS	
(F) = Main Fan	▢ = Air Bridge
○ = Auxiliary Fan	⊥ = Regulator
→ = Air Flow - Intake	⋈ = Man Door
⇨ = Air Flow - Exhaust	V = Velocity, fpm
+ = Permanent Stopping	Q = Quantity, cfm
⊕ = Temporary Stopping	WG = Water Gauge

MINE MAP

Showing the location and extent of development of the Two Way Coal Co. # 5 Vein workings. Situate in the Hickory Swamp Area of Coal Twp., Northumberland County, PA.

A.B. Riedel P.E.

July 27, 1988
Scale 1" = 100'

as per B. Riedel