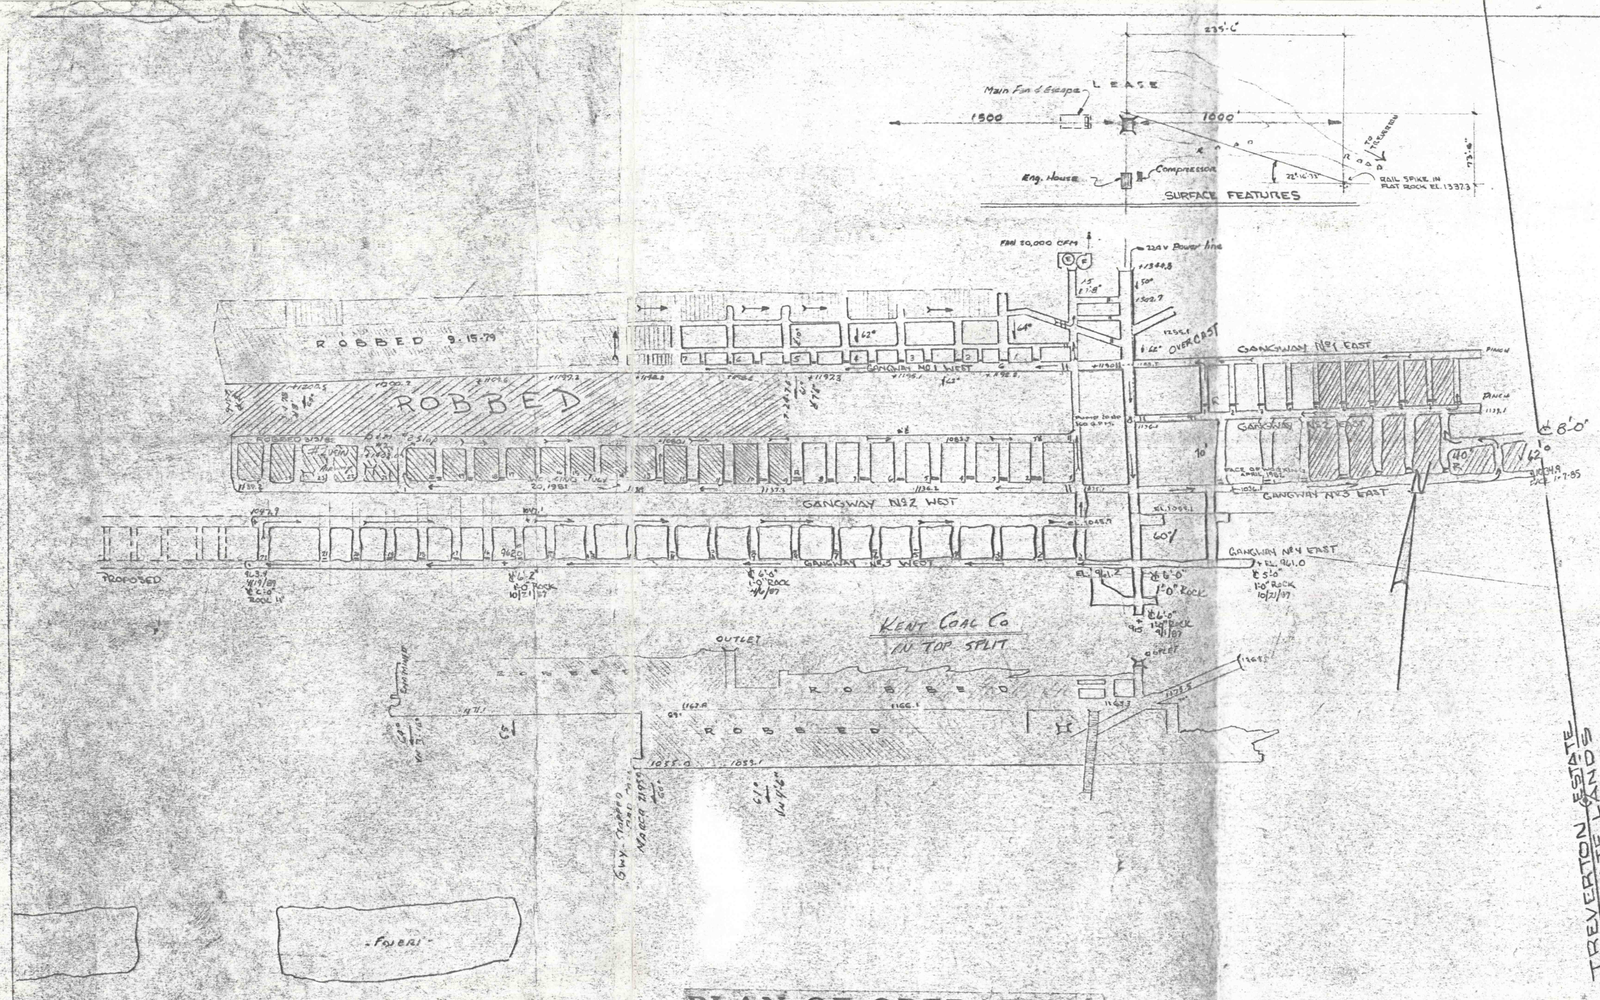

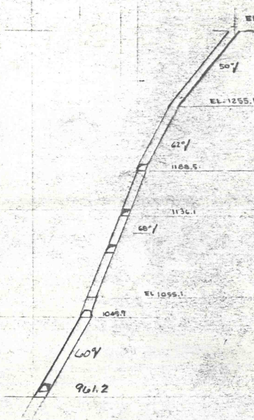

CROSS SECTION THRU VEIN
(LOOKING WEST)

TREVERTON ESTATE
ASSOCIATE LANDS

LEGEND

- INTAKE AIR
- EXHAUST AIR
- STOPPING
- E ESCAPE
- F MAIN FAN
- R REGULATOR

MONWEALTH OF PENNSYLVANIA
REGISTERED PROFESSIONAL
HARRY E. TRUMBAUER
ENGINEER
NO. 23935-E
23 May 1989

S.B.M. COAL CO.
ZERO VEIN
ZERBE TWP. TOWNSHIP
NORTHUMBERLAND CO. PA.
I.D. 36-05495
SCALE 1"=100'-0"
M & R SLOPE
4/19/89

388