


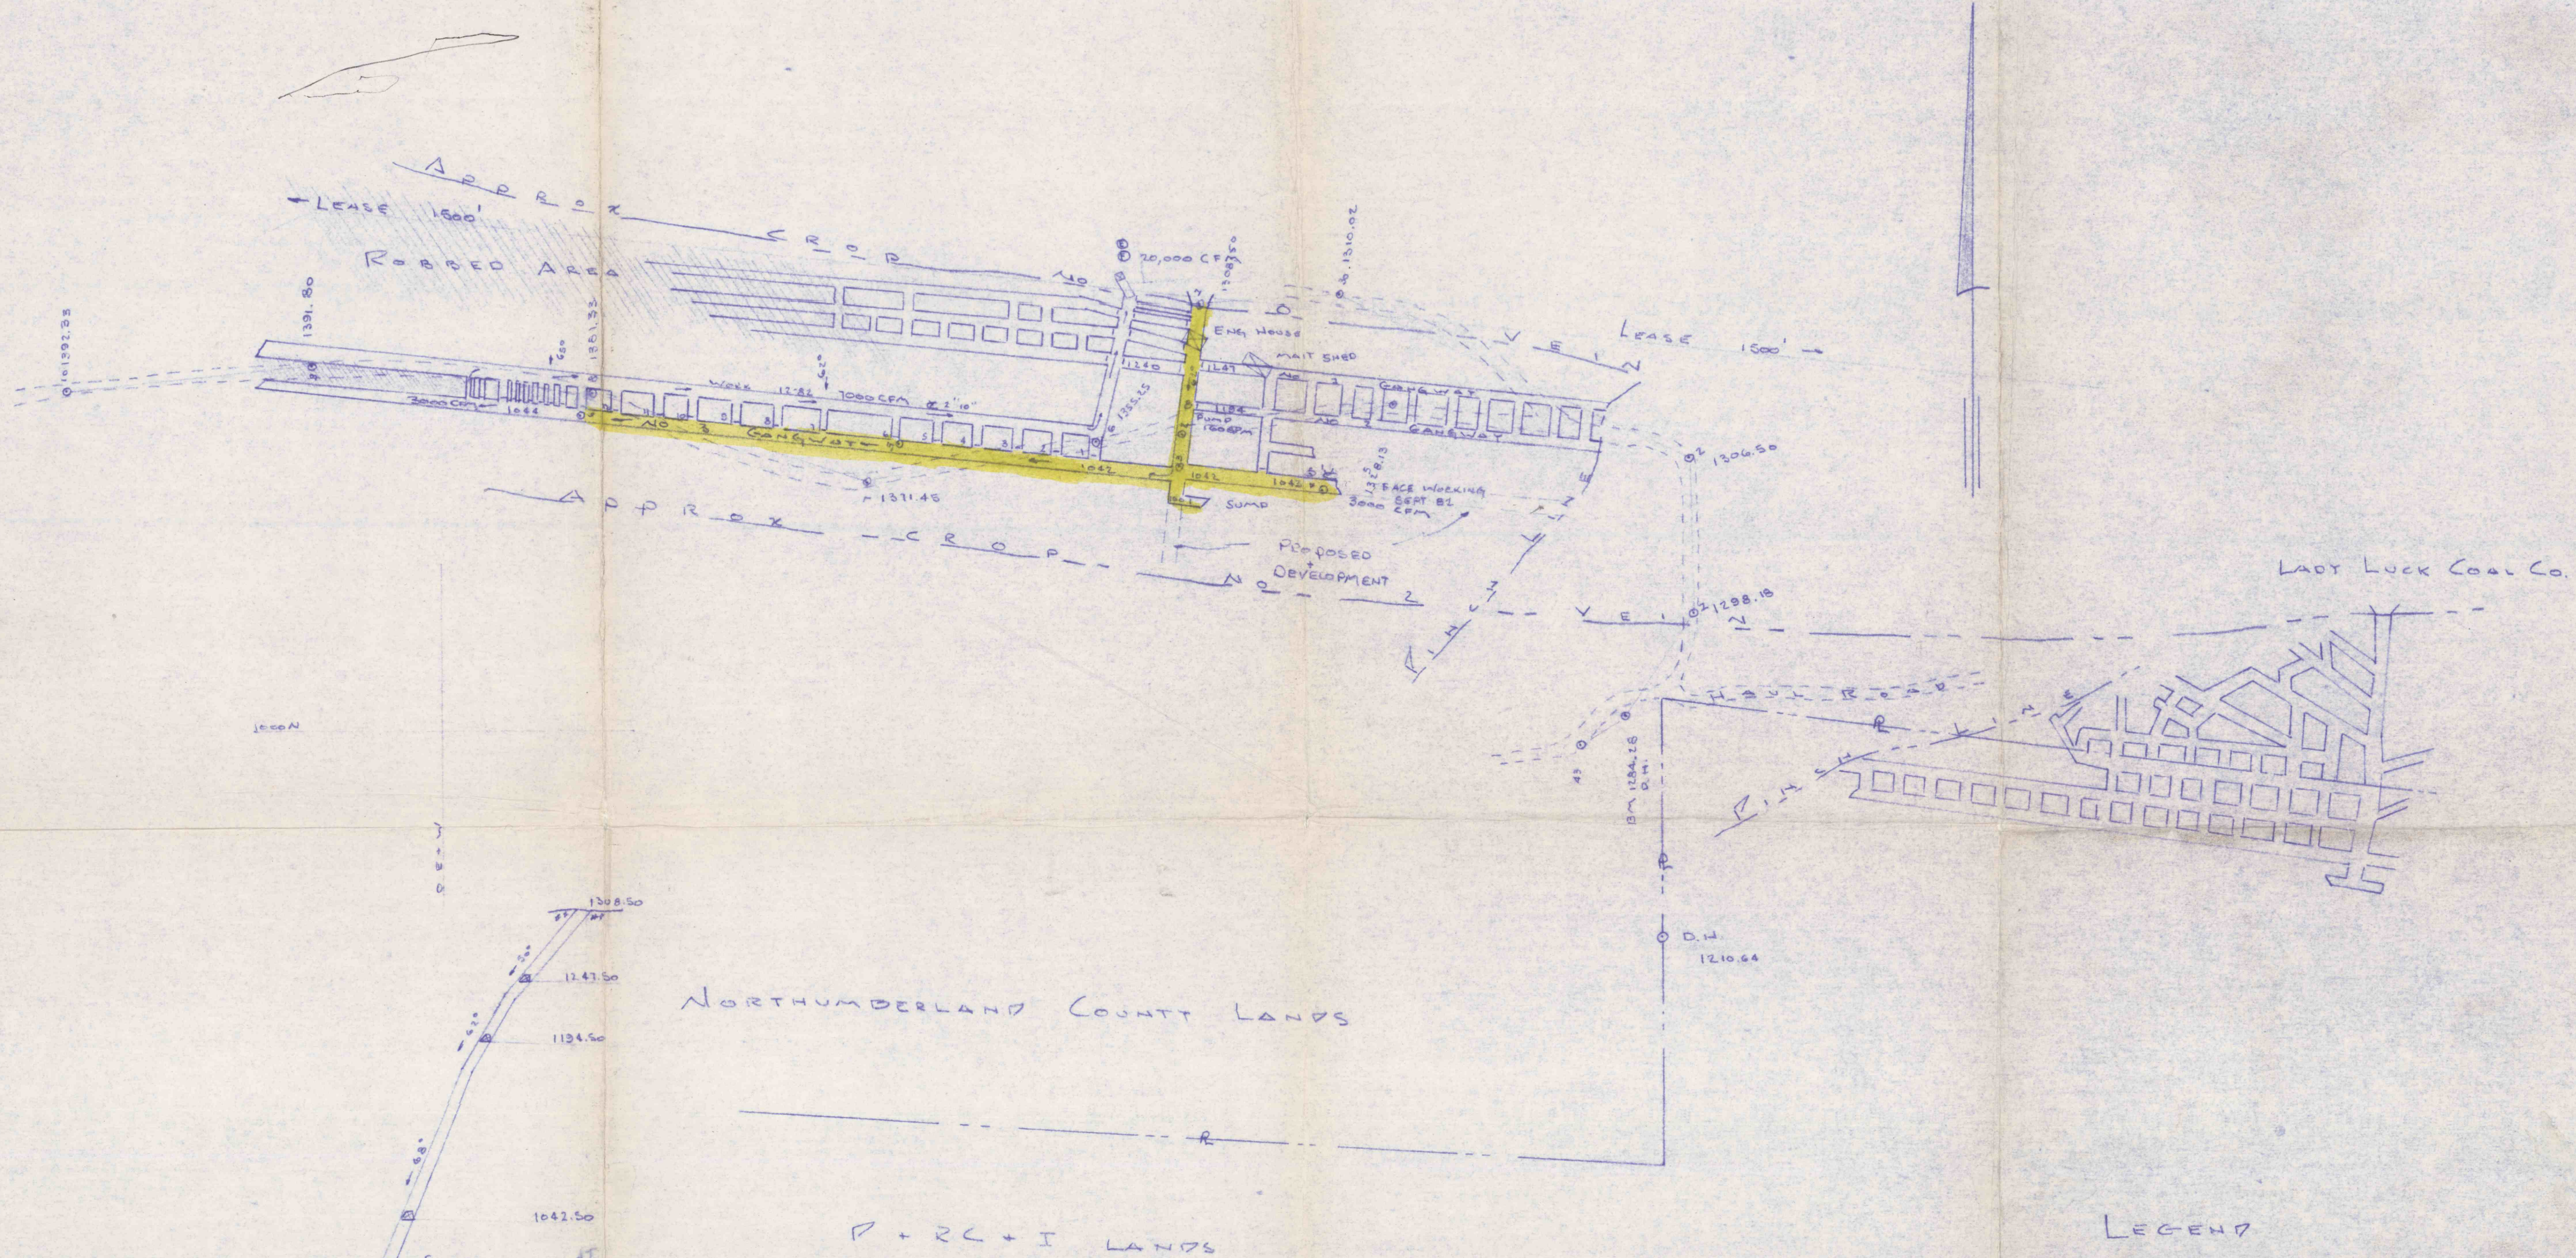

SECTION THRU SLOPE
(LOOKING EAST)

NORTH FRANKLIN WATER POOL
E = 876.64 11-82

- LEGEND
- ← AIR
 - STOPPING
 - ⊙ ESCAPEWAY
 - ⊗ FAN

 WAGNER ASSOCIATES, INC. Engineers • Architects • Planners • Surveyors 312 Mauch Chunk Street, Pottsville, PA. 17901			
		M + R COAL Co.	
ZERO VEIN C BED, POTTSVILLE FORMATION SITUATE ZERSE TOWNSHIP NORTHUMBERLAND COUNTY, PA.		ID# 36-06130	
ISSUE DATE: 12-29-83	SCALE: 1" = 100'	DATE: 11-15-83	ORDER NO.: P-5124-A
DWG. BY: SCB	CHKD. BY: SMD	DWG. NO.:	
PROJ. MGR: SCB	DEPT. HD: QWS	92166	