



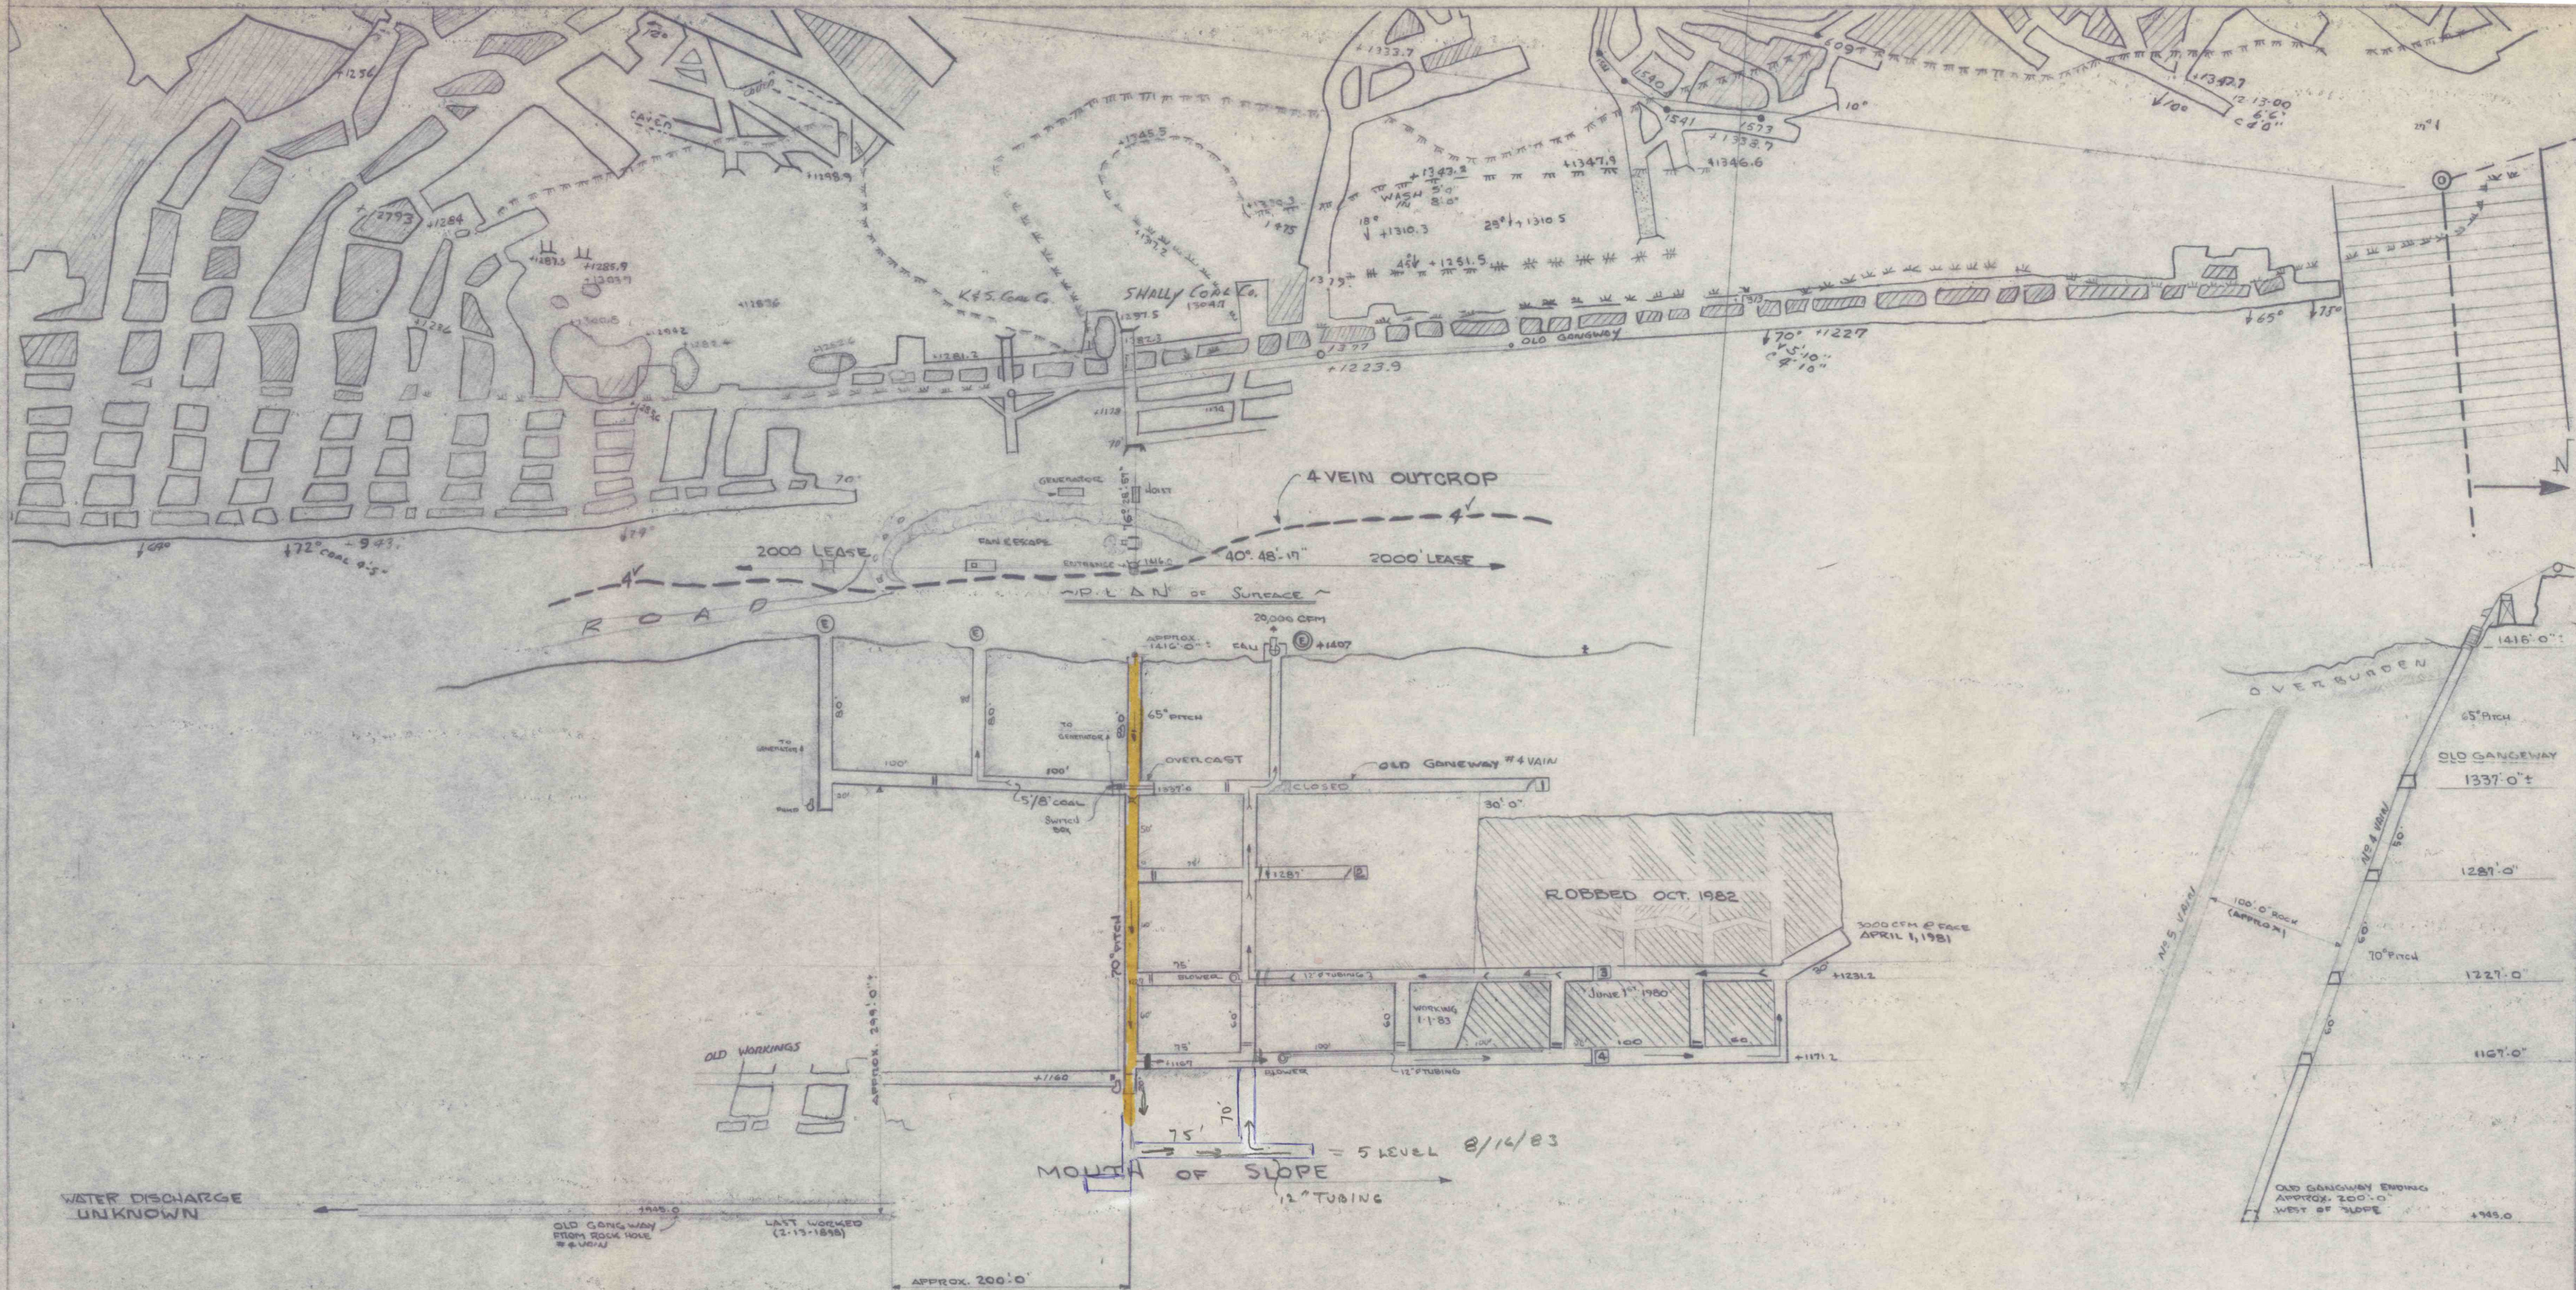

JOE SHALAMAMDA COAL CO.
 ID No 3604866
 #4 VEIN SLOPE
 SAGON
 MT. CARMEL TWP.
 NORTH'D COUNTY PA.
 SCALE 1"=100'-0"

~LEGEND~

- ⊕ MAIN FAN
- INTAKE AIR
- RETURN AIR
- = PERMANENT STOPPING
- TEMPORARY STOPPING
- BRATTICE
- ⊙ ESCAPEWAY RETURN AIR WAY
- ⊙ ESCAPEWAY INTAKE AIR
- II OVER CAST

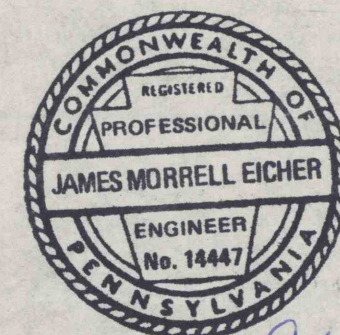

James M Eicher
 12/30/1982

EXHIBIT - B