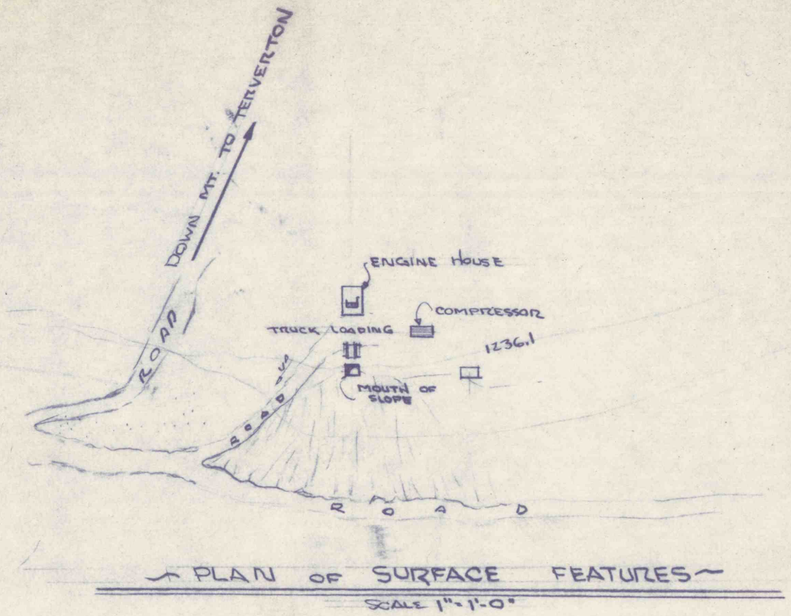

PLAN OF SURFACE FEATURES

SCALE 1" = 1'-0"

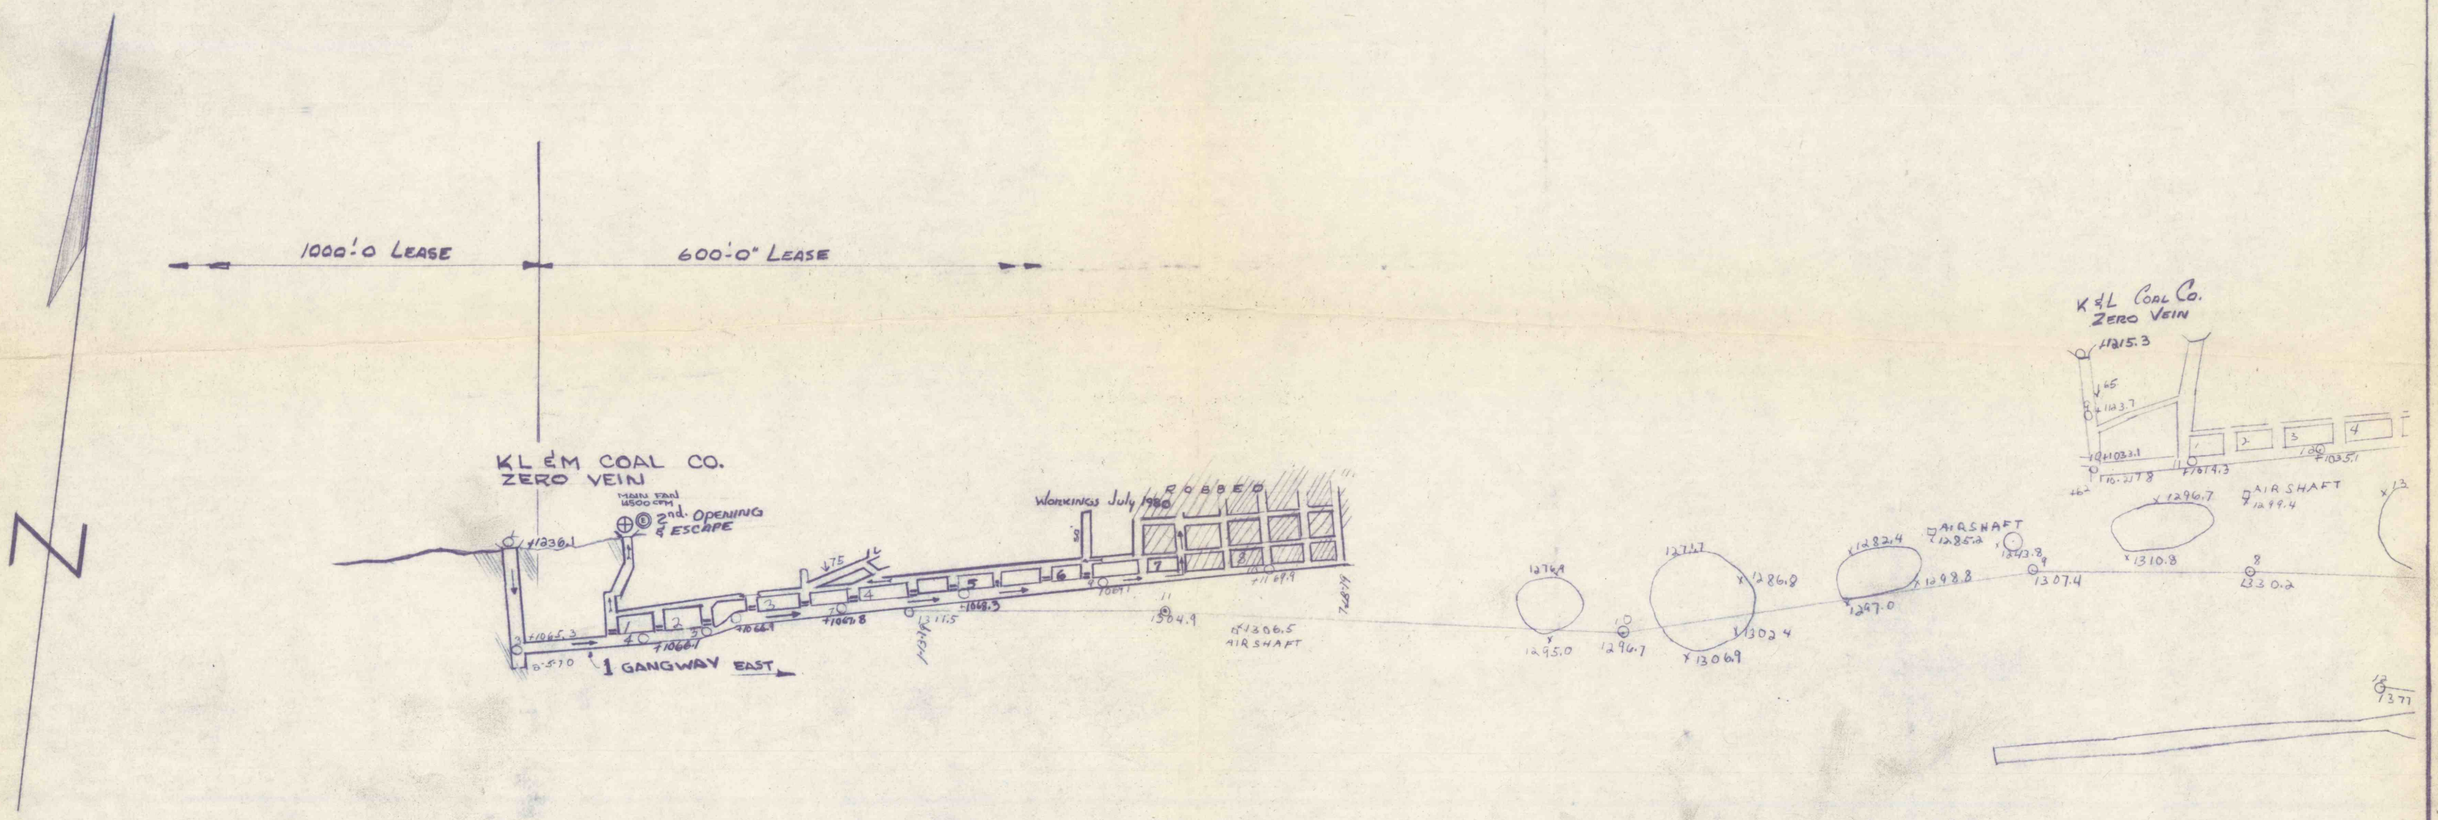

LEGEND

- MAIN FAN
- INTAKE AIR
- RETURN AIR
- PERMANENT STOPPING
- TEMPORARY STOPPING
- BRATTICE
- ESCAPEWAY RETURN AIR
- ESCAPEWAY INTAKE AIR
- OVER CAST

K L & M COAL CO.

COMMONWEALTH OF PENNSYLVANIA
REGISTERED PROFESSIONAL
MICHAEL F. CATINO
ENGINEER
No. 22154-E

Michael F. Catino
7-16-80

I.D. 36-06398
K L & M COAL CO.
ZERO VEIN - TREVERTON PA.
ZERBE TOWNSHIP, PA.
NORTHUMBERLAND COUNTY
SCALE 1" = 100' 0" JULY, 1980

404