

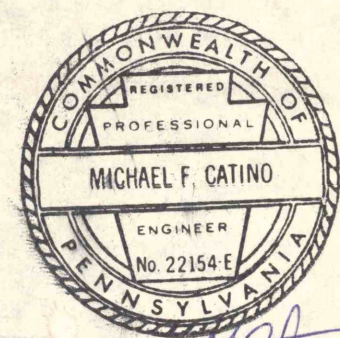


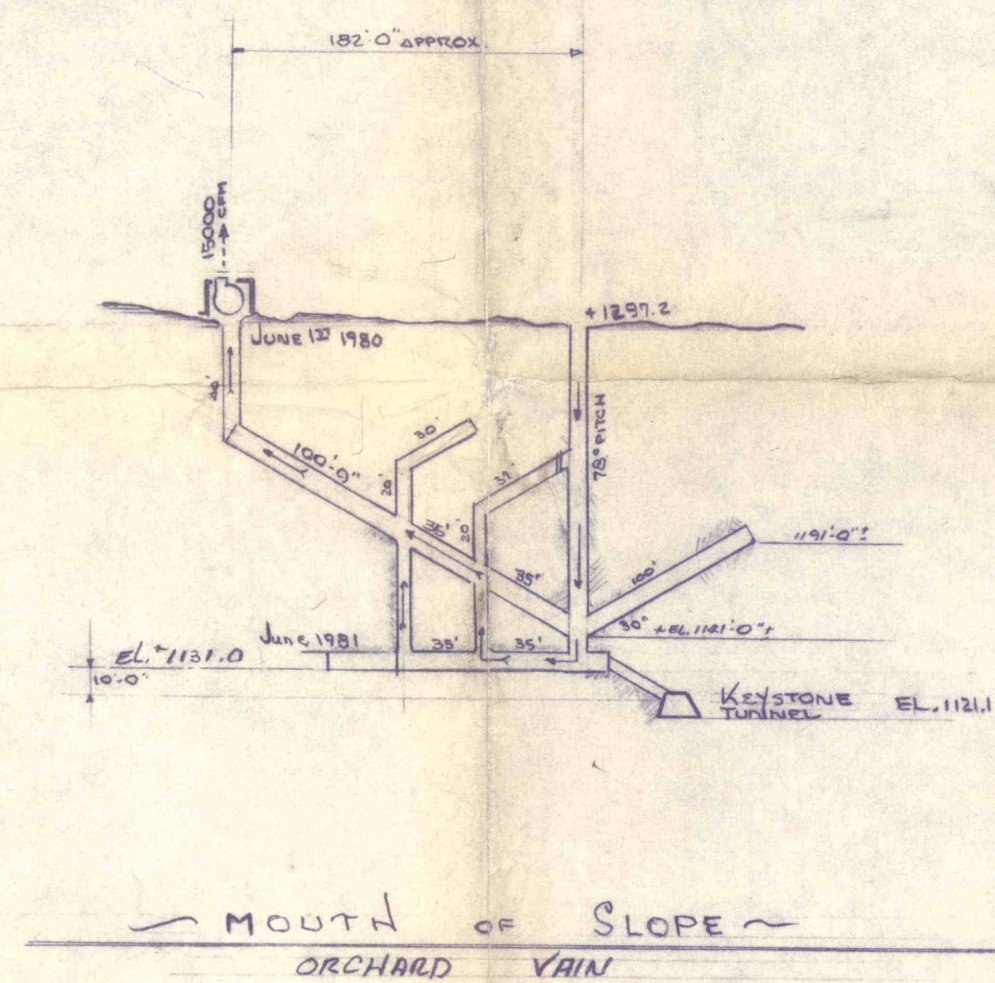

- ~ ~ ~ L E G E N D ~ ~ ~
- | | |
|-----|--------------------------|
| ⊕ | MAIN FAN |
| → | INTAKE AIR |
| ↶ | RETURN AIR |
| = | PERMANENT STOPPING |
| — | TEMPORARY STOPPING |
| --- | BRATICE |
| ◎ | ESCAPEWAY RETURN AIR WAY |
| ⊙ | ESCAPEWAY INTAKE AIR |
| ⊥ | OVER CAST |

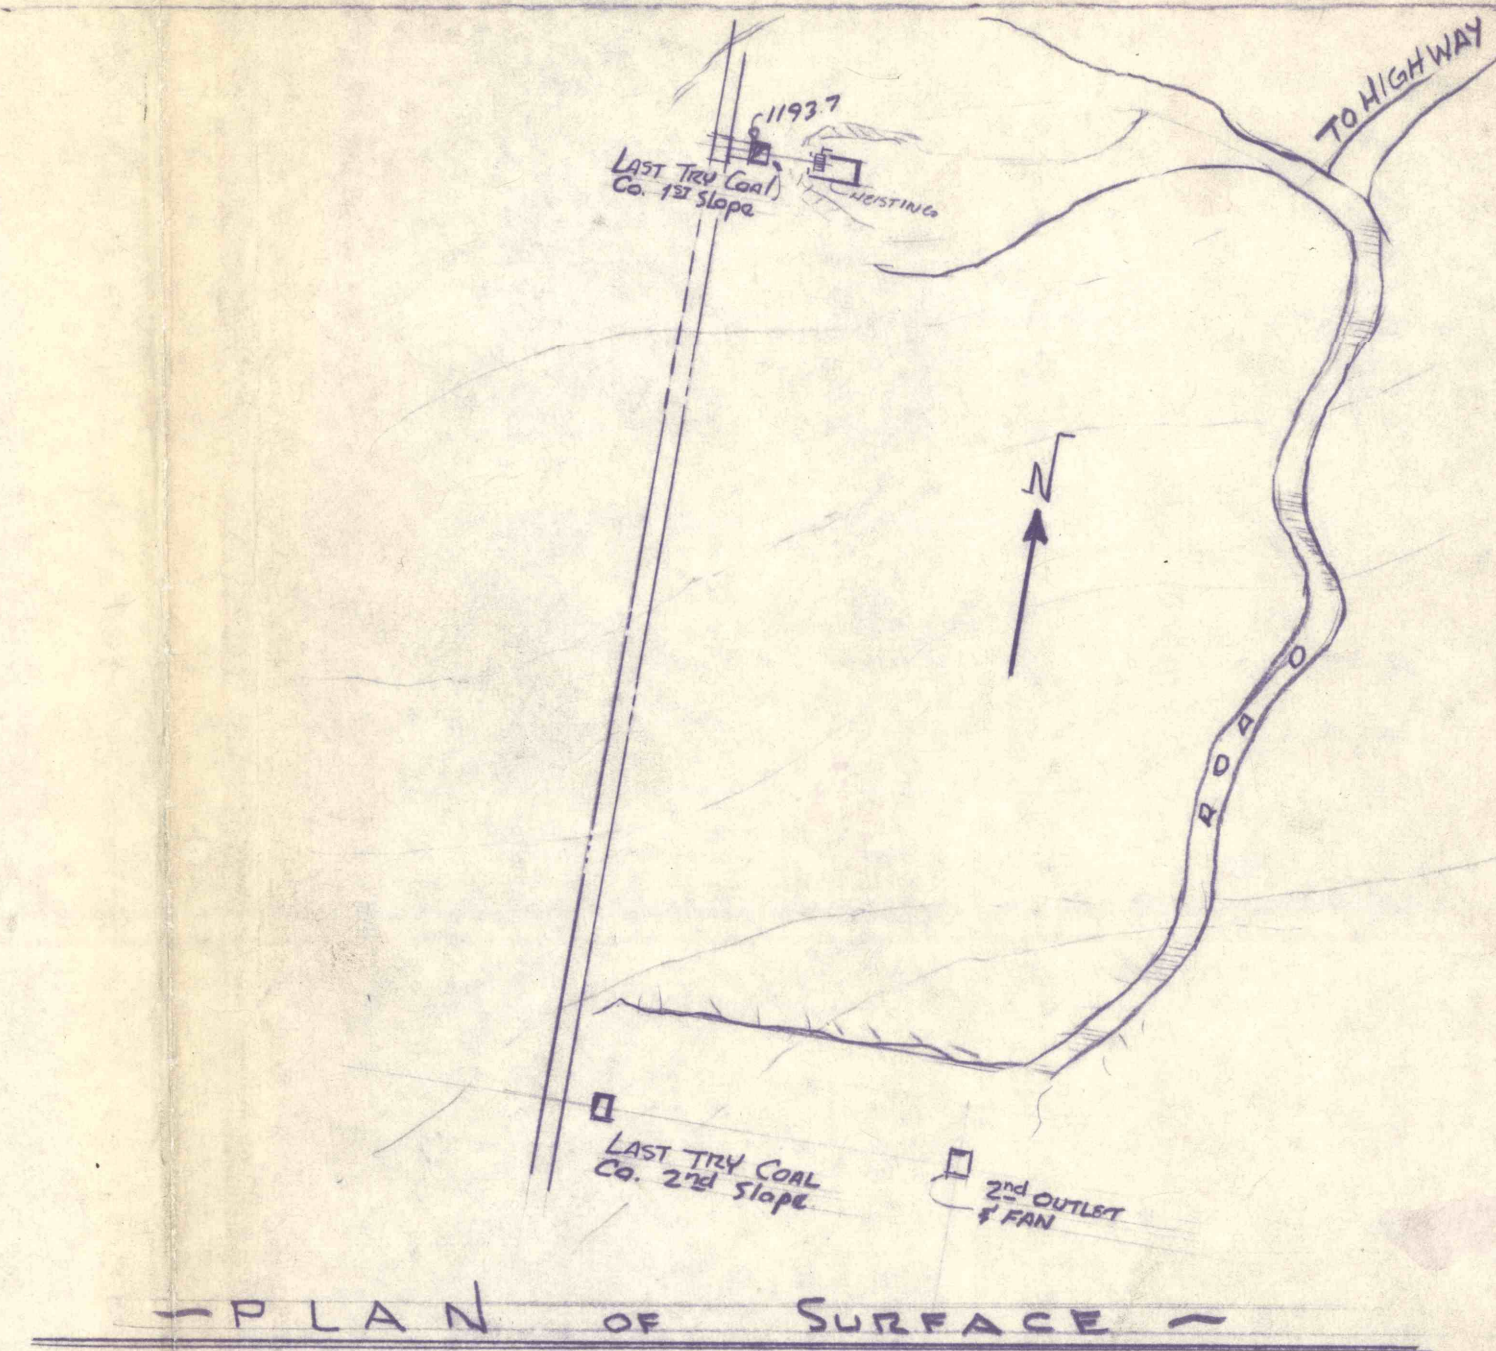