


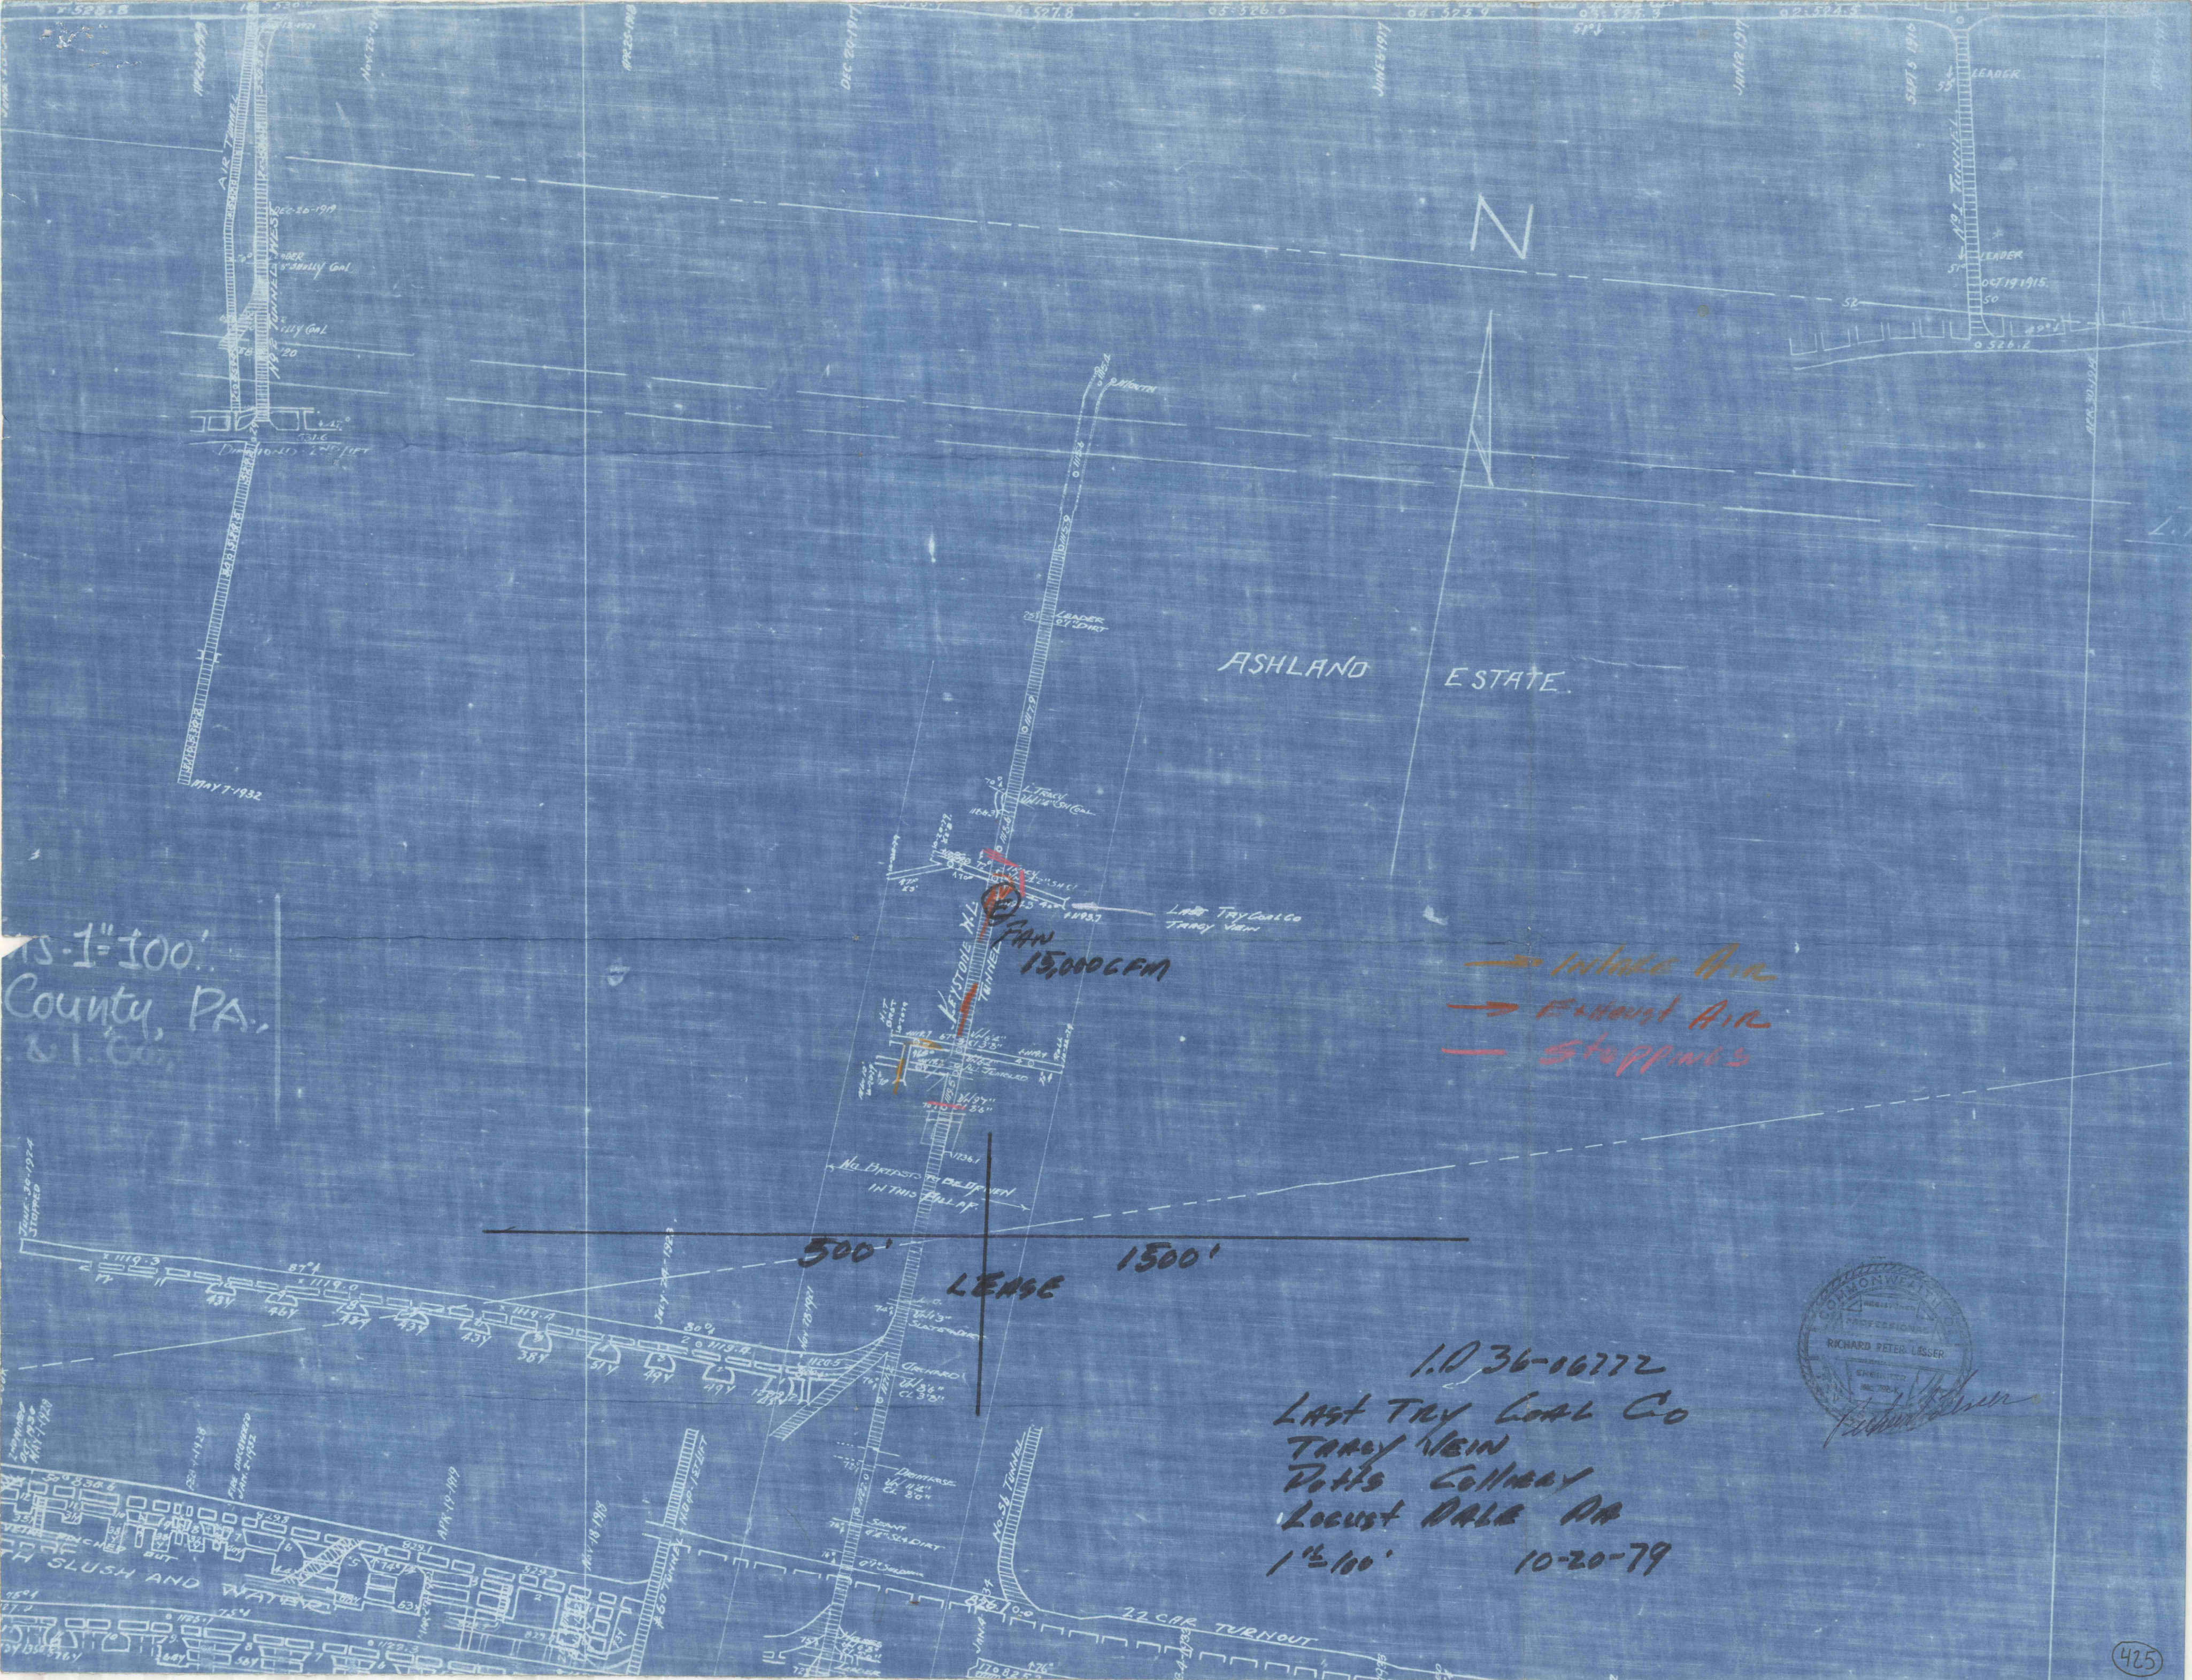

1"=100'
County, PA.
81.00'

ASHLAND ESTATE

Intake Air
Exhaust Air
Stoppings

500' LEASE 1500'

1.036-06772
Last Try Coal Co
Tracy vein
Potts Colliery
Locust Dale PA
1"=100' 10-20-79

