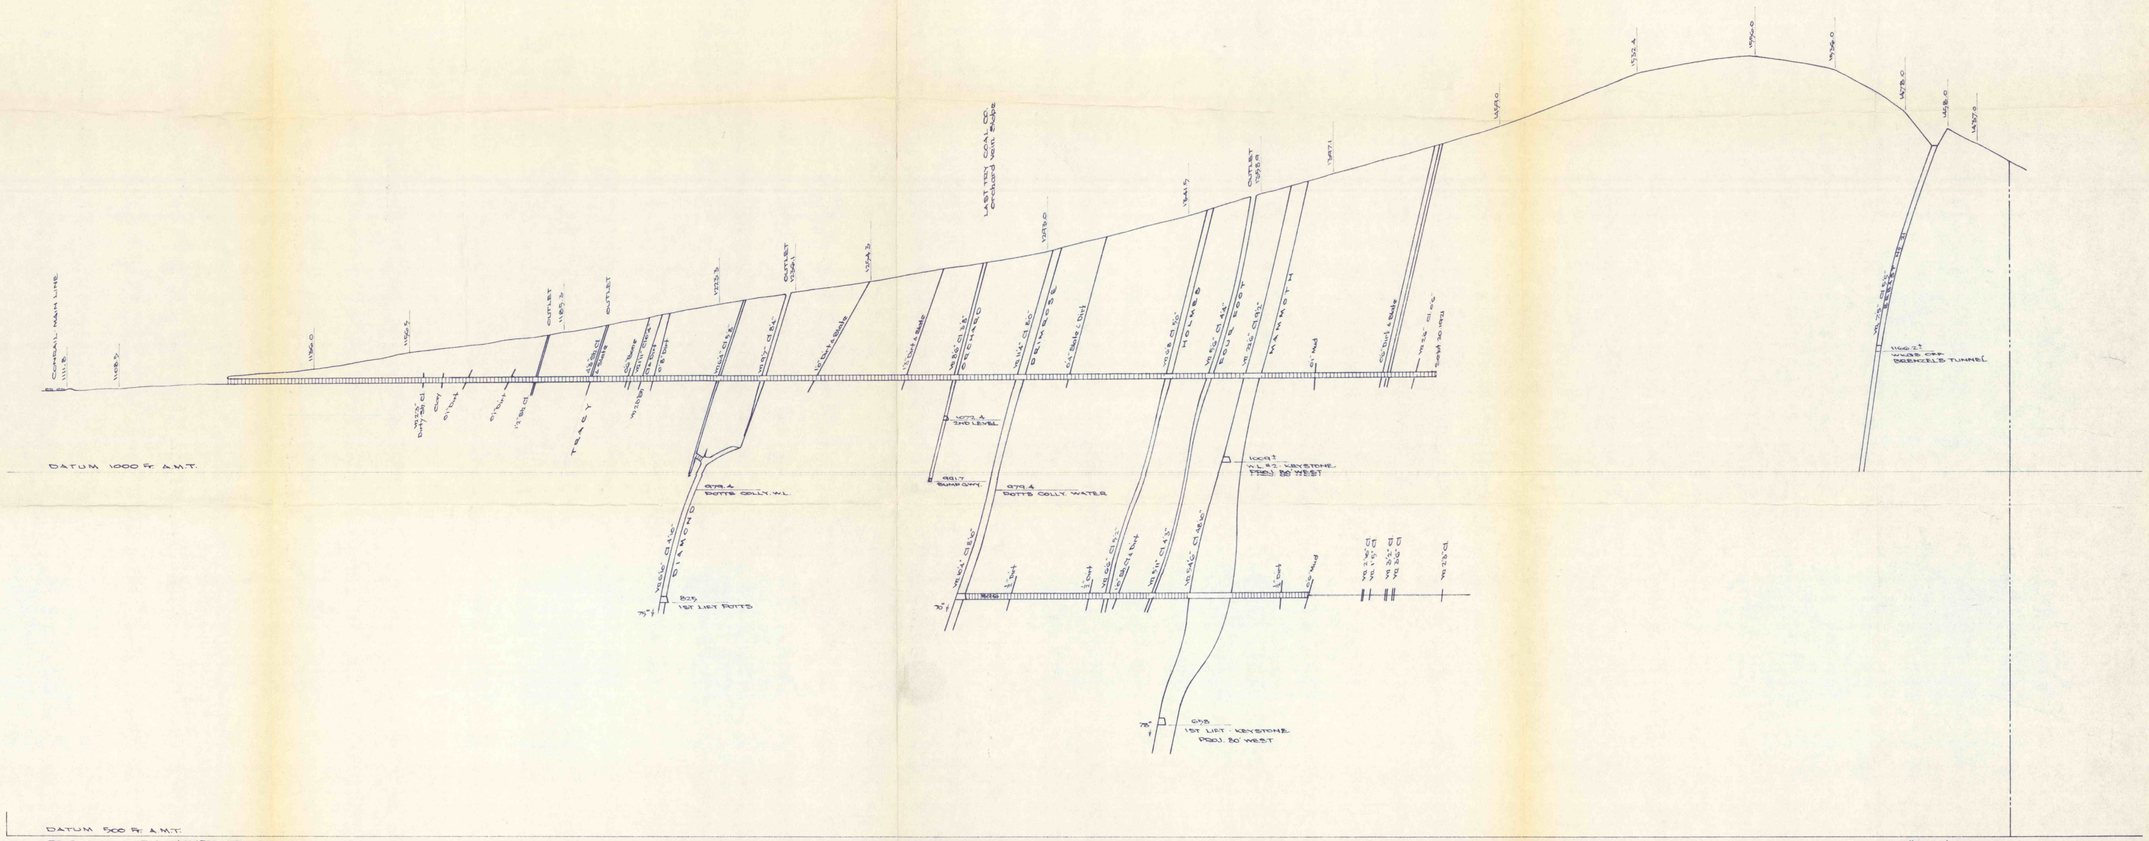

SECTION THRU KEYSTONE TUNNEL

LOOKING EAST

SCALE 1" = 100'