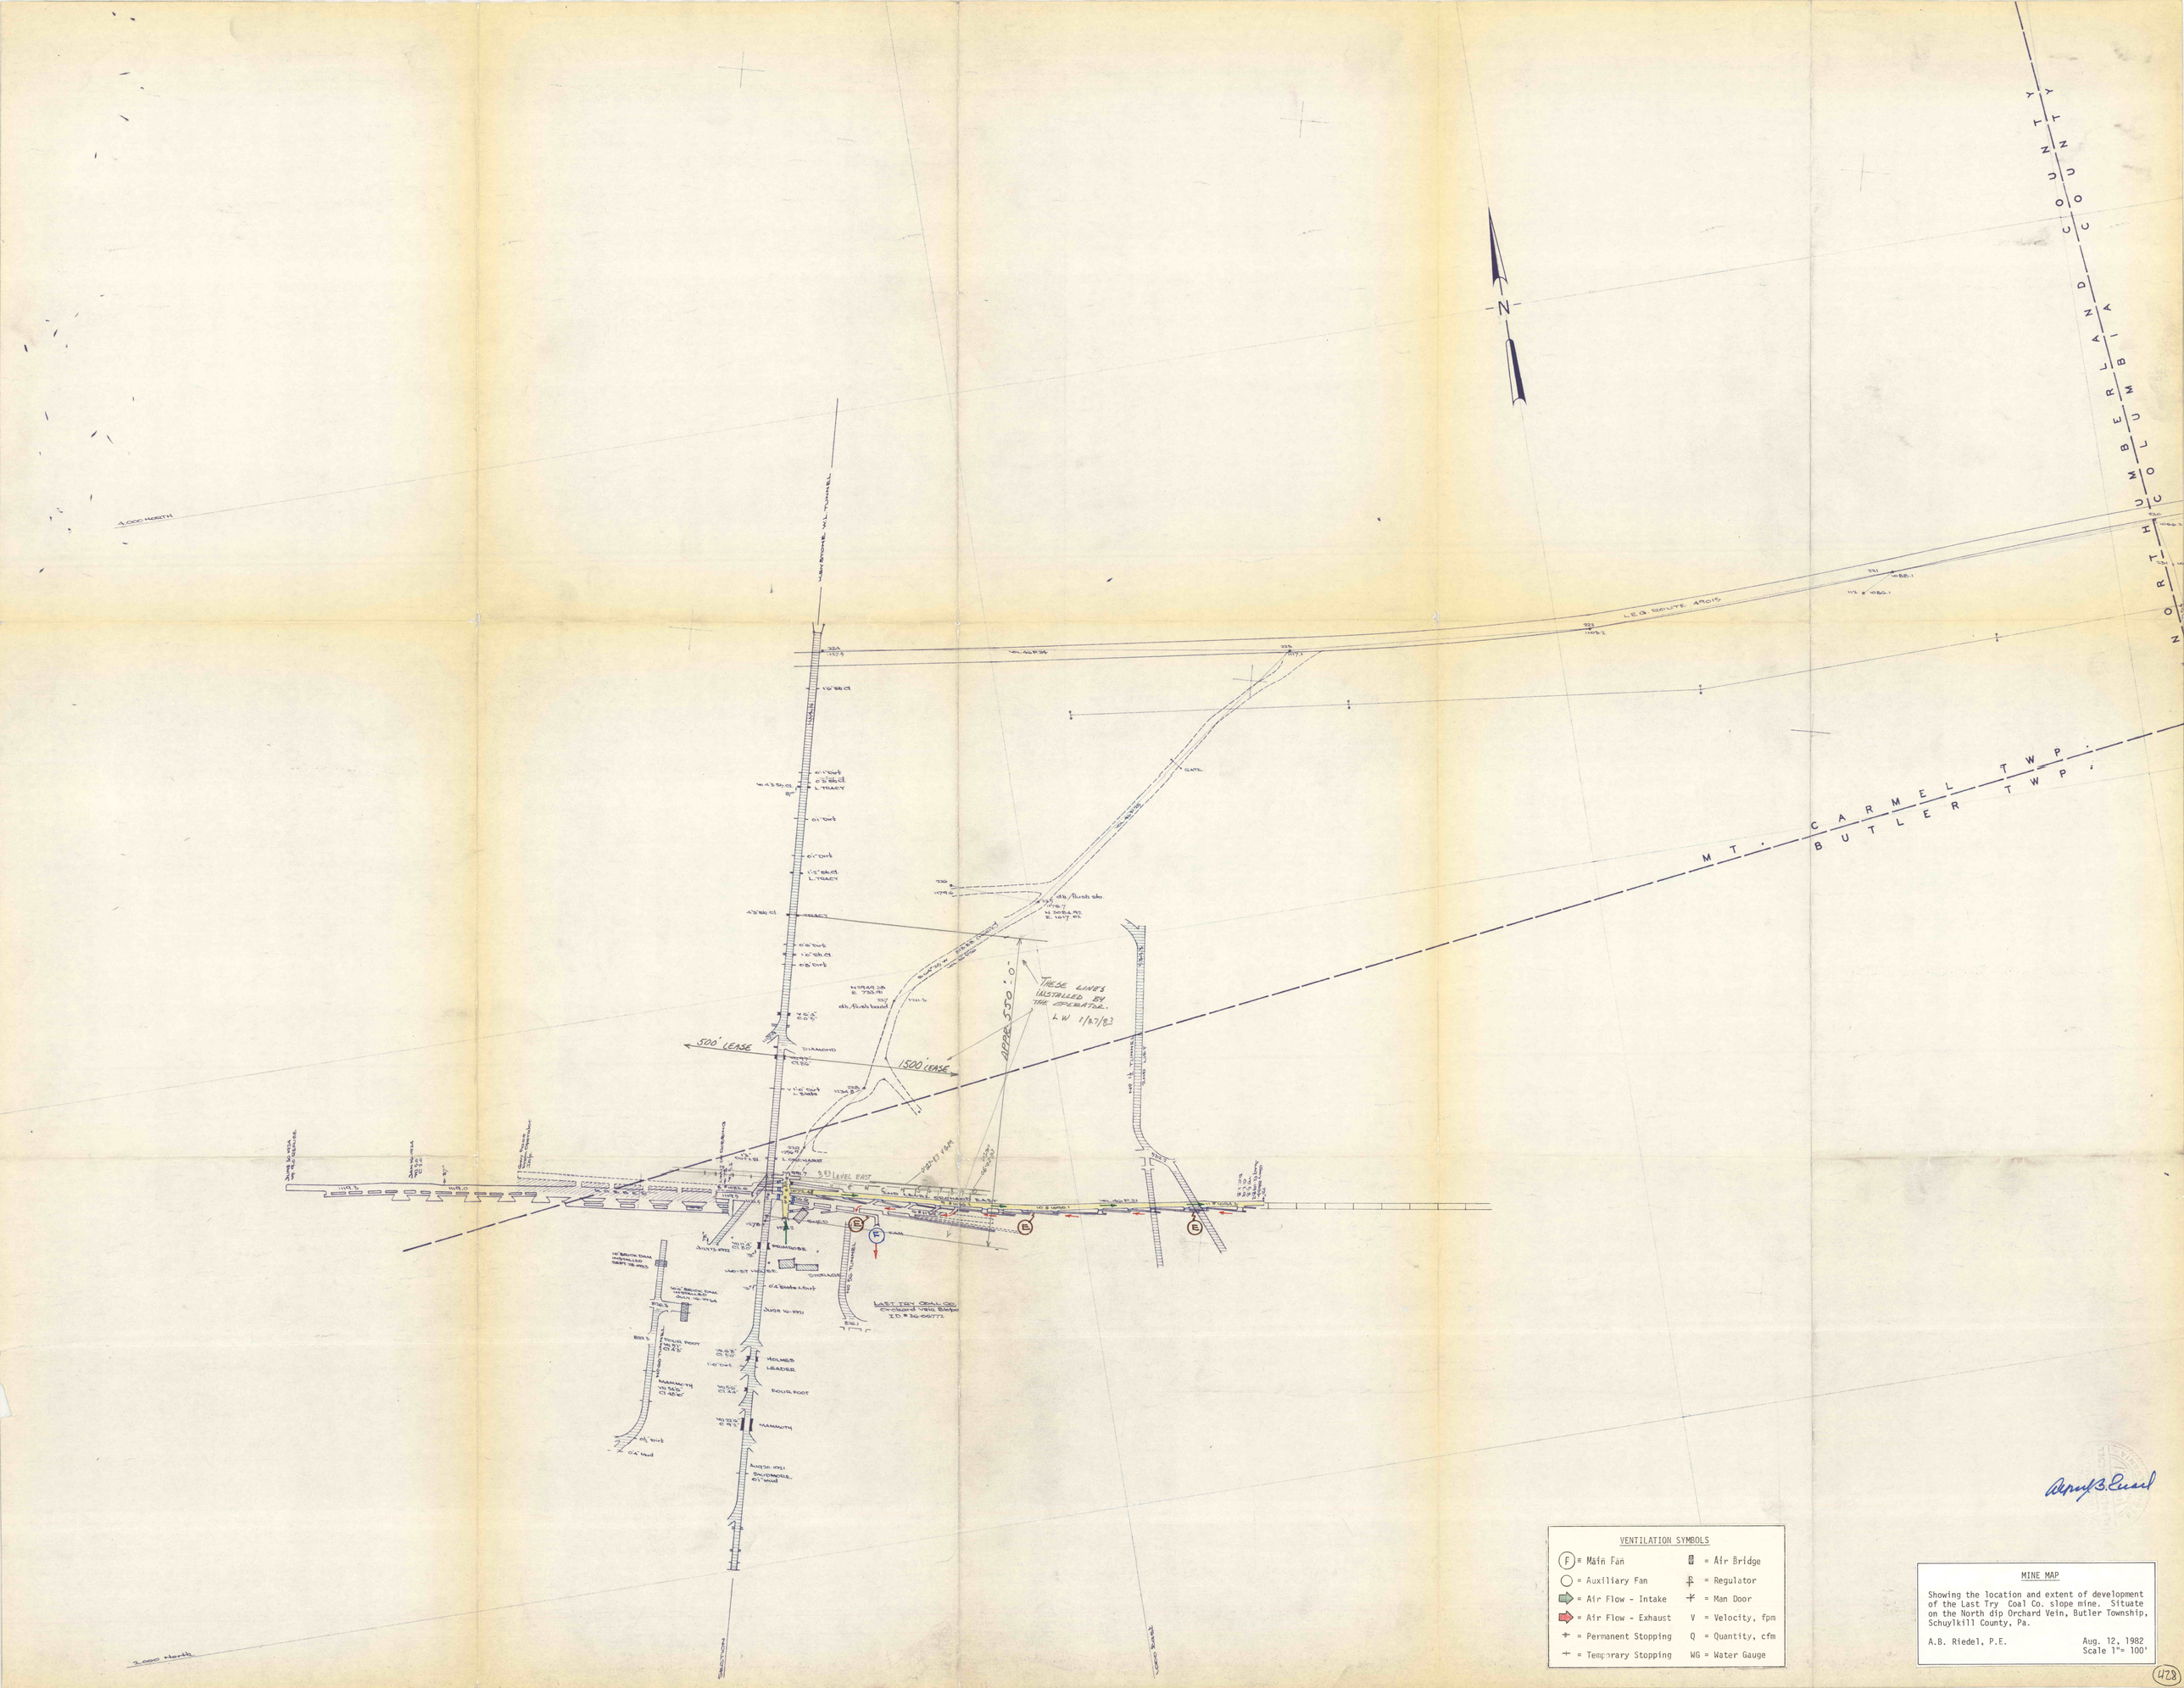
N
LEA ROUTE 49015
MT. CARMEL TWP.
BUTLER TWP.
NORTHUMBERLAND COUNTY
500' LEASE
1500' LEASE
APPR. 550'-0"
THESE LINES INSTALLED BY THE OPERATOR. L.W. 1/27/83
LEVEL EAST
DIAMOND
LEATHY COAL CO.
ID # 36-06772
VENTILATION SYMBOLS
F = Main Fan
= Auxiliary Fan
= Air Flow - Intake
= Air Flow - Exhaust
= Permanent Stopping
= Temporary Stopping
= Air Bridge
= Regulator
= Man Door
V = Velocity, fpm
Q = Quantity, cfm
WG = Water Gauge
MINE MAP
Showing the location and extent of development of the Last Try Coal Co. slope mine. Situate on the North dip Orchard Vein, Butler Township, Schuylkill County, Pa.
A.B. Riedel, P.E.
Aug. 12, 1982
Scale 1"= 100'