


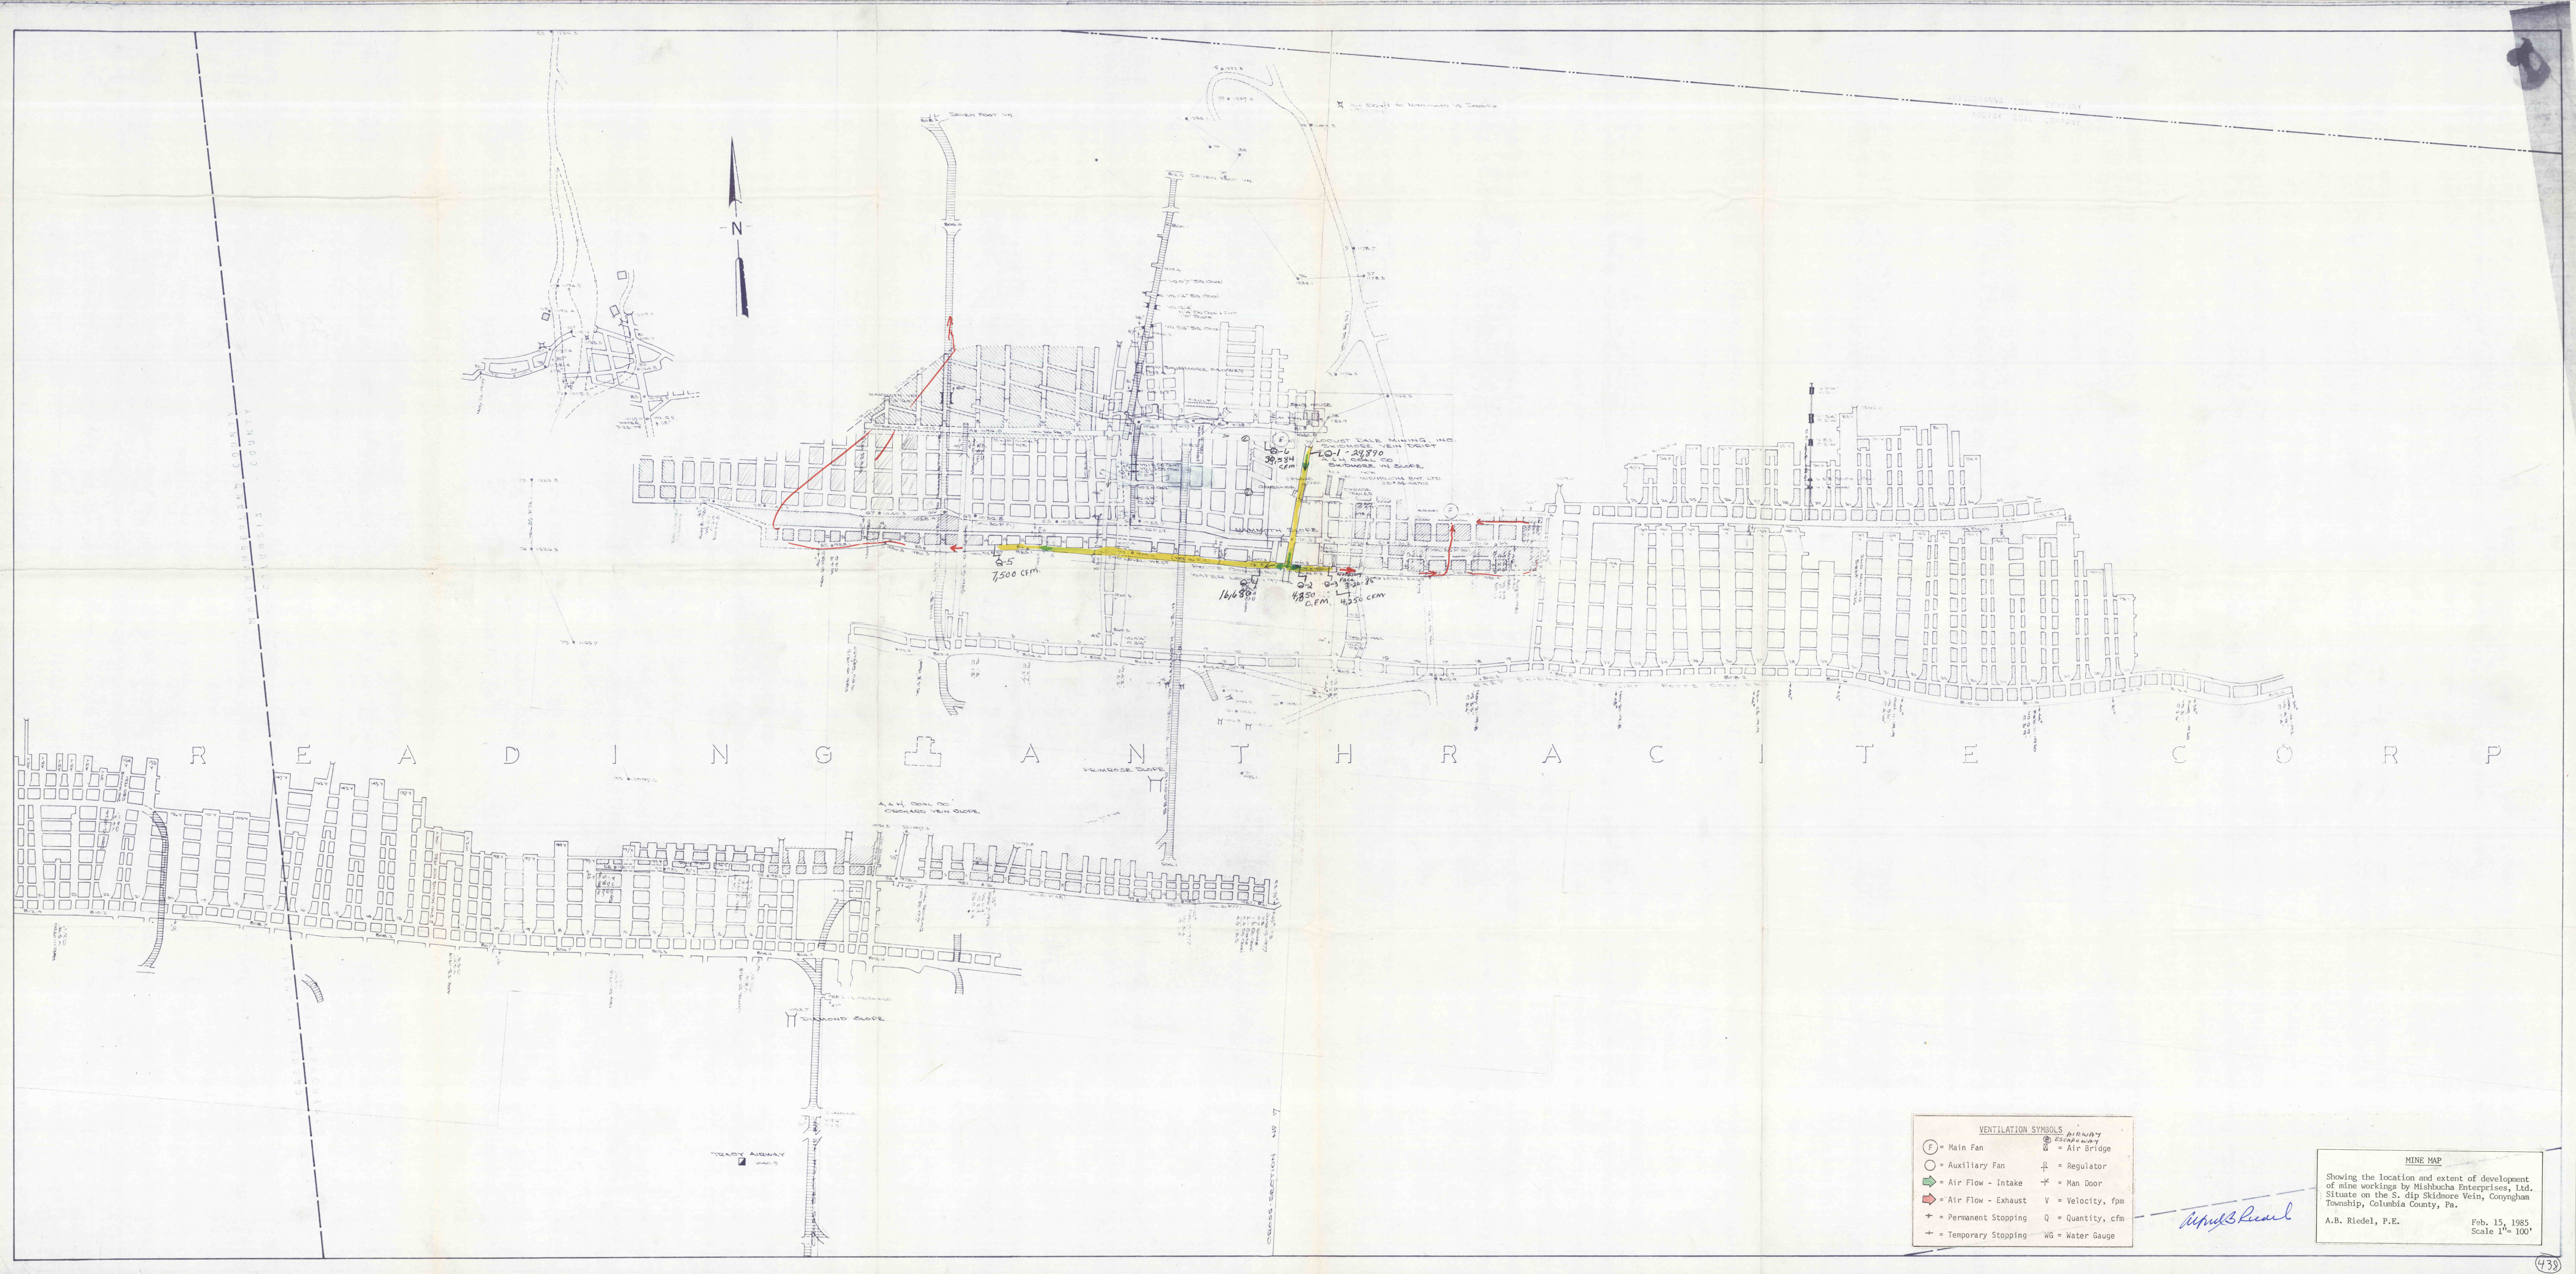

VENTILATION SYMBOLS	
(F) = Main Fan	(A) = Airway
(O) = Auxiliary Fan	(B) = Air Bridge
(I) = Air Flow - Intake	(R) = Regulator
(E) = Air Flow - Exhaust	(M) = Man Door
(P) = Permanent Stopping	(V) = Velocity, fpm
(T) = Temporary Stopping	(Q) = Quantity, cfm
	(WG) = Water Gauge

MINE MAP
Showing the location and extent of development of mine workings by Mishbucha Enterprises, Ltd. Situate on the S. dip Skidmore Vein, Conyngham Township, Columbia County, Pa.
A.B. Riedel, P.E. Feb. 15, 1985
Scale 1"= 100'