


SUSQUEHANNA COAL COMPANY
KODIAK COAL COMPANY

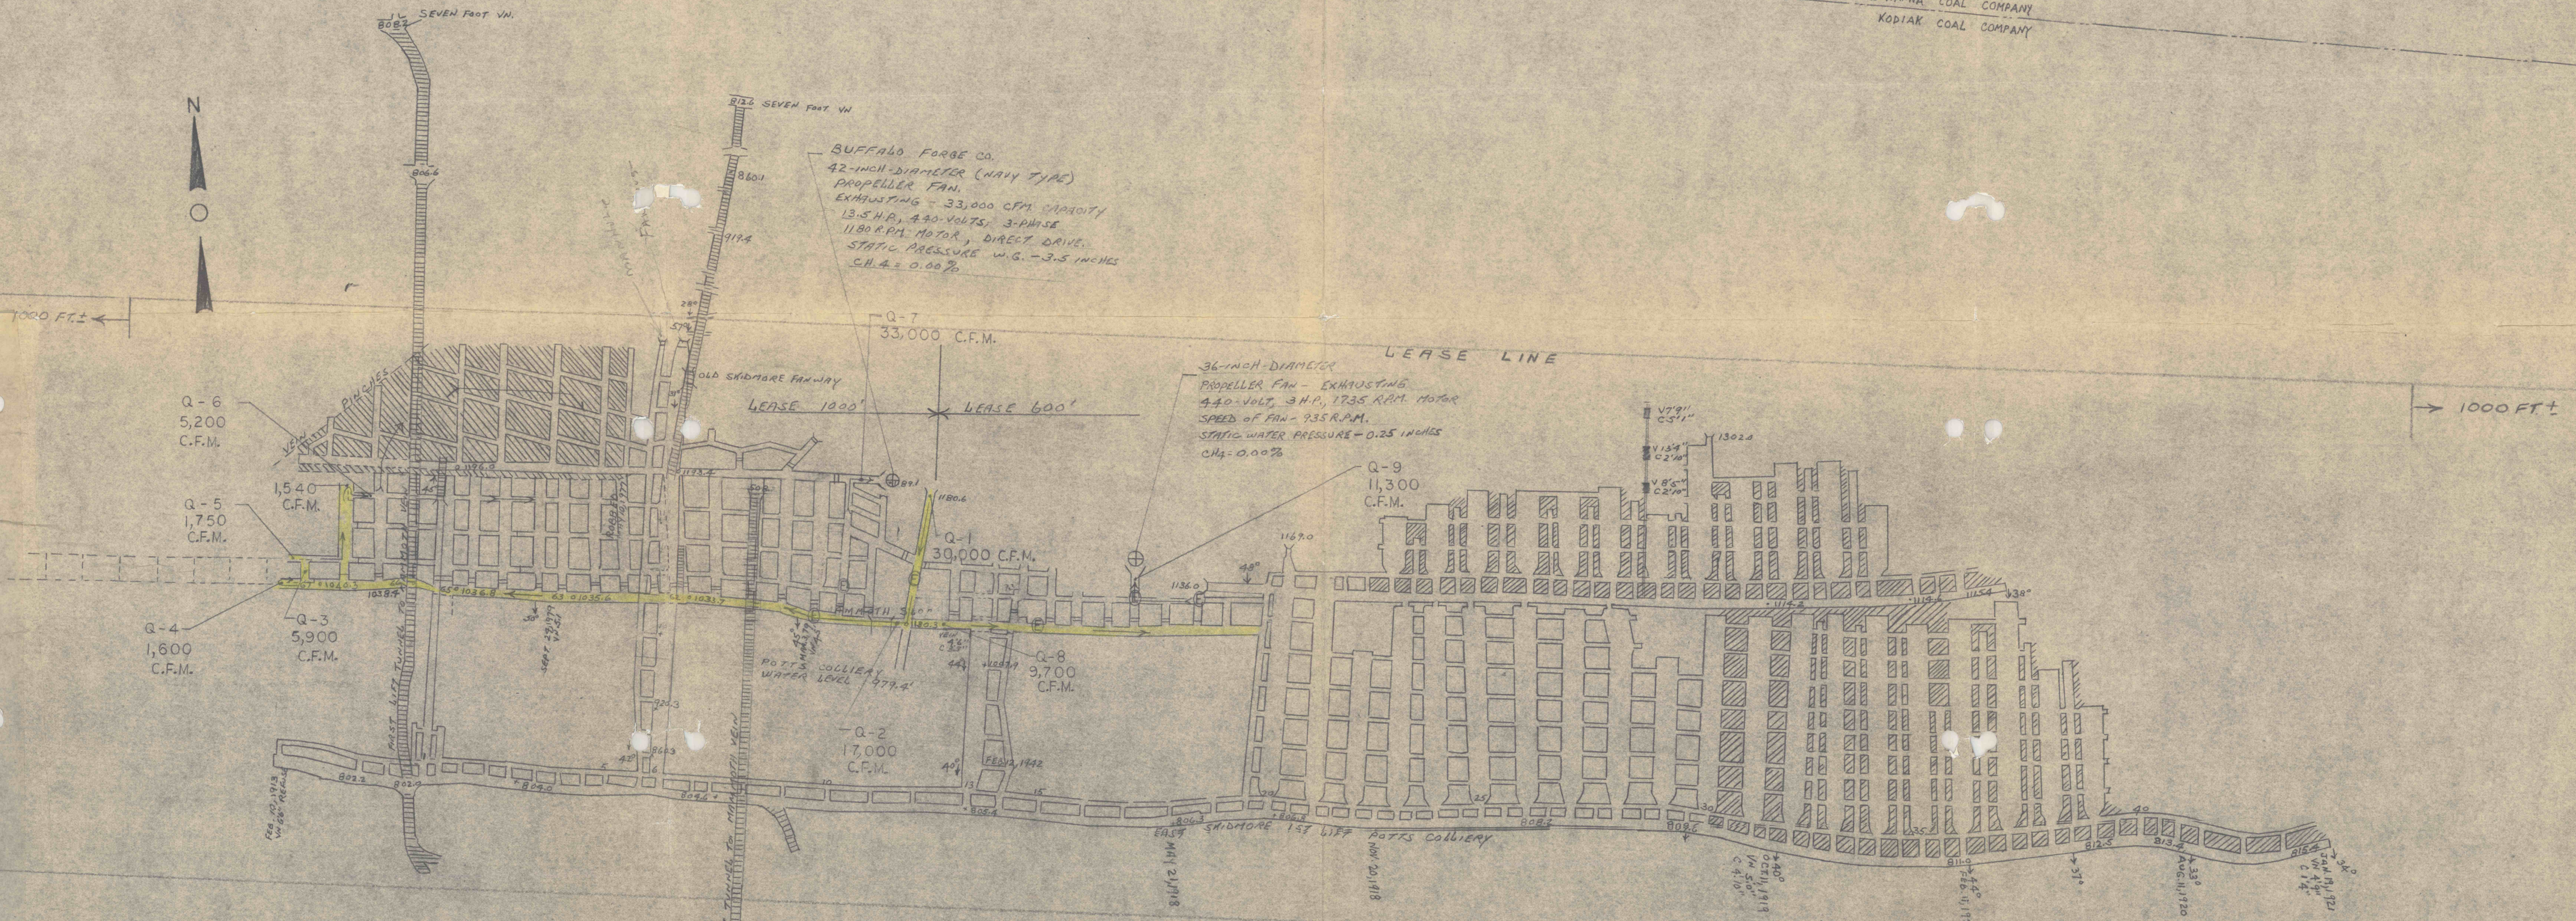

- LEGEND
- Y MINE OPENING
 - ⊕ MAIN FAN
 - INTAKE AIR
 - RETURN AIR
 - I TEMPORARY STOPPING
 - II PERMANENT STOPPING
 - Q AIR MEASUREMENT LOCATION
 - LINE BRATTICE
 - BAZOOKA WITH TUBING
 - ⊕ ESCAPEWAY
- ACTIVE WORKINGS DELINEATED IN YELLOW.

SKIDMORE SLOPE
I.D. NO. 36-04702
A. AND H. COAL COMPANY
LOCUST DALE, COLUMBIA COUNTY, PA.
SKIDMORE VEIN
SCALE - 1" = 100'
DATE - APRIL 9, 1931

A MINIMUM QUANTITY OF 1500 CFM. WILL BE MAINTAINED AT EACH WORKING FACE
A MINIMUM QUANTITY OF 5000 CFM. WILL BE MAINTAINED AT THE LAST OPEN CROSSCUT
A MINIMUM QUANTITY OF 5000 CFM. WILL BE MAINTAINED AT THE INTAKE END OF PULVER LINE.
LINE BRATTICE OR VENTILATION TUBING WILL BE MAINTAINED WITHIN 20 FEET OF EACH WORKING FACE.

COLUMBIA COUNTY
SCHUYLKILL COUNTY
CONYNGHAM TOWNSHIP
BUTLER TOWNSHIP

A. AND H. COAL COMPANY