
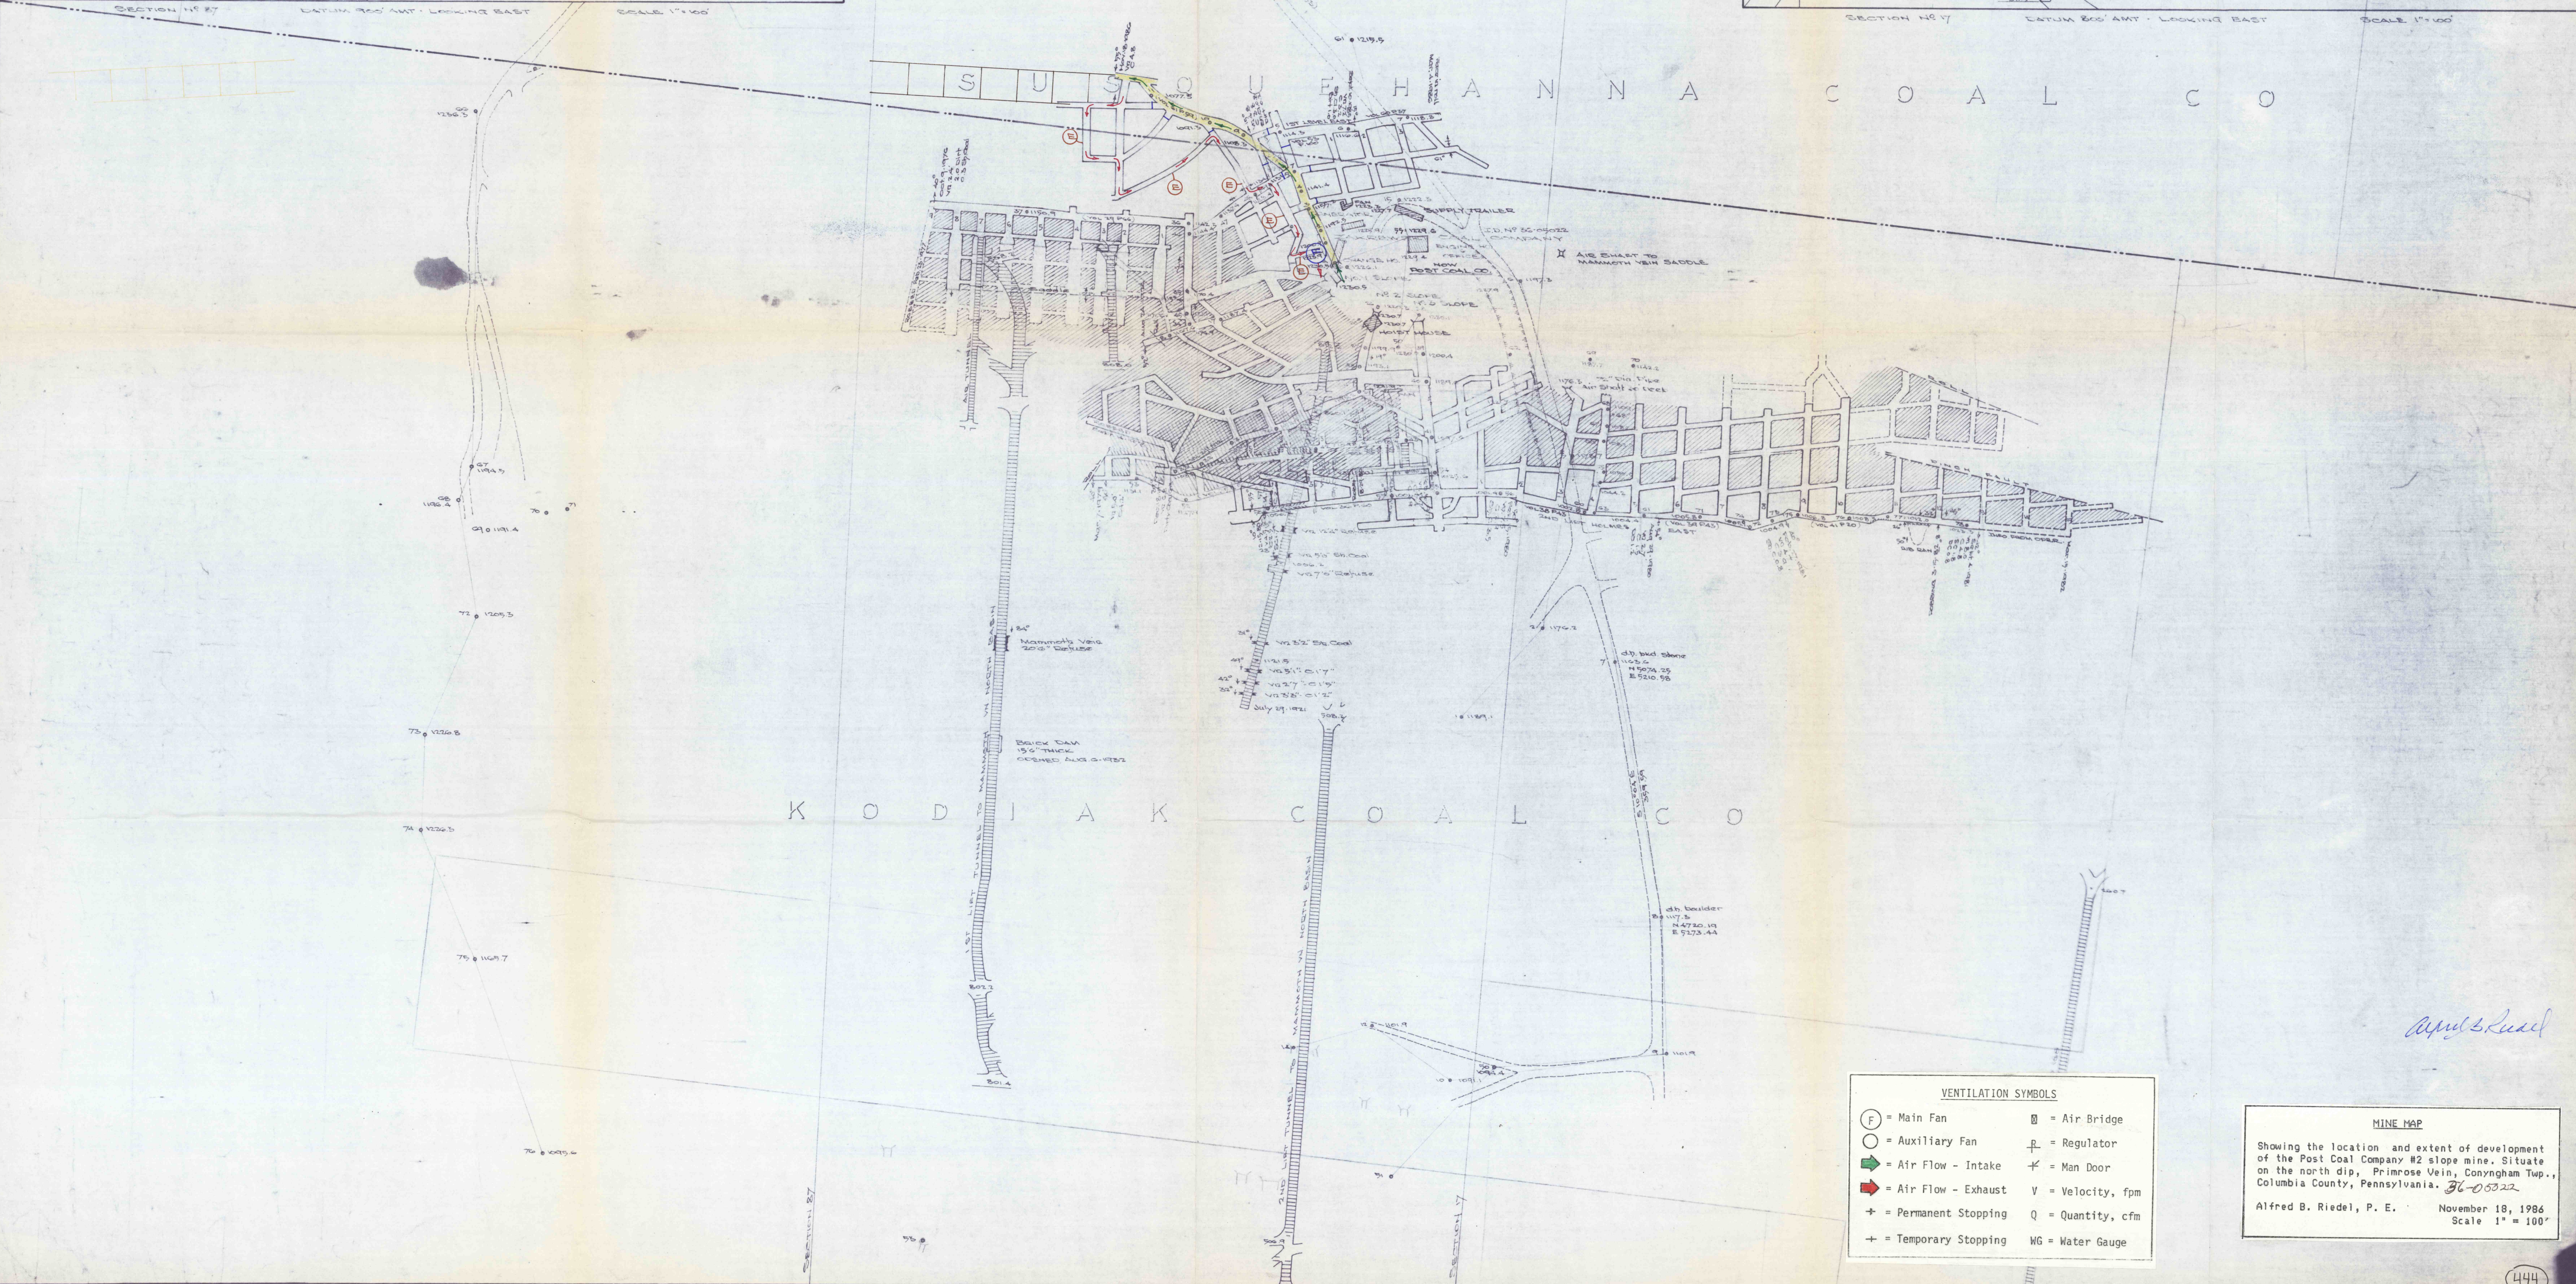
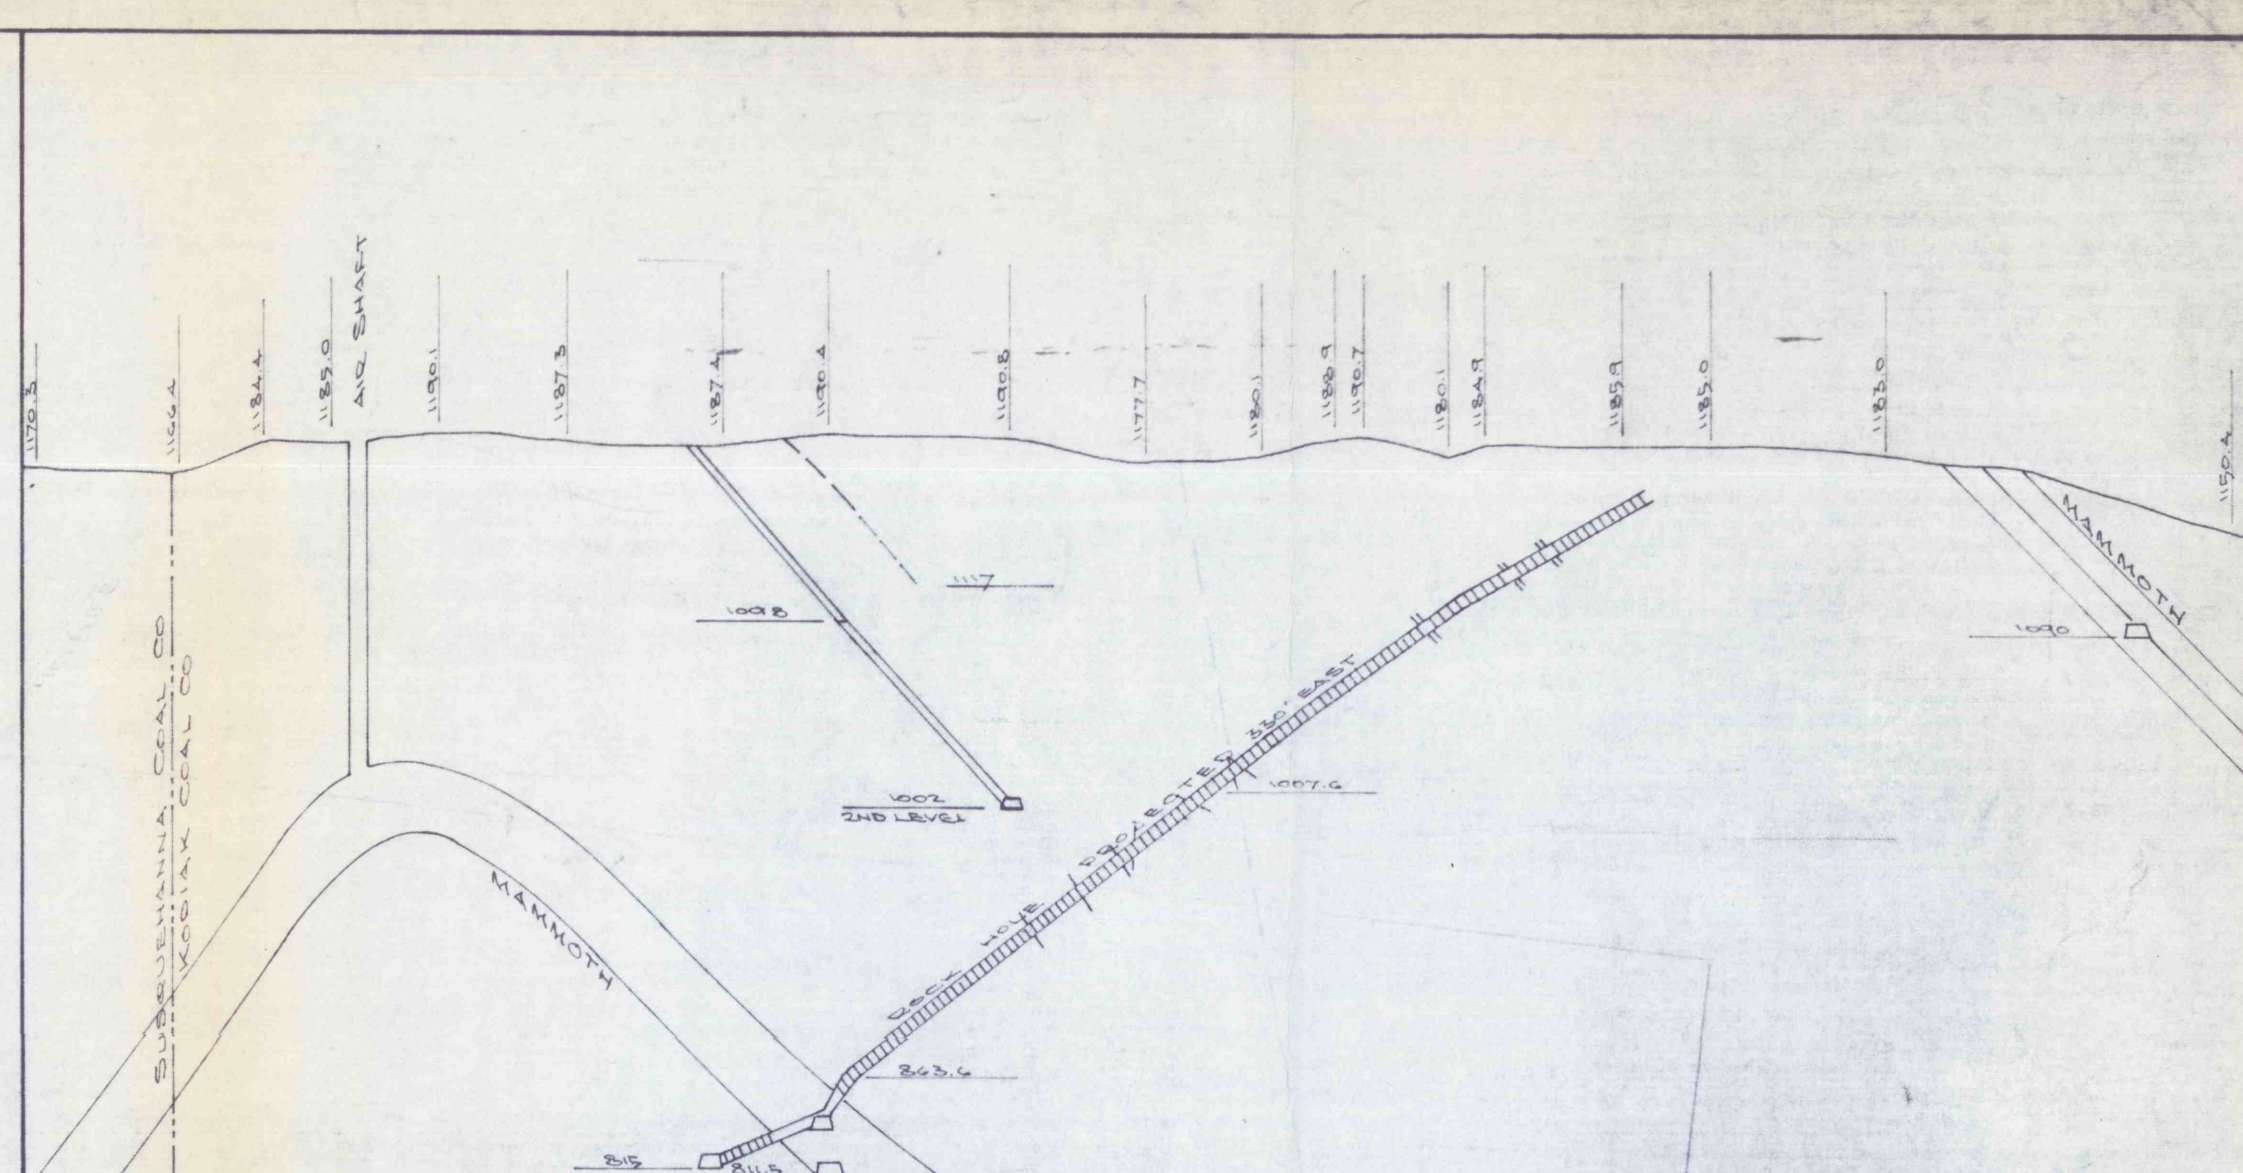


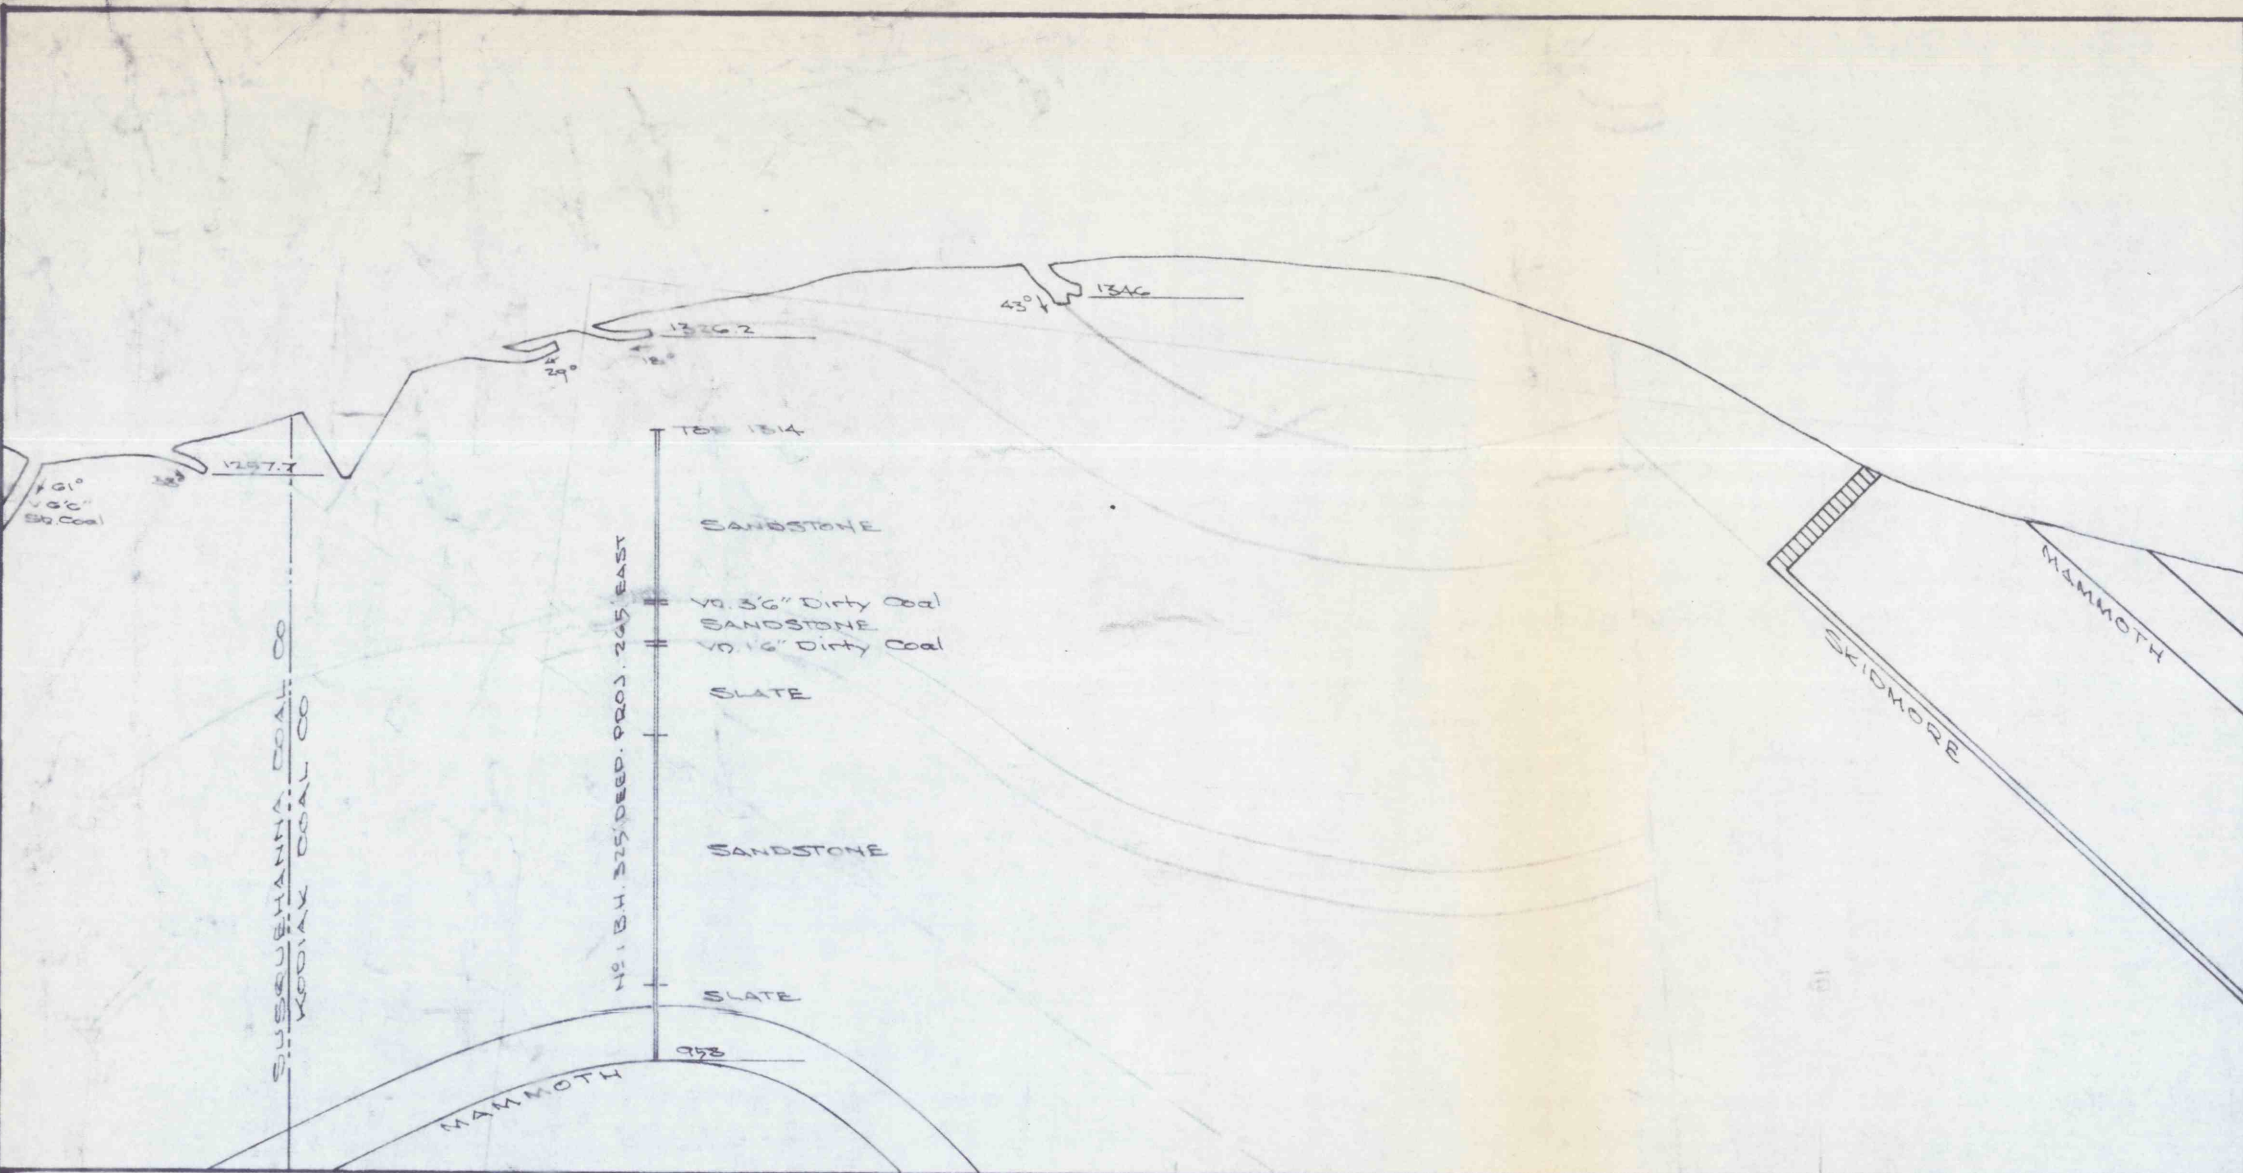

VENTILATION SYMBOLS	
(F) = Main Fan	⊠ = Air Bridge
○ = Auxiliary Fan	⊥ = Regulator
→ = Air Flow - Intake	⊕ = Man Door
↔ = Air Flow - Exhaust	V = Velocity, fpm
+ = Permanent Stopping	Q = Quantity, cfm
⊕ = Temporary Stopping	WG = Water Gauge

MINE MAP
 Showing the location and extent of development of the Post Coal Company #2 slope mine. Situate on the north dip, Primrose Vein, Conyngham Twp., Columbia County, Pennsylvania. *36-0522*
 Alfred B. Riedel, P. E. November 18, 1986
 Scale 1" = 100'