



1 1/2 MI. TO CENTRALIA

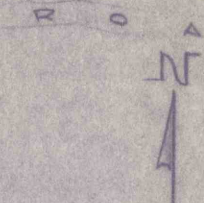

PLAN OF SURFACE

2000' LEASE 2000' LEASE

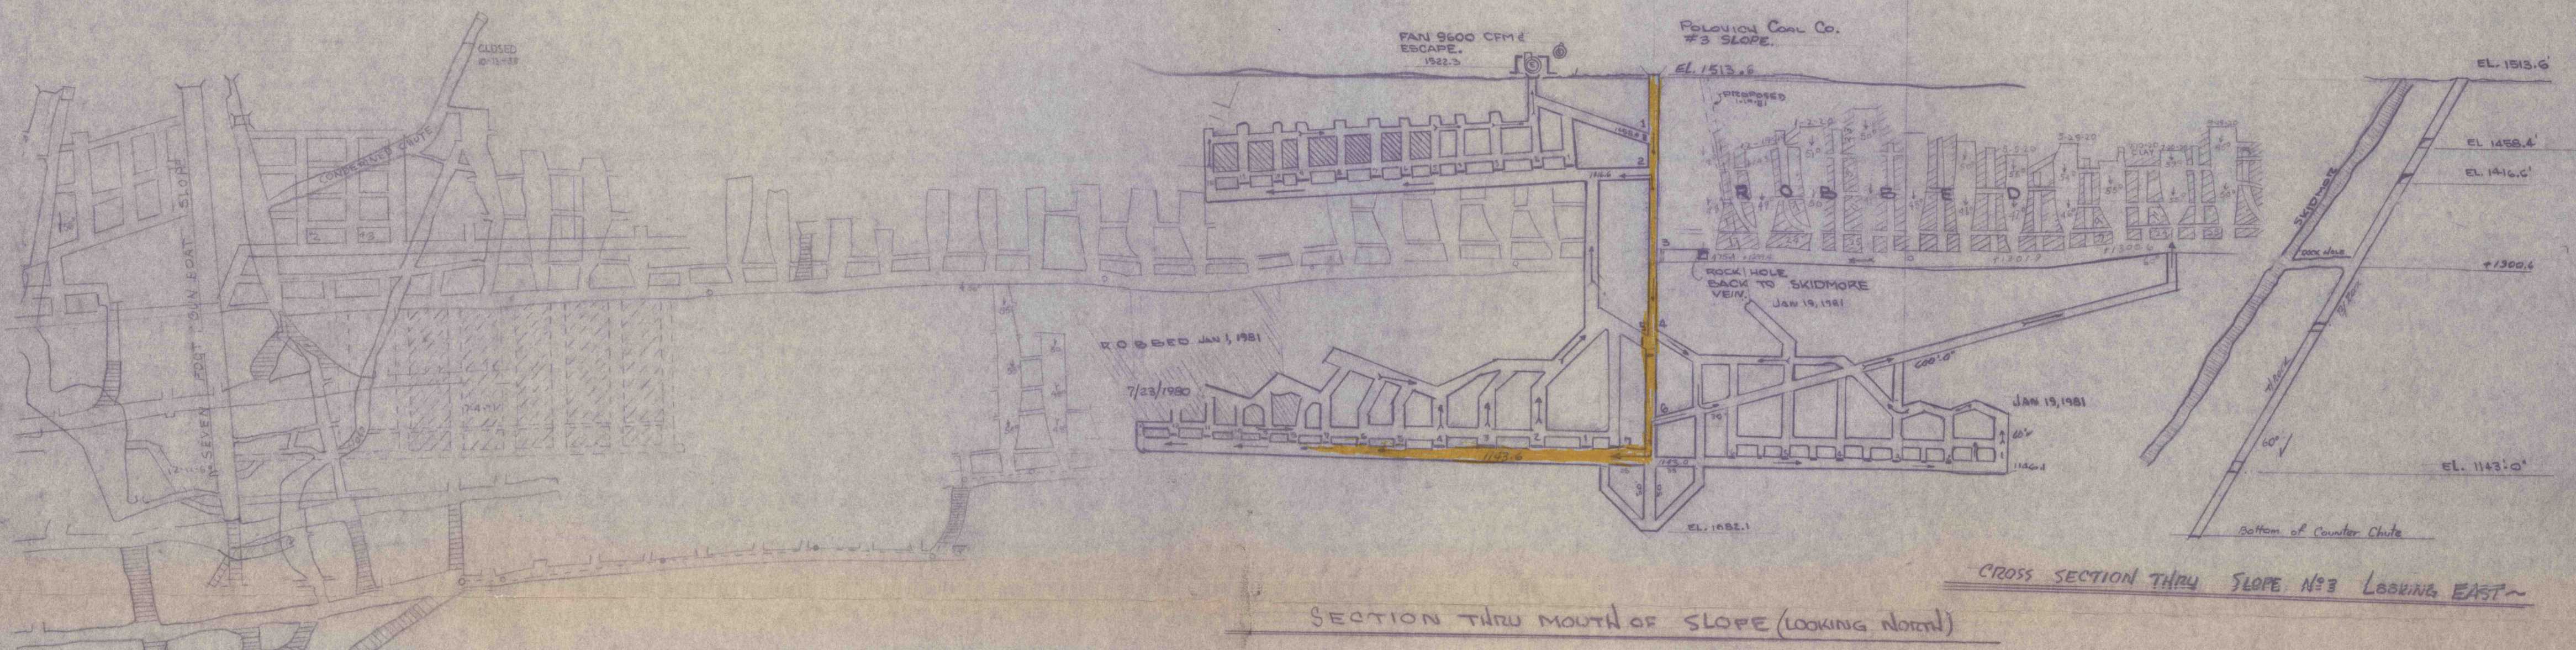

SECTION THRU MOUTH OF SLOPE (LOOKING NORTH)

CROSS SECTION THRU SLOPE NO. 3 LOOKING EAST

LEGEND

- MAIN FAN
- INTAKE AIR
- RETURN AIR
- PERMANENT STOPPING
- TEMPORARY STOPPING
- BRATTICE
- ESCAPEWAY RETURN AIR
- ESCAPEWAY INTAKE AIR



Michael F. Catino
7-27-81

36-06459
POLKOVICH COAL CO.
SEVEN FOOT #3 SLOPE
CENTRALIA, PA.

SCALE 1"=100'