


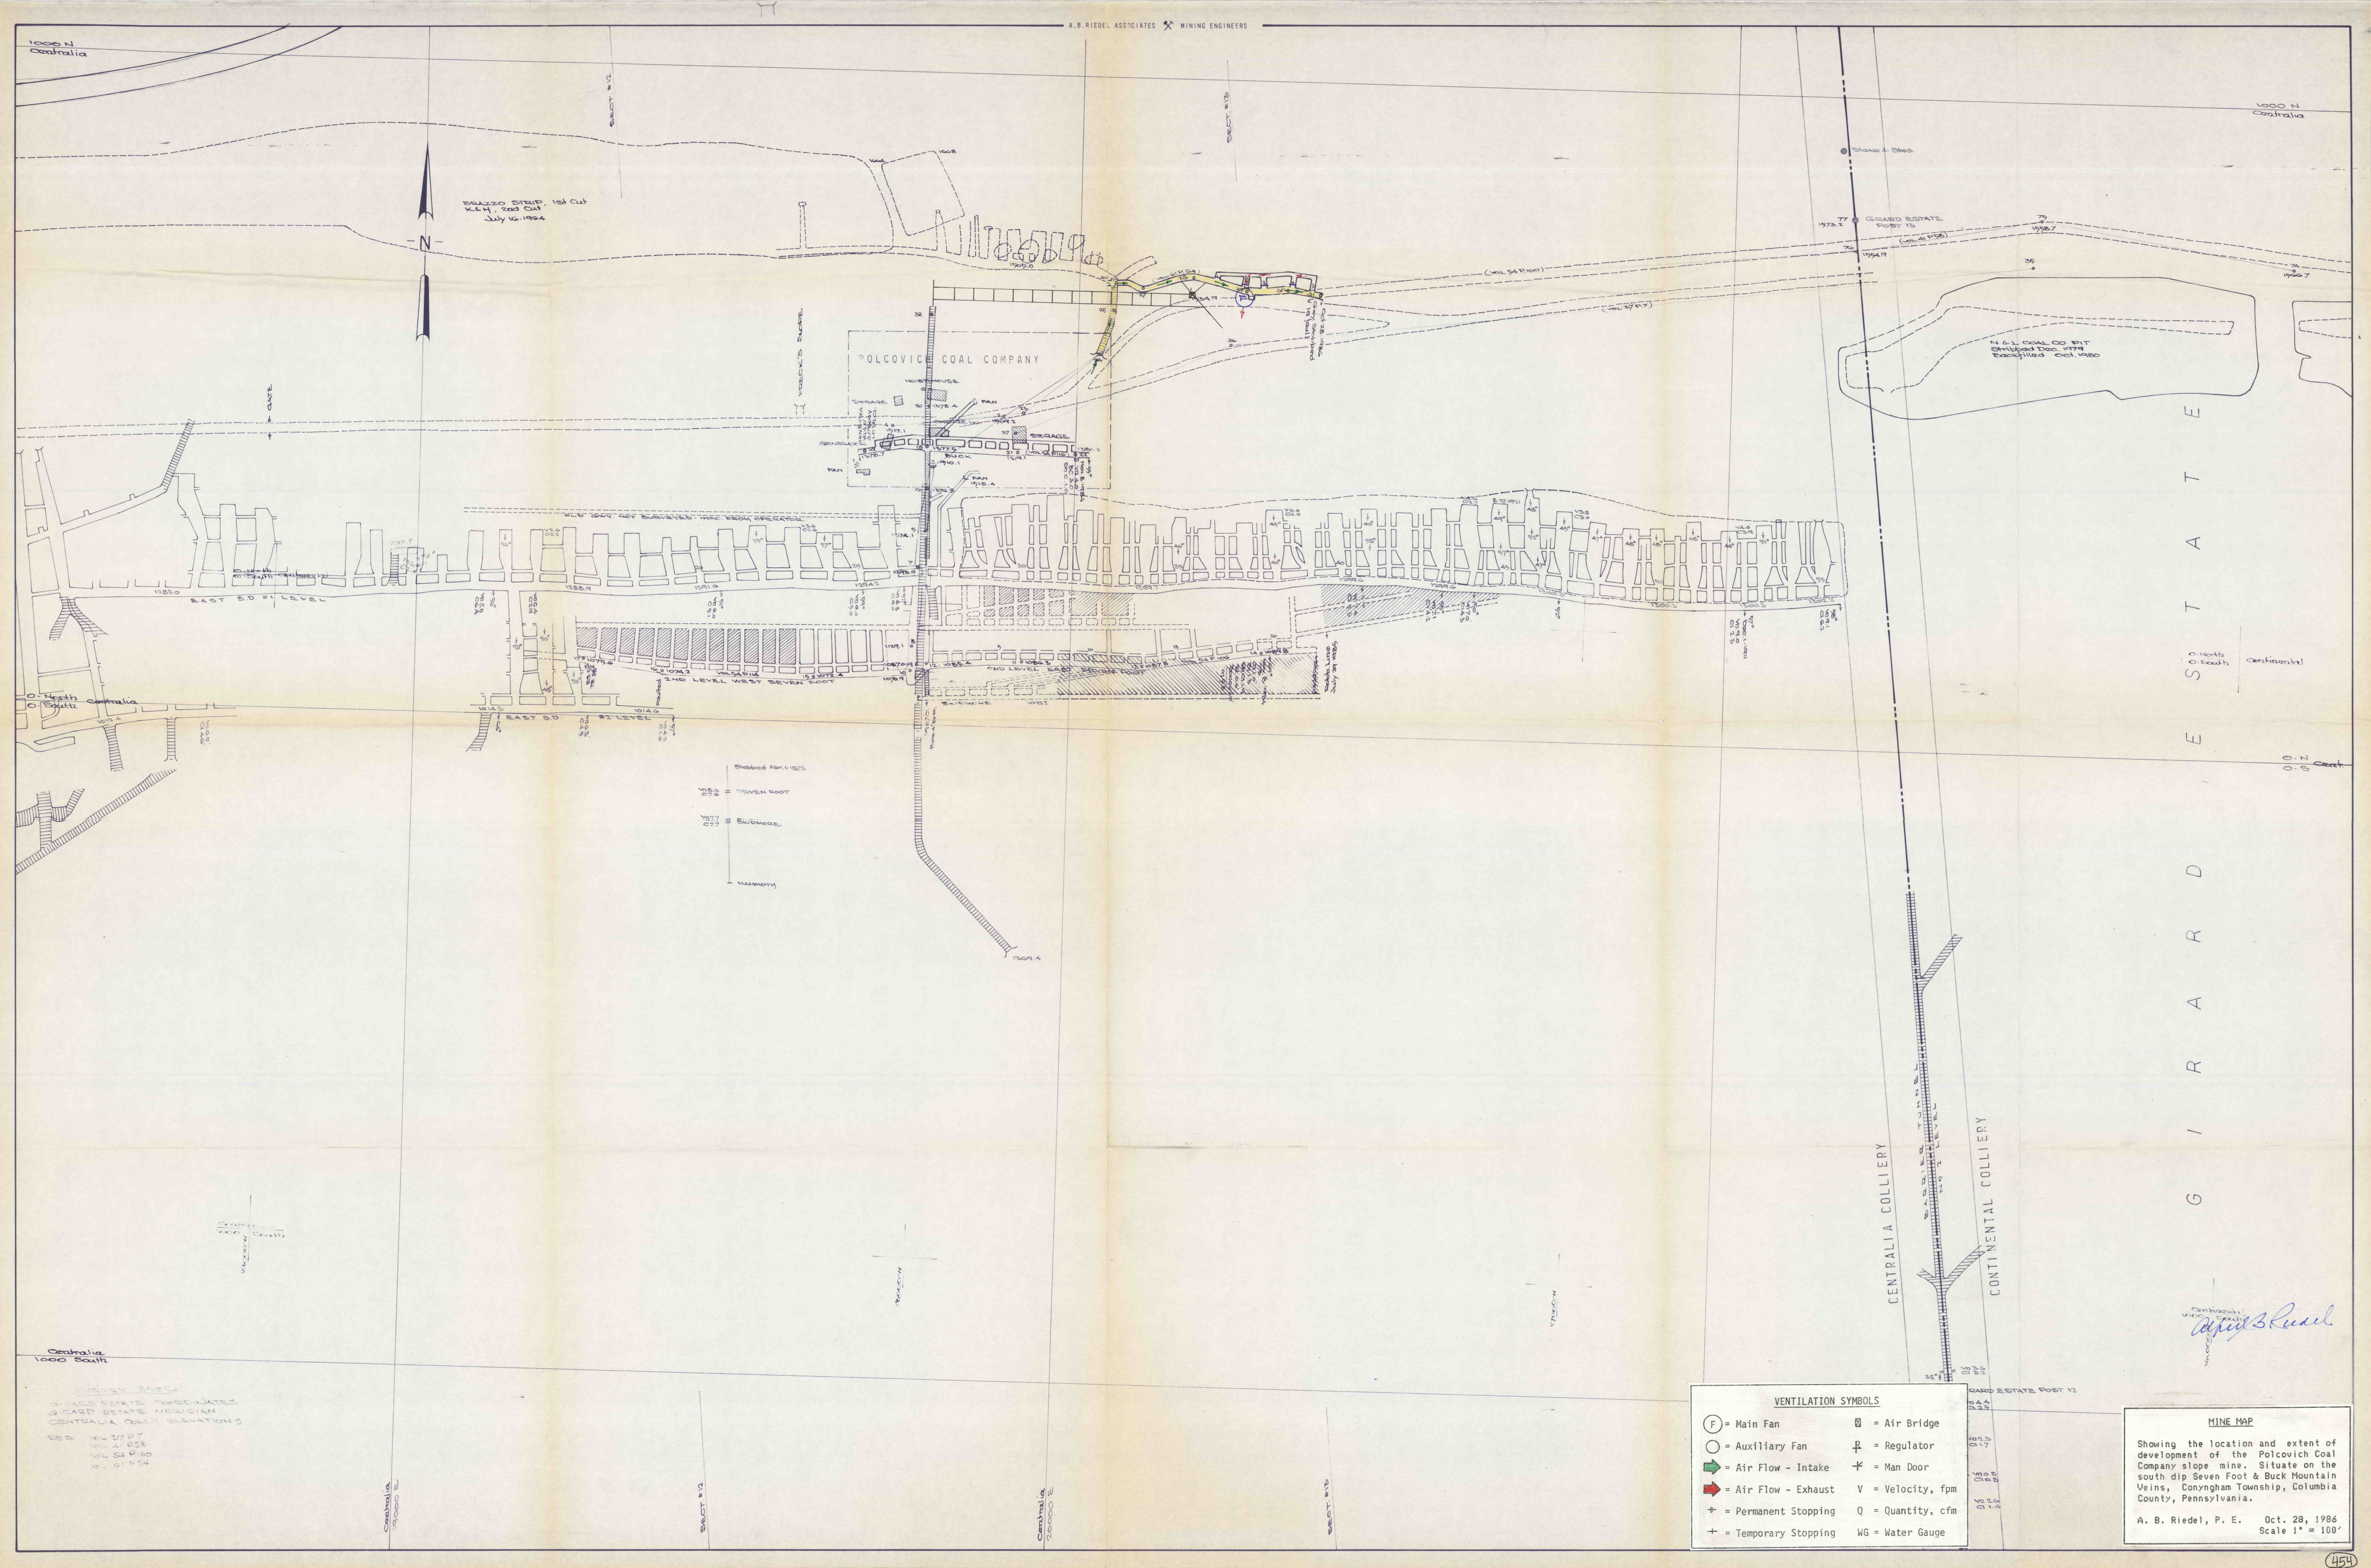

1000 N
Centralia

1000 N
Centralia

0 North
0 South
Centralia

Centralia
1000 South

SURVEY DATA
G.I.R.A.R.D. COORDINATES
G.I.R.A.R.D. MERIDIAN
CENTRALIA COLLYERY ELEVATIONS
C.E. VOL 57 P.7
VOL 1, 1988
VOL 51 P.100
VOL 51 P.54

Centralia
1000 E

SECT. #12

Centralia
2000 E

SECT. #15

VENTILATION SYMBOLS			
(F) = Main Fan	(V) = Air Bridge	(R) = Regulator	(M) = Man Door
(A) = Auxiliary Fan	(I) = Air Flow - Intake	(E) = Air Flow - Exhaust	(V) = Velocity, fpm
(+)	(+)	(+)	(Q) = Quantity, cfm
(+)	(+)	(+)	(WG) = Water Gauge
(+)	(+)	(+)	(+)

MINE MAP
Showing the location and extent of development of the Polcovich Coal Company mine. Situate on the south dip Seven Foot & Buck Mountain Veins, Conyngham Township, Columbia County, Pennsylvania.
A. B. Riedel, P. E. Oct. 28, 1986
Scale 1" = 100'