



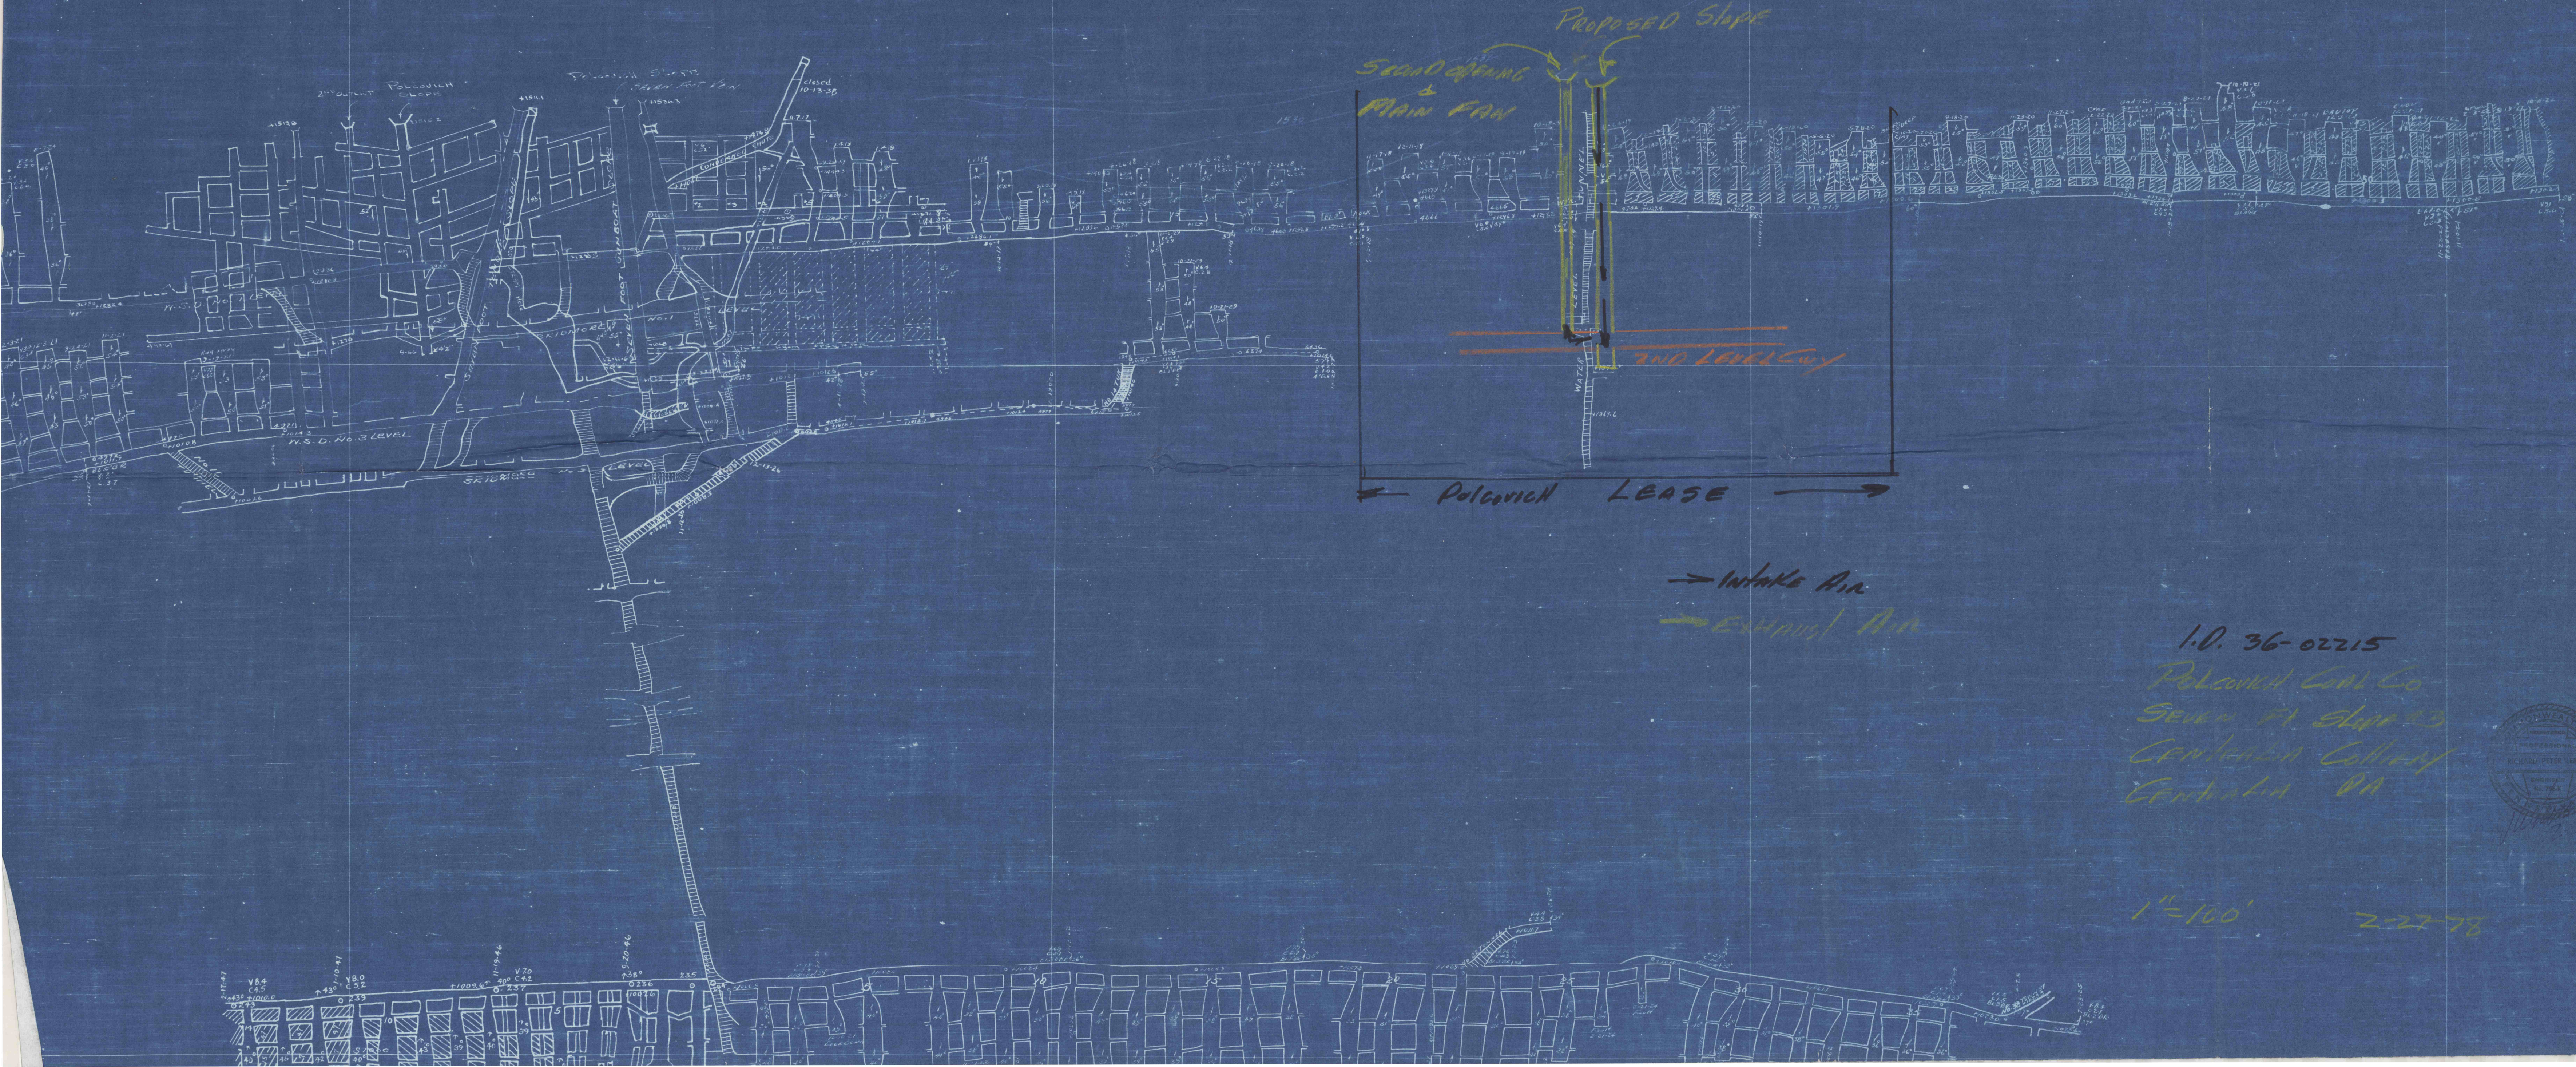

I.D. 36-02215  
 Polconich Coal Co.  
 CENTRALIA COLLIERY  
 CENTRALIA PA

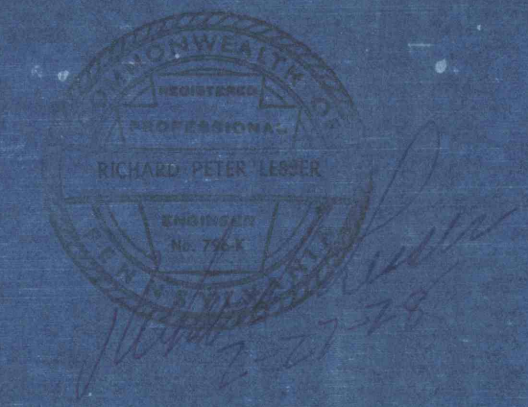

1"=100' 2-27-78