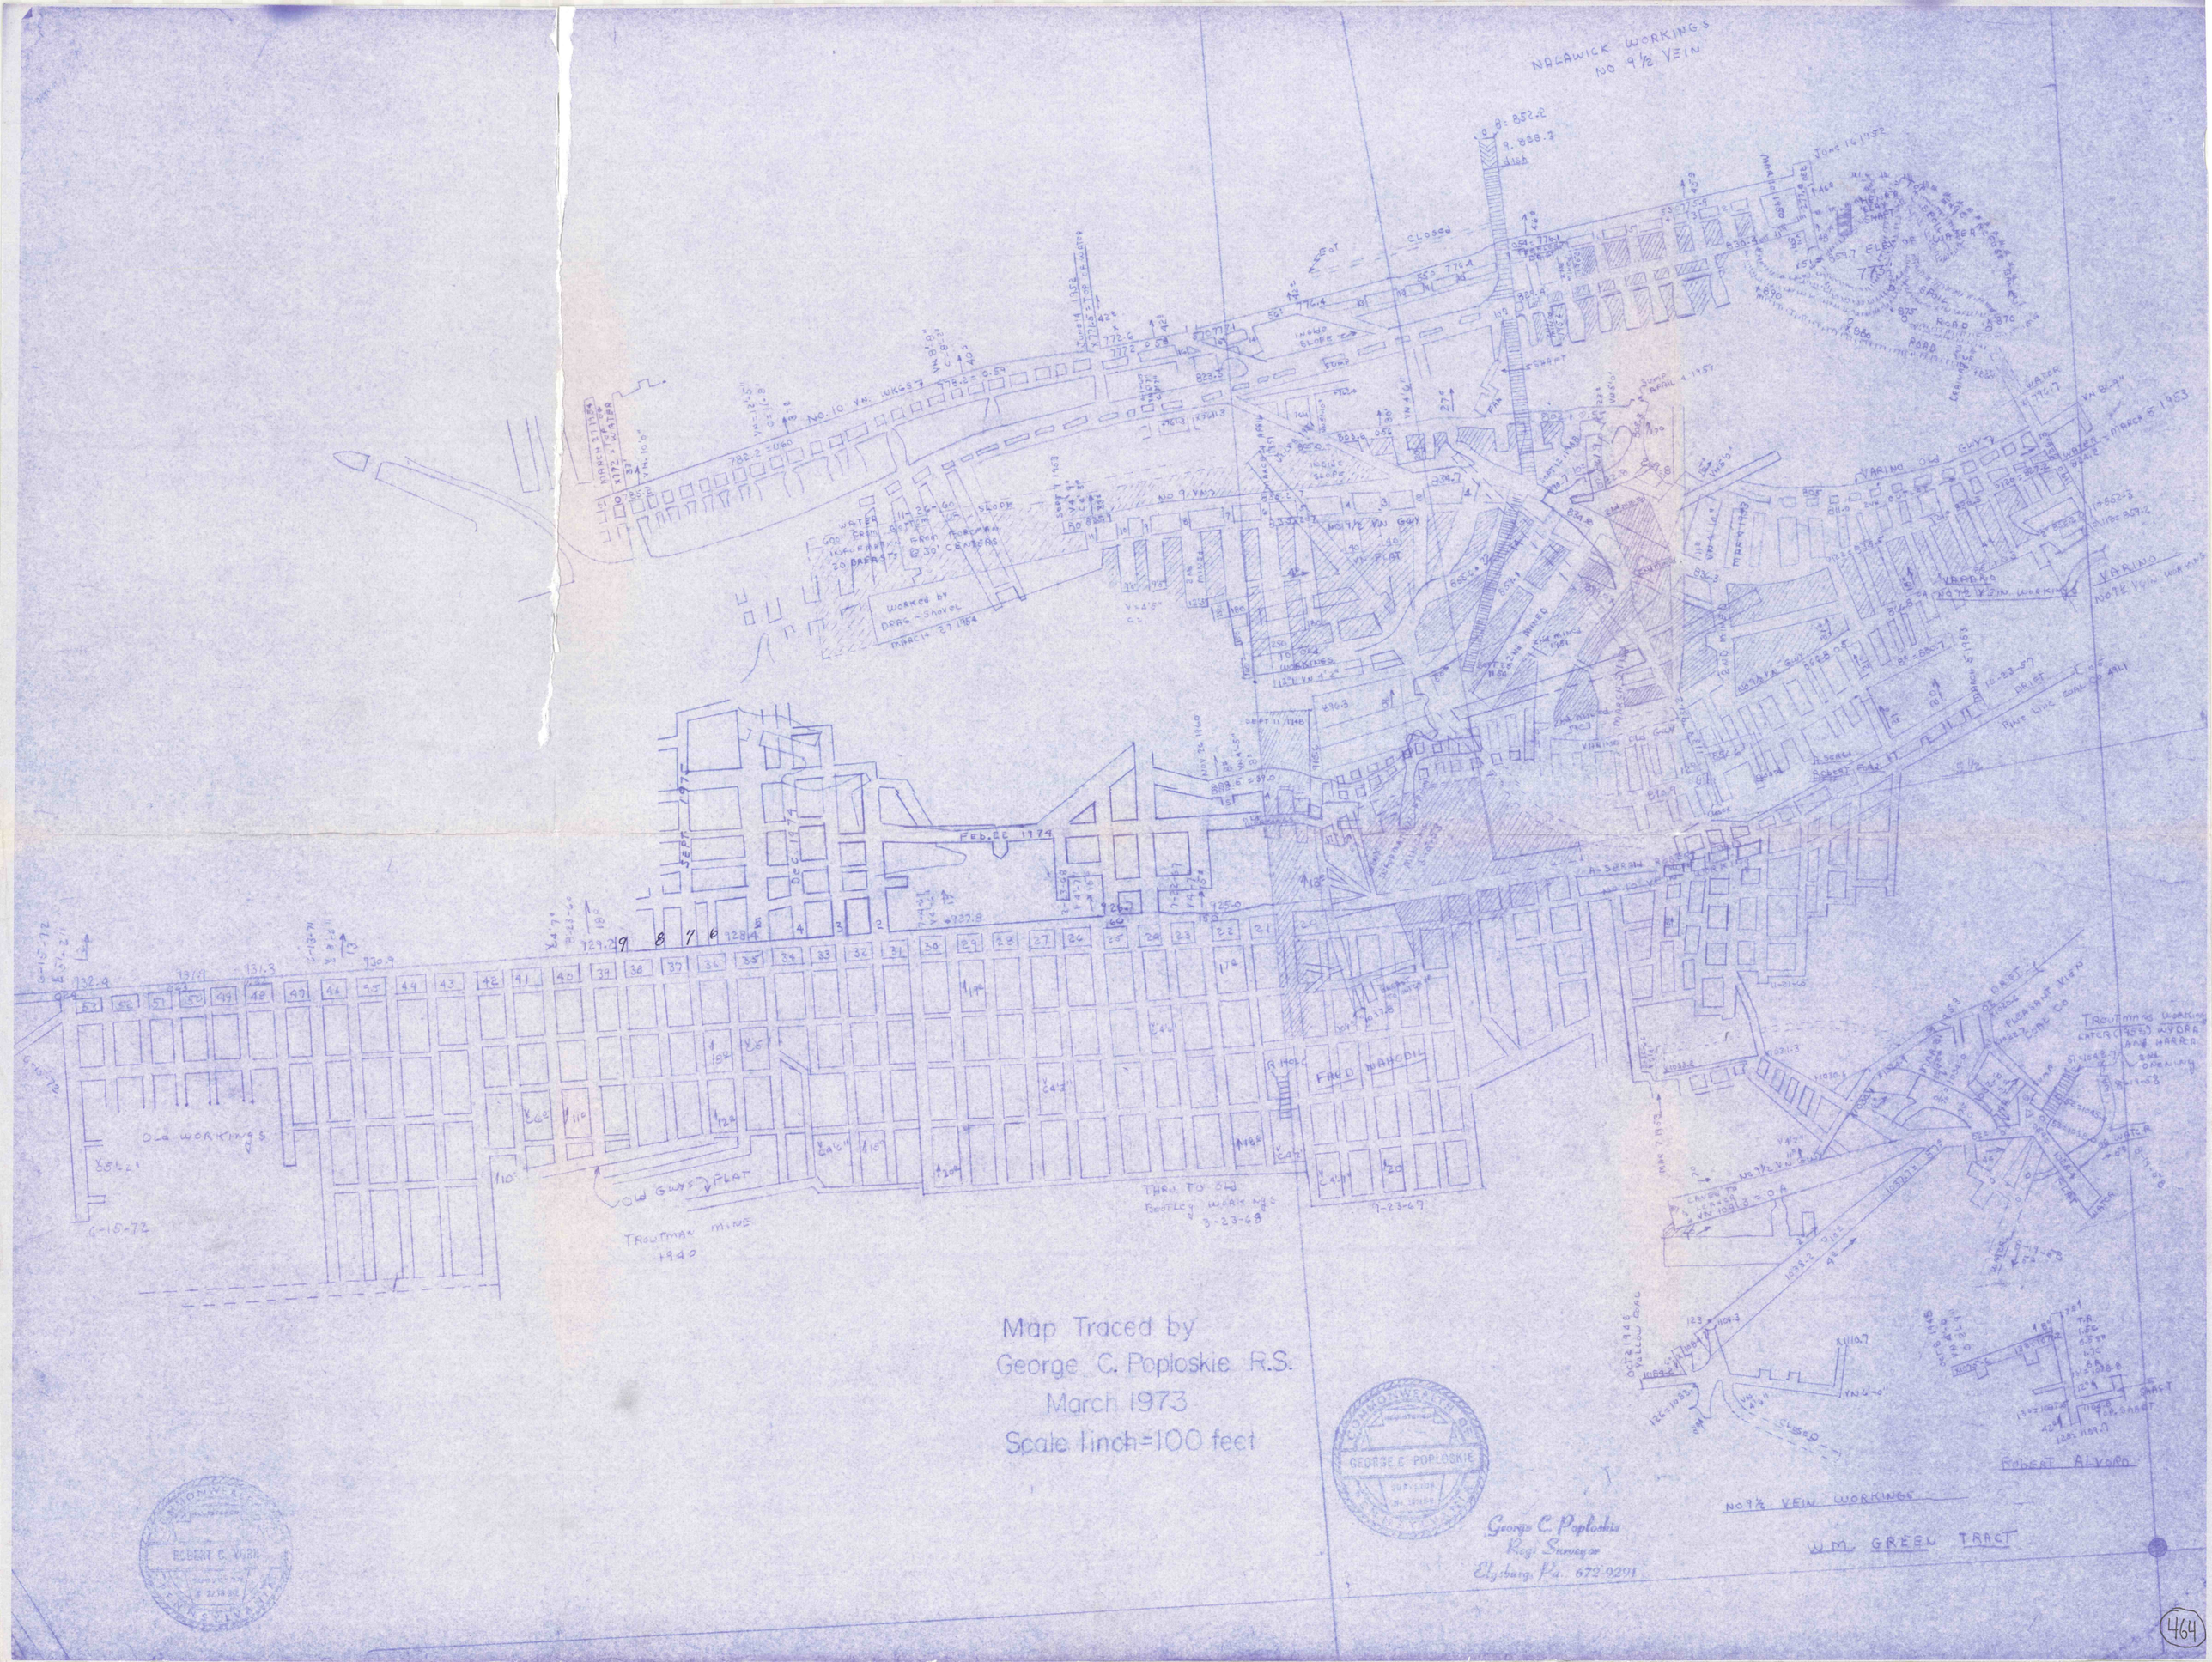
NALAWICK WORKINGS
NO 9½ VEIN
OLD WORKINGS
OLD GUYS FLAT
TROUTMAN MINE
1940
THRU TO OLD
BOOTLEY WORKINGS
3-23-68
FAUD NAHODIL
VARINO
NO 9½ VEIN WORKINGS
ROBERT ALVORD
NO 9½ VEIN WORKINGS
WM. GREEN TRACT
Map Traced by
George C. Poploskie R.S.
March 1973
Scale 1 inch=100 feet
George C. Poploskie
Reg. Surveyor
Elysburg, Pa. 672-9291
GEORGE C. POPLOSKIE
ROBERT C. VIRI