


PROPOSED NEW SLOPE
NEW-WAY COAL CO.
ORCHARD SLOPE
36-06696

LEASE 1000' LEASE 1000'

NEW WAY COAL CO.

PROPOSED SITE OF
4' DIAM. CENTRIFUGAL FAN
No name plate
will be powered by
20 H.P. 440 VOLT motor

Auxiliary Fan with 8" dia
Tubing will be used to
develop new haulage shaft

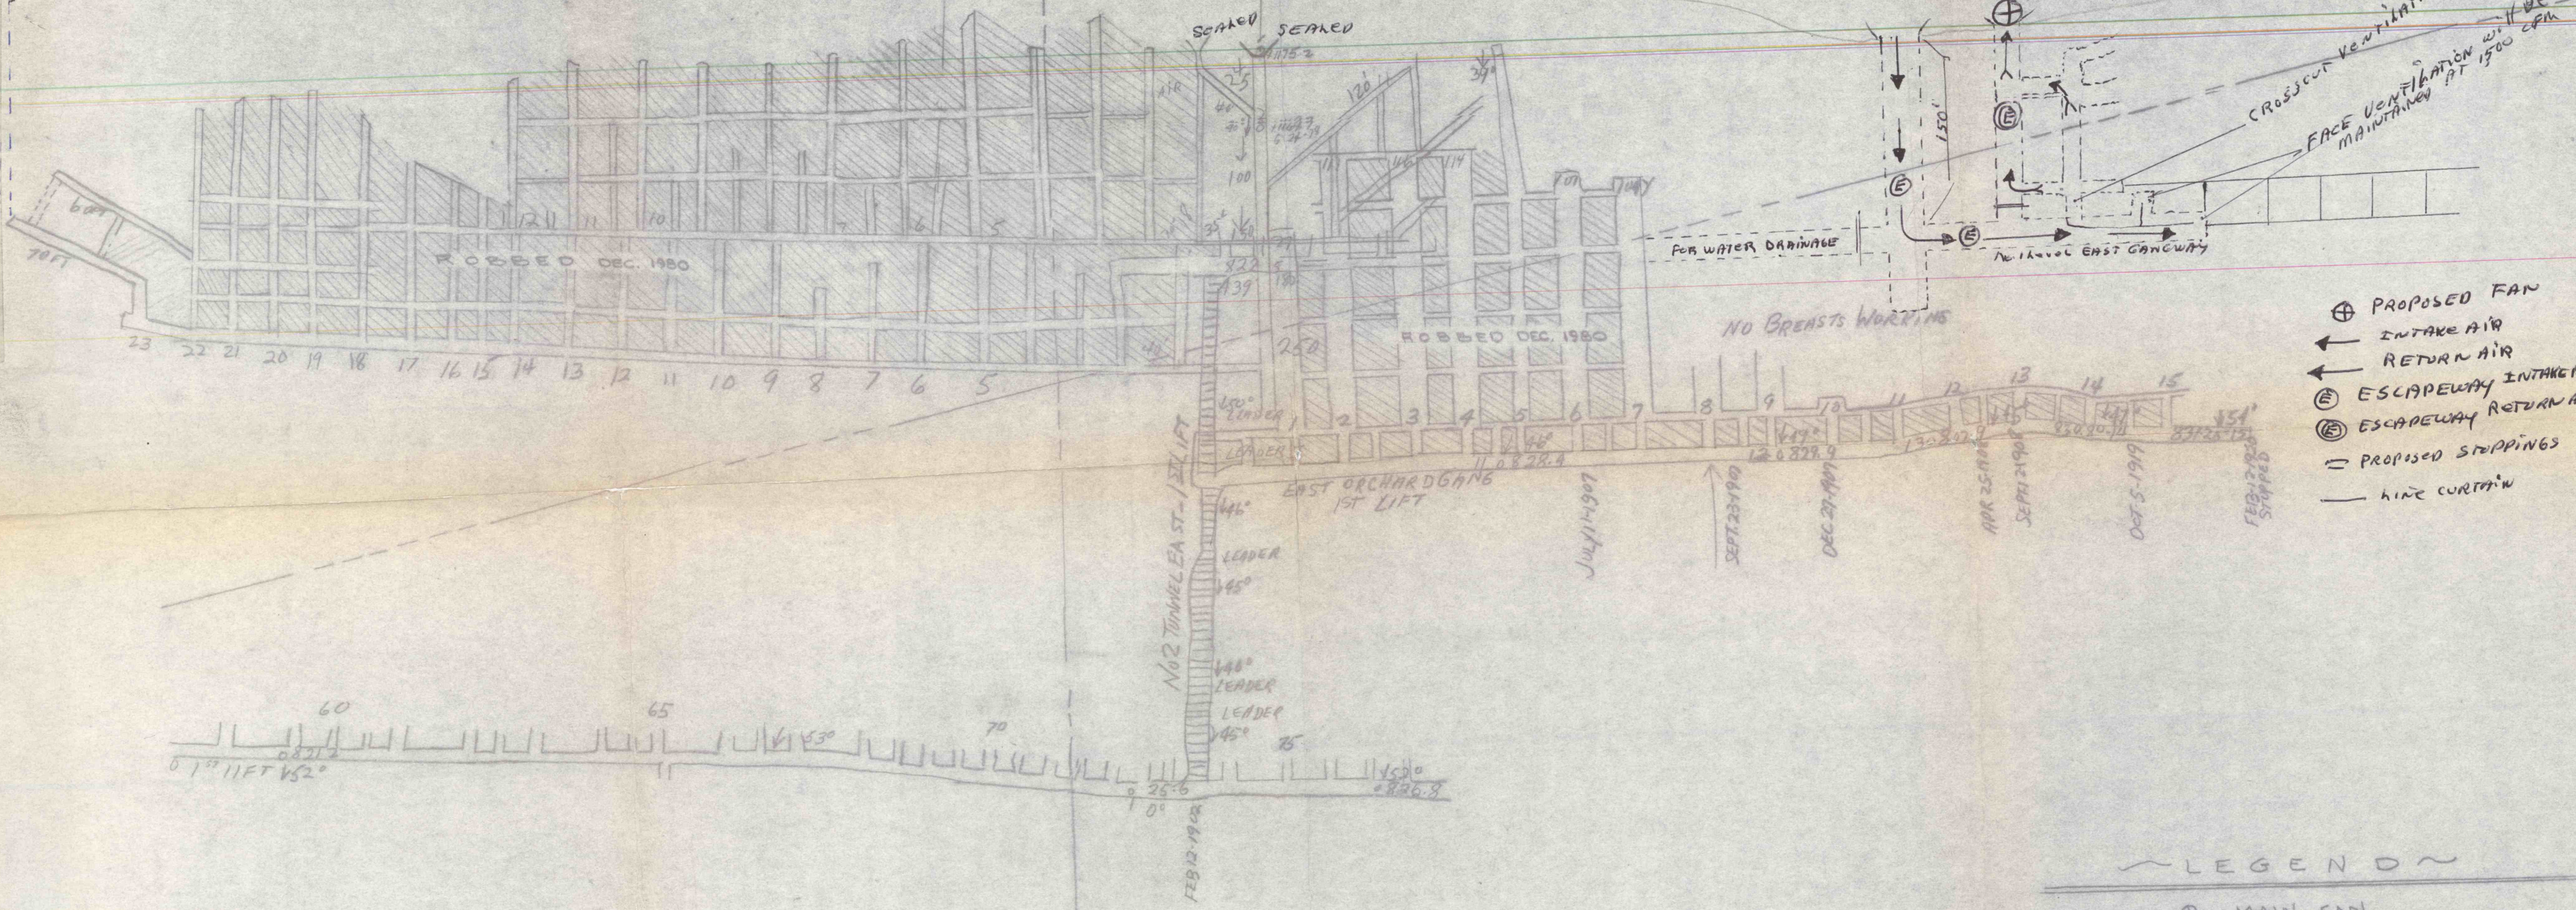

- ⊕ PROPOSED FAN
- ← INTAKE AIR
- RETURN AIR
- ⓔ ESCAPEWAY INTAKE AIR
- ⓕ ESCAPEWAY RETURN AIR
- ▬ PROPOSED STOPPINGS
- MINE CURTAIN

~ LEGEND ~

- ⊕ MAIN FAN
- INTAKE AIR
- ← RETURN AIR
- ▬ PERMANENT STOPPING
- - - TEMPORARY STOPPING
- - - BRATTICE
- ⓔ ESCAPEWAY RETURN AIR WAY
- ⓕ ESCAPEWAY INTAKE AIR



Michael F. Catino
1-14-81

NEW WAY COAL CO.
ORCHARD VEIN CONYINGHAM TWP.
COLUMBIA COUNTY, I.D. No. 36-06696
SCALE 1"=100'-0"