


LEASE 1070 LEASE 1000

NEW WAY COAL CO.

3000' E  
3000' E  
P.O. 8-24-78

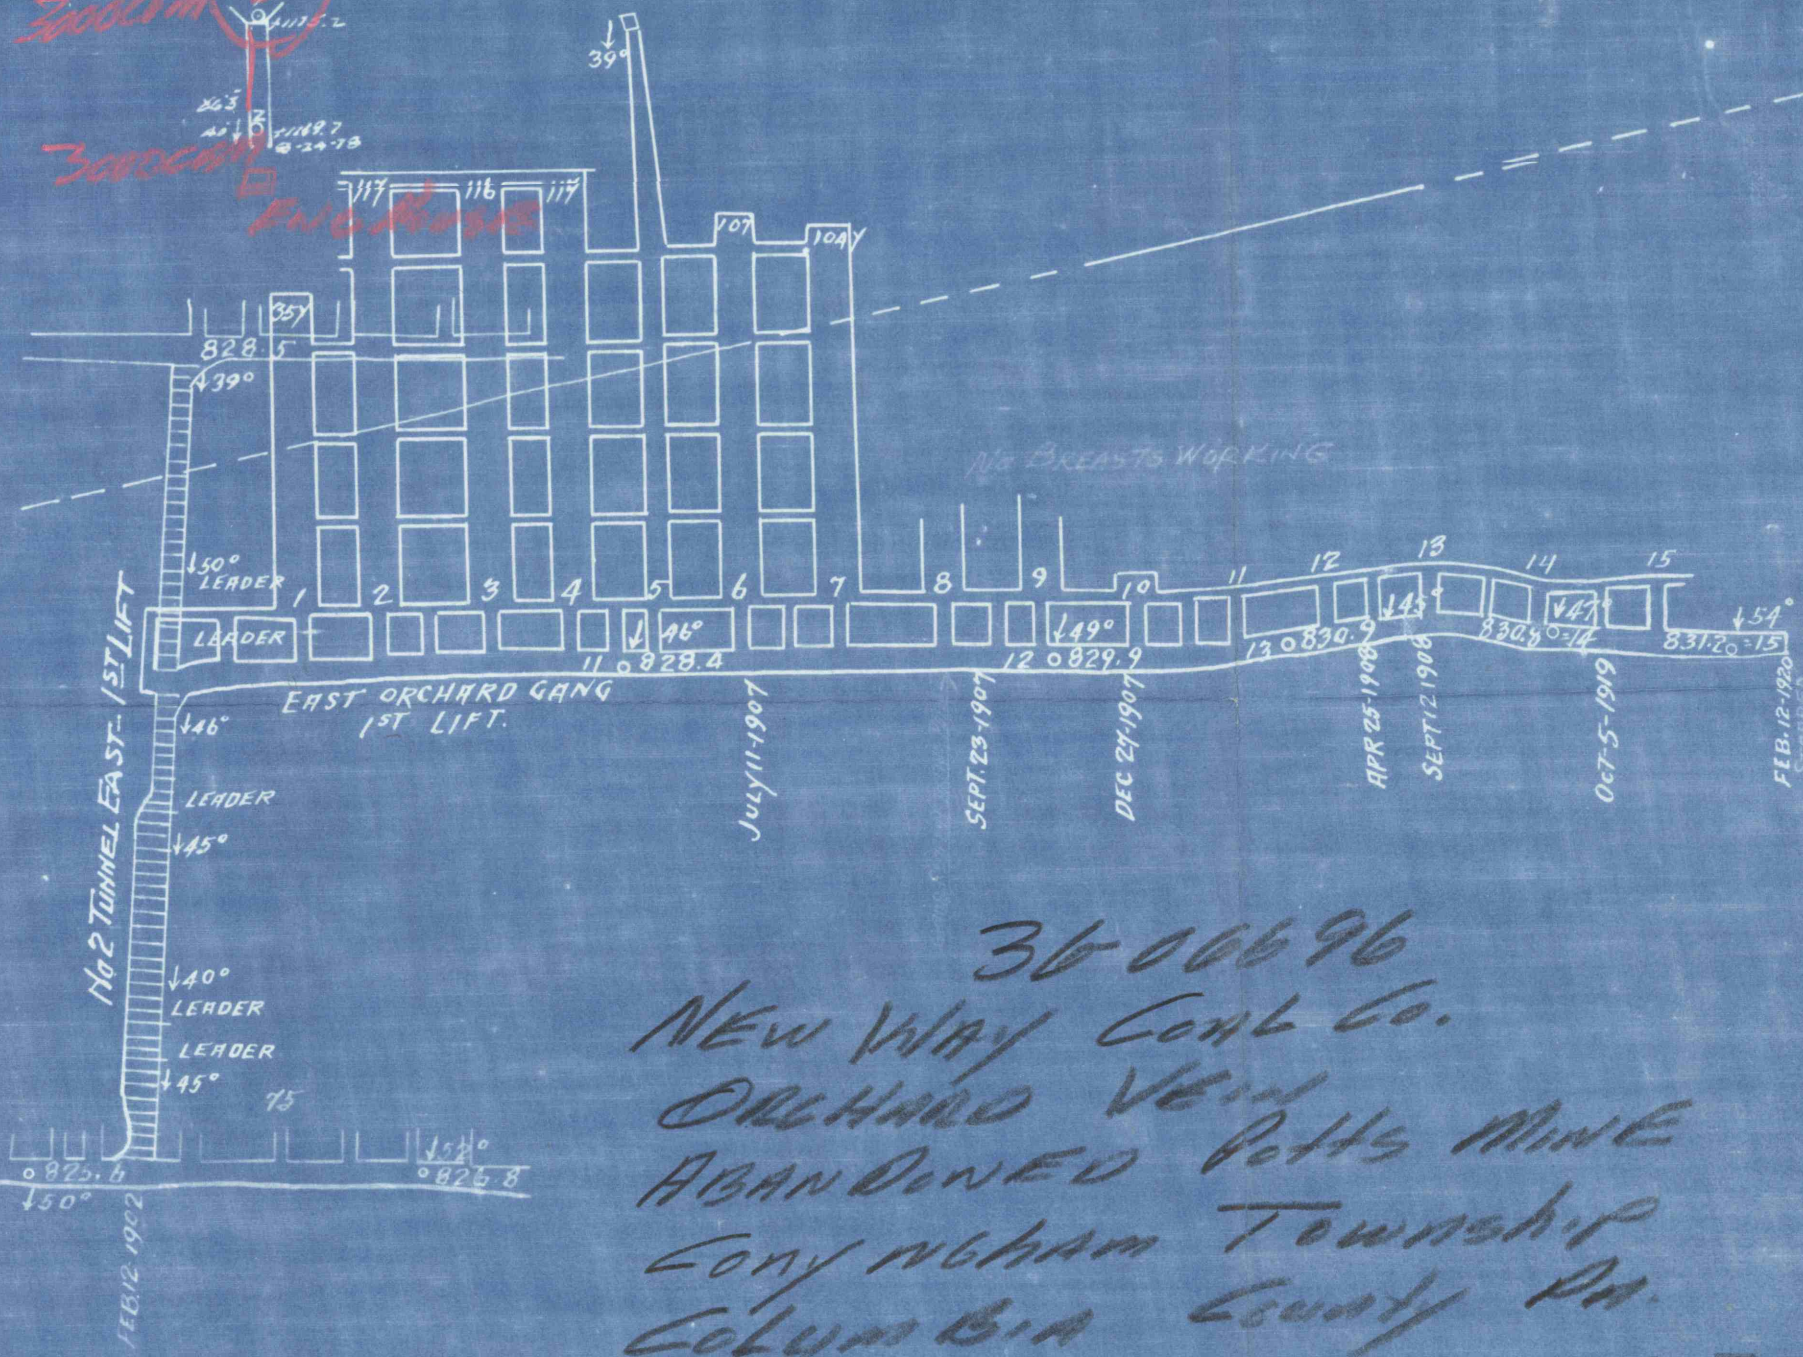

36-00696  
NEW WAY COAL CO.  
ORCHARD VENT  
ABANDONED Potts MINE  
CONYNGHAM Township  
COLUMBIA County PA.  
1 1/2 = 100  
8-24-78

