

GREAT ANTHRACITE COAL COMPANY

BOSLEGO

READING ANTHRACITE COMPANY

NORTHUMBERLAND
COUNTY COMMISSIONERS

LEONA BOSLEGO


NOTE: NO KNOWN WORKINGS ABOVE OR BELOW FOR 1,000 FEET

ALEXANDER HUNTER WARRANTEE TRACT

ROSINI COAL COMPANY

ROBERT DONAHUE

- VENTILATION SYMBOLS
(where appropriate)
- Main Fan
 - Auxiliary Fan
 - Air Flow-Intake (Green)
 - ← Air Flow-Return (Red)
 - ⊥ Stopping
 - ⊥ Air Bridge
 - ⊥ Regulator
 - ⊥ Man Door
 - ⊥ Velocity ft/min
 - ⊥ Quantity, cfm
 - ⊥ Water Gauge, in
 - ⊥ Escapeway
 - ⊥ Bleeder Evaluation Point
 - ⊥ Pipe Removal or Raising
 - ⊥ Mine Seal
 - ⊥ Active Workings (Yellow)
 - ⊥ Curfew or Barbed
 - ⊥ Workings Not Surveyed
 - ⊥ Caved Ground

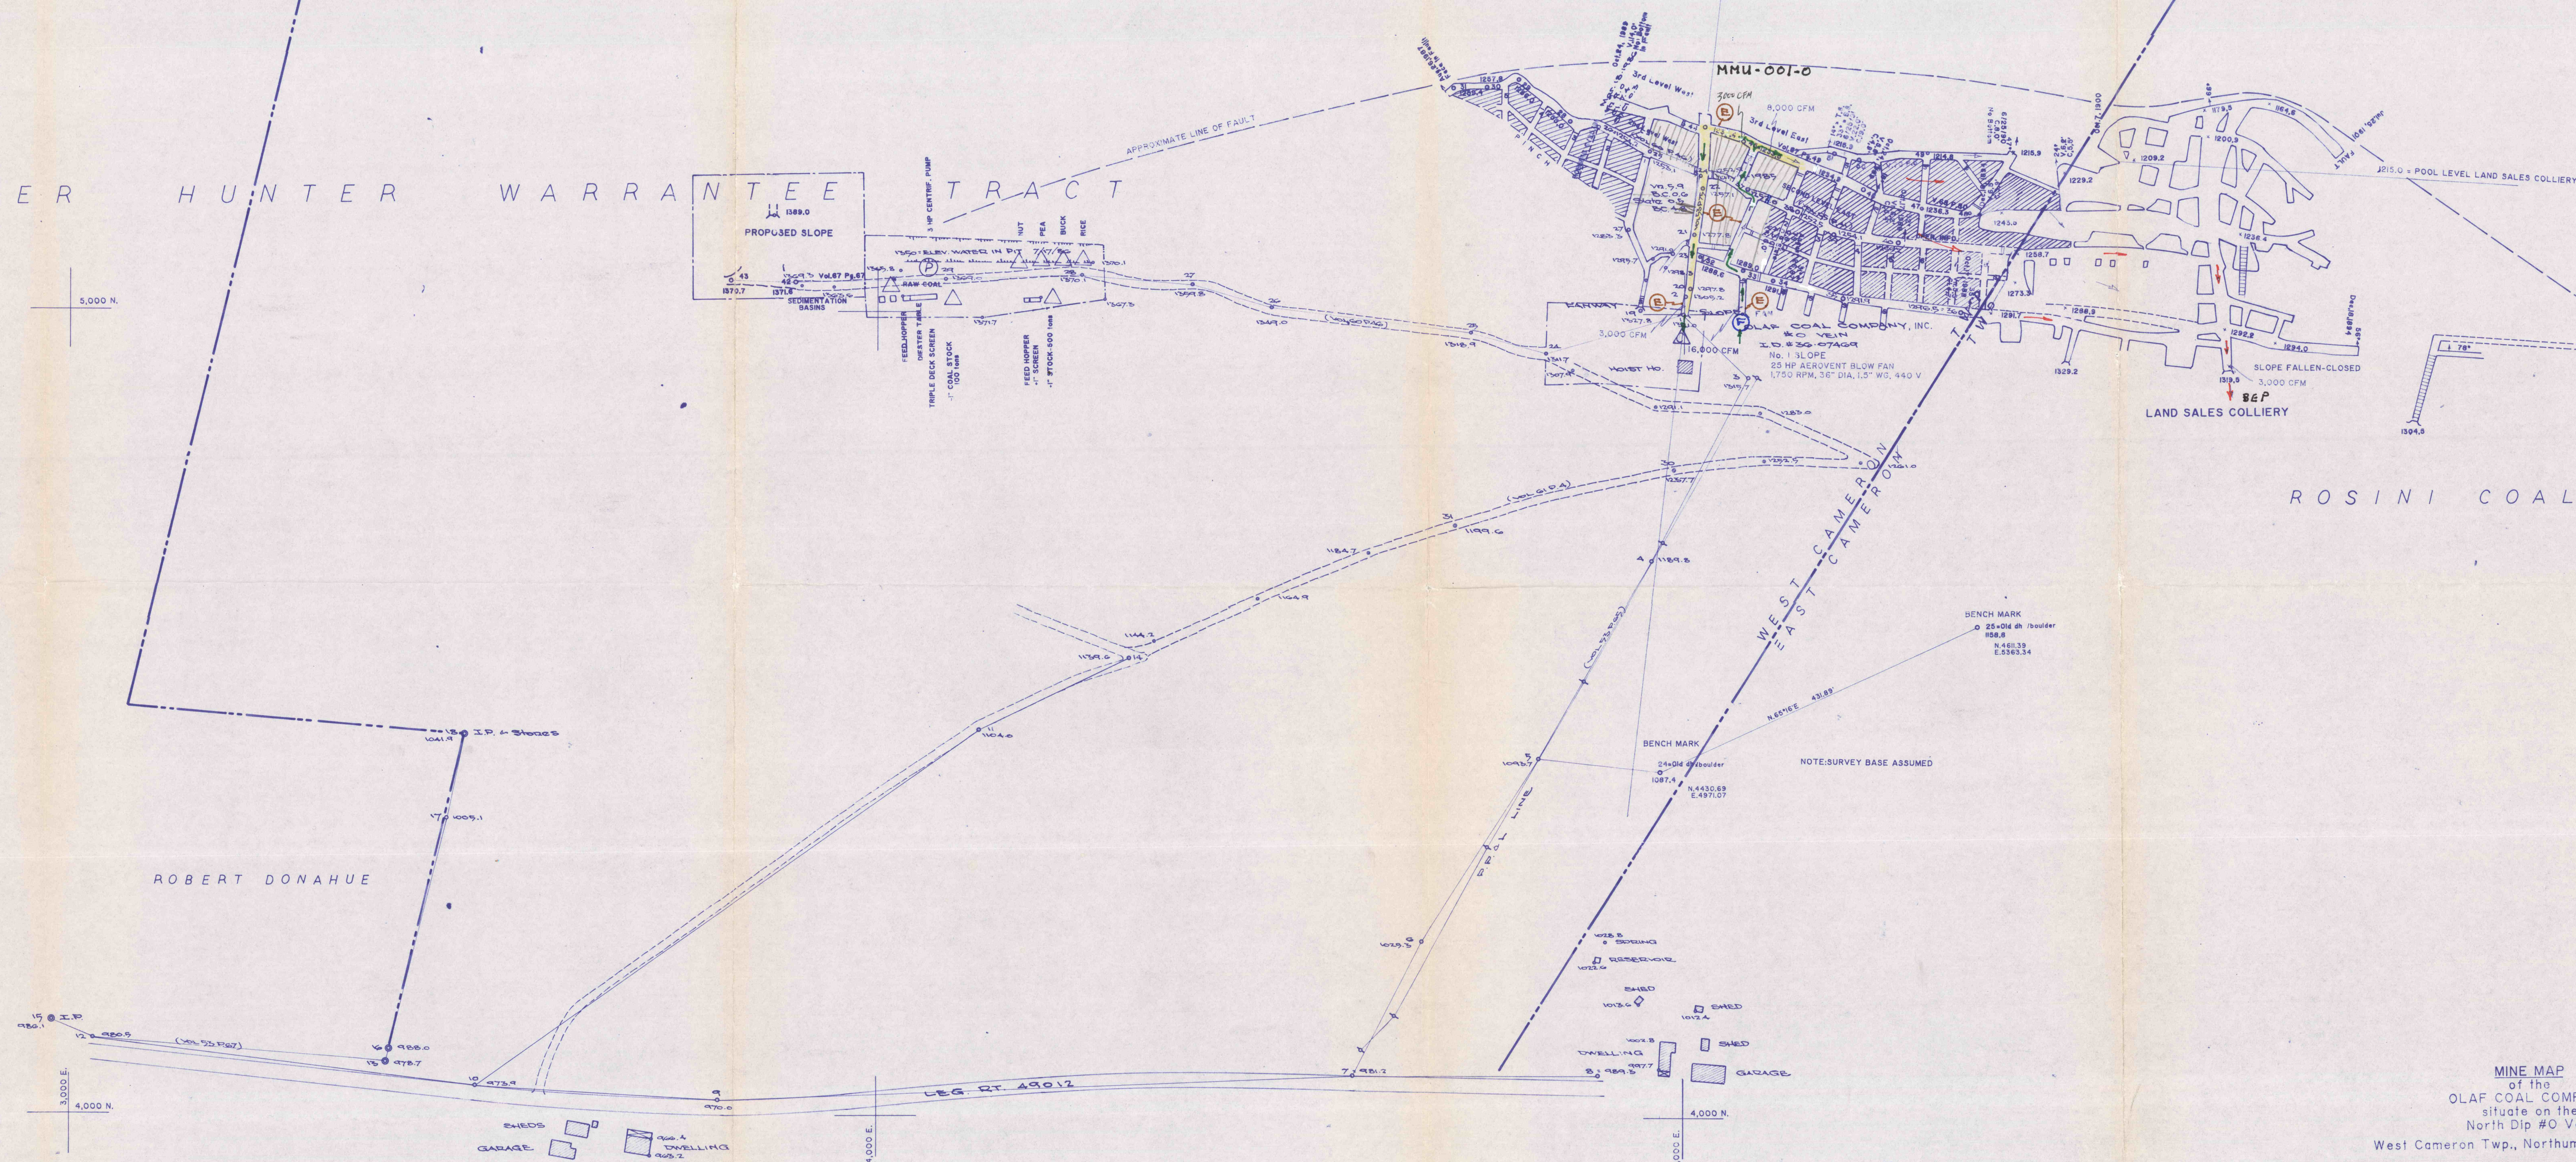

MINE MAP
of the
OLAF COAL COMPANY, INC.
situated on the
North Dip #0 Vein
West Cameron Twp., Northumberland County

Scale 1 inch = 100 feet

April 1934