

ESCAPEWAY

ROBBED

SURVEY STATION O₃ (TAYLOR - DOBECK ASSOC.) 5/167A (SUSQUEHANNA COAL CO.)

ELEVATION + 1382 (SUSQUEHANNA COAL CO. DATUM)

STOPPING

INTAKE AIR I

RETURN AIR R

OLD ABANDONED WORKINGS

NEW WORKINGS OF NORTH MOUNTAIN COAL CO.

PROPERTY LINE

OUTCROP LINE

Station No. 11 Drill Hole In Rock
N = 1,090.25 (N)
E = -8,420.64 (W)

Station No. 13 Drill Hole In Rock
N = 1,156.43 (N)
E = -8,207.70 (W)


Station No. 71 Chisel Mark On Angle Iron On Tipple
N = 951.14 (N)
E = -8,893.80 (W)

Station No. 76 Drill Hole In Rock
N = 1,063.27 (N)
E = -8,642.35 (W)


Station No. 77 Spike In Road
N = 873.53 (N)
E = -8,772.80 (W)

Station No. 78 Spike On Southerly Side Of Road
N = 801.89 (N)
E = -8,658.78 (W)

Station No. 79 Spike On Northerly Side Of Road
N = 810.58 (N)
E = -8,417.18 (W)

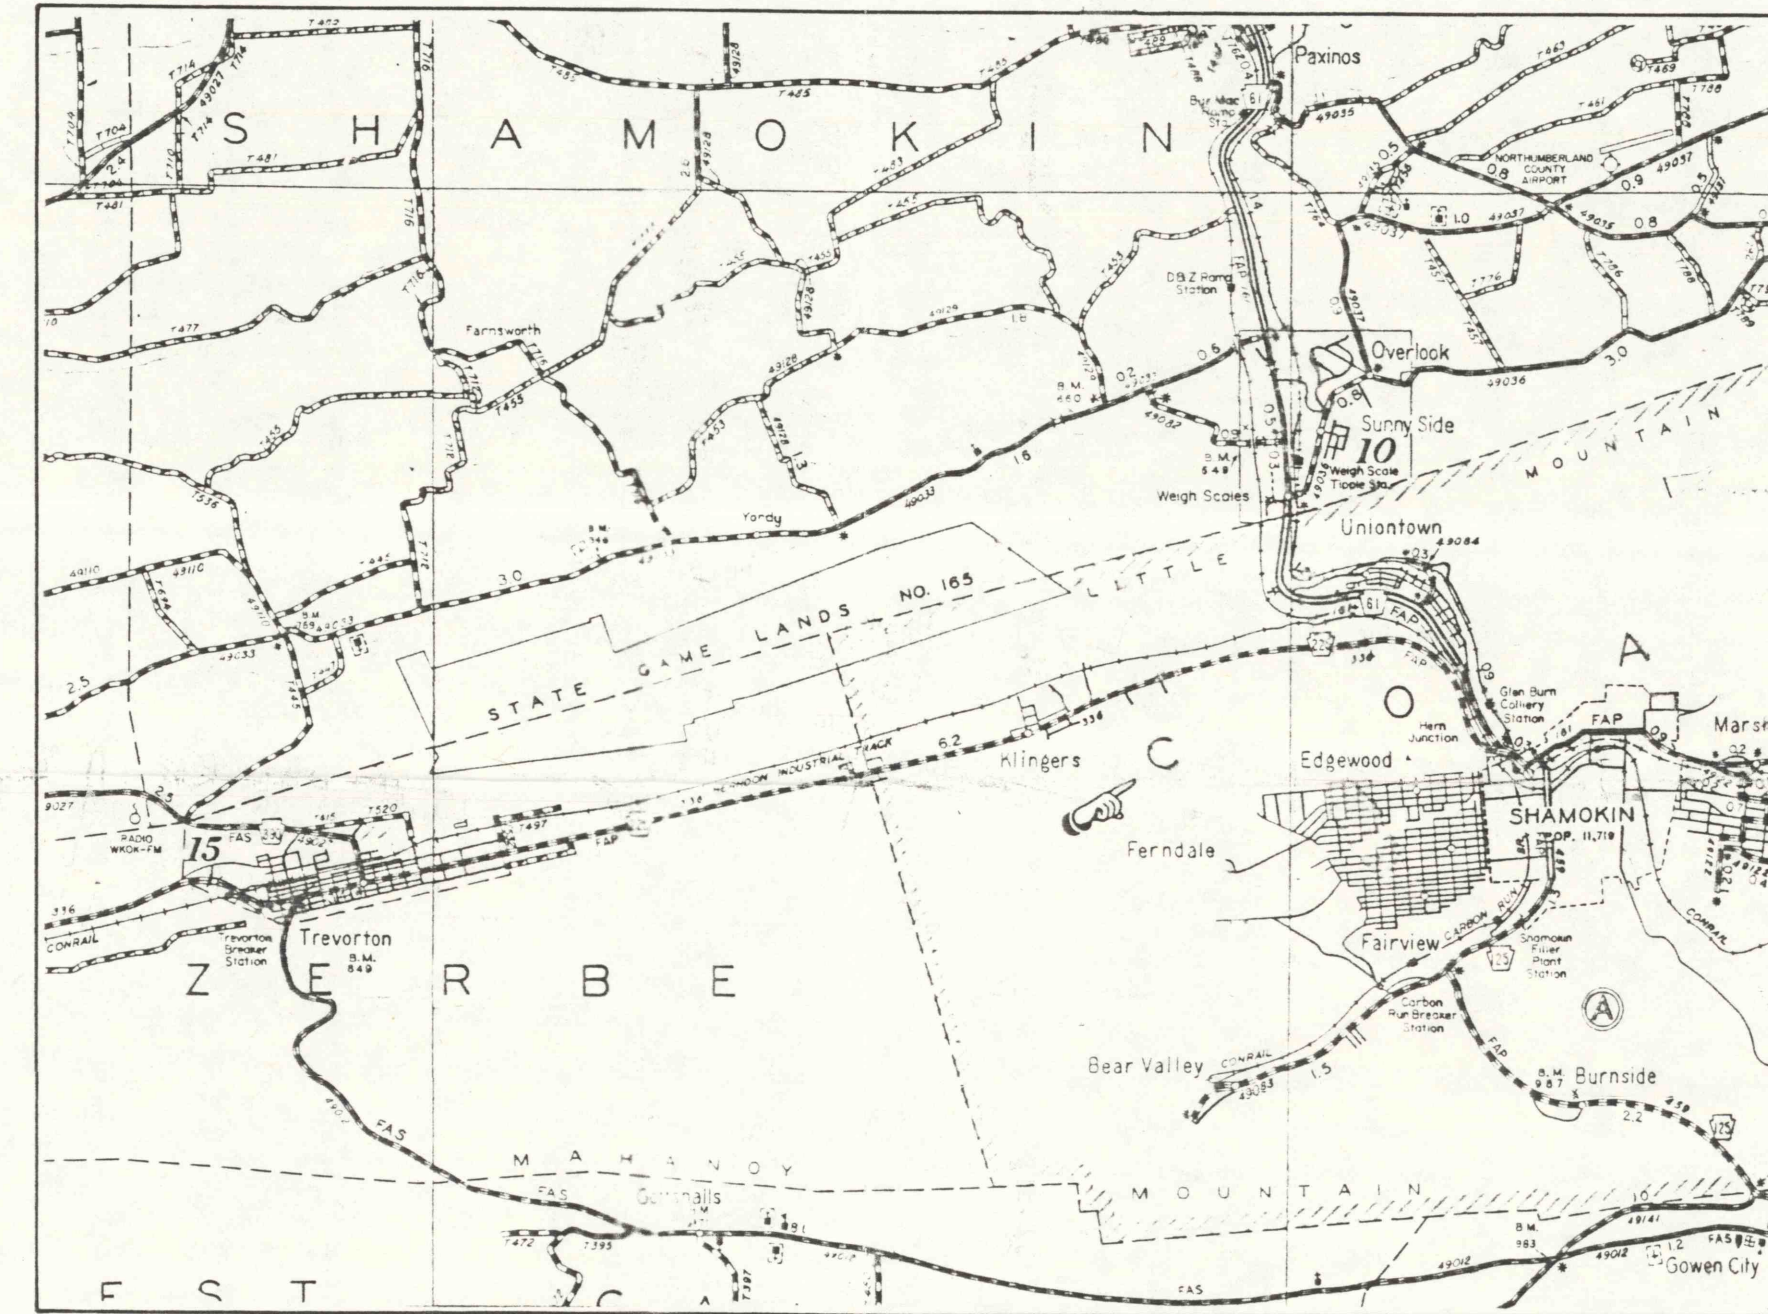

Location Map
1 Inch = 1 Mile

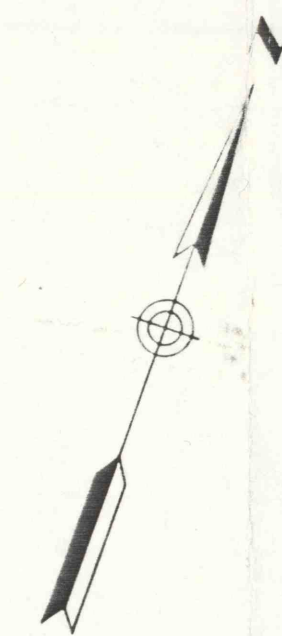

Pennsylvania State Highway Traffic Route No. 225

To Trevorton To Shamokin


35 0
Pennsylvania Power & Light Co. Right-Of-Way

No. 2 Hein - South Dip

MINE SURVEY FOR
NORTH MOUNTAIN COAL CO.
COAL TOWNSHIP, NORTHUMBERLAND COUNTY
PENNSYLVANIA

SCALE: 1 INCH = 100 FEET, OCTOBER 16, 1985
REVISED: NOV. 6, 1987 MAY 2, 1988
M.S.H.A. I.D.# 36- 07681 JAN. 20, 1989

Taylor-Dobek Associates
PROFESSIONAL LAND SURVEYORS
RD #1 BOX 659
SHAMOKIN, PA. 17872

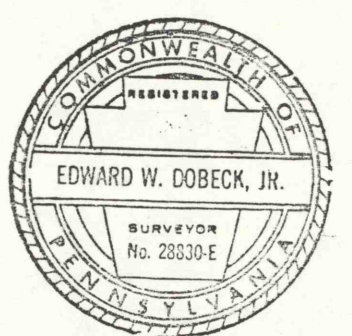

Surface

SHEET NO. 1 OF 4

1191