


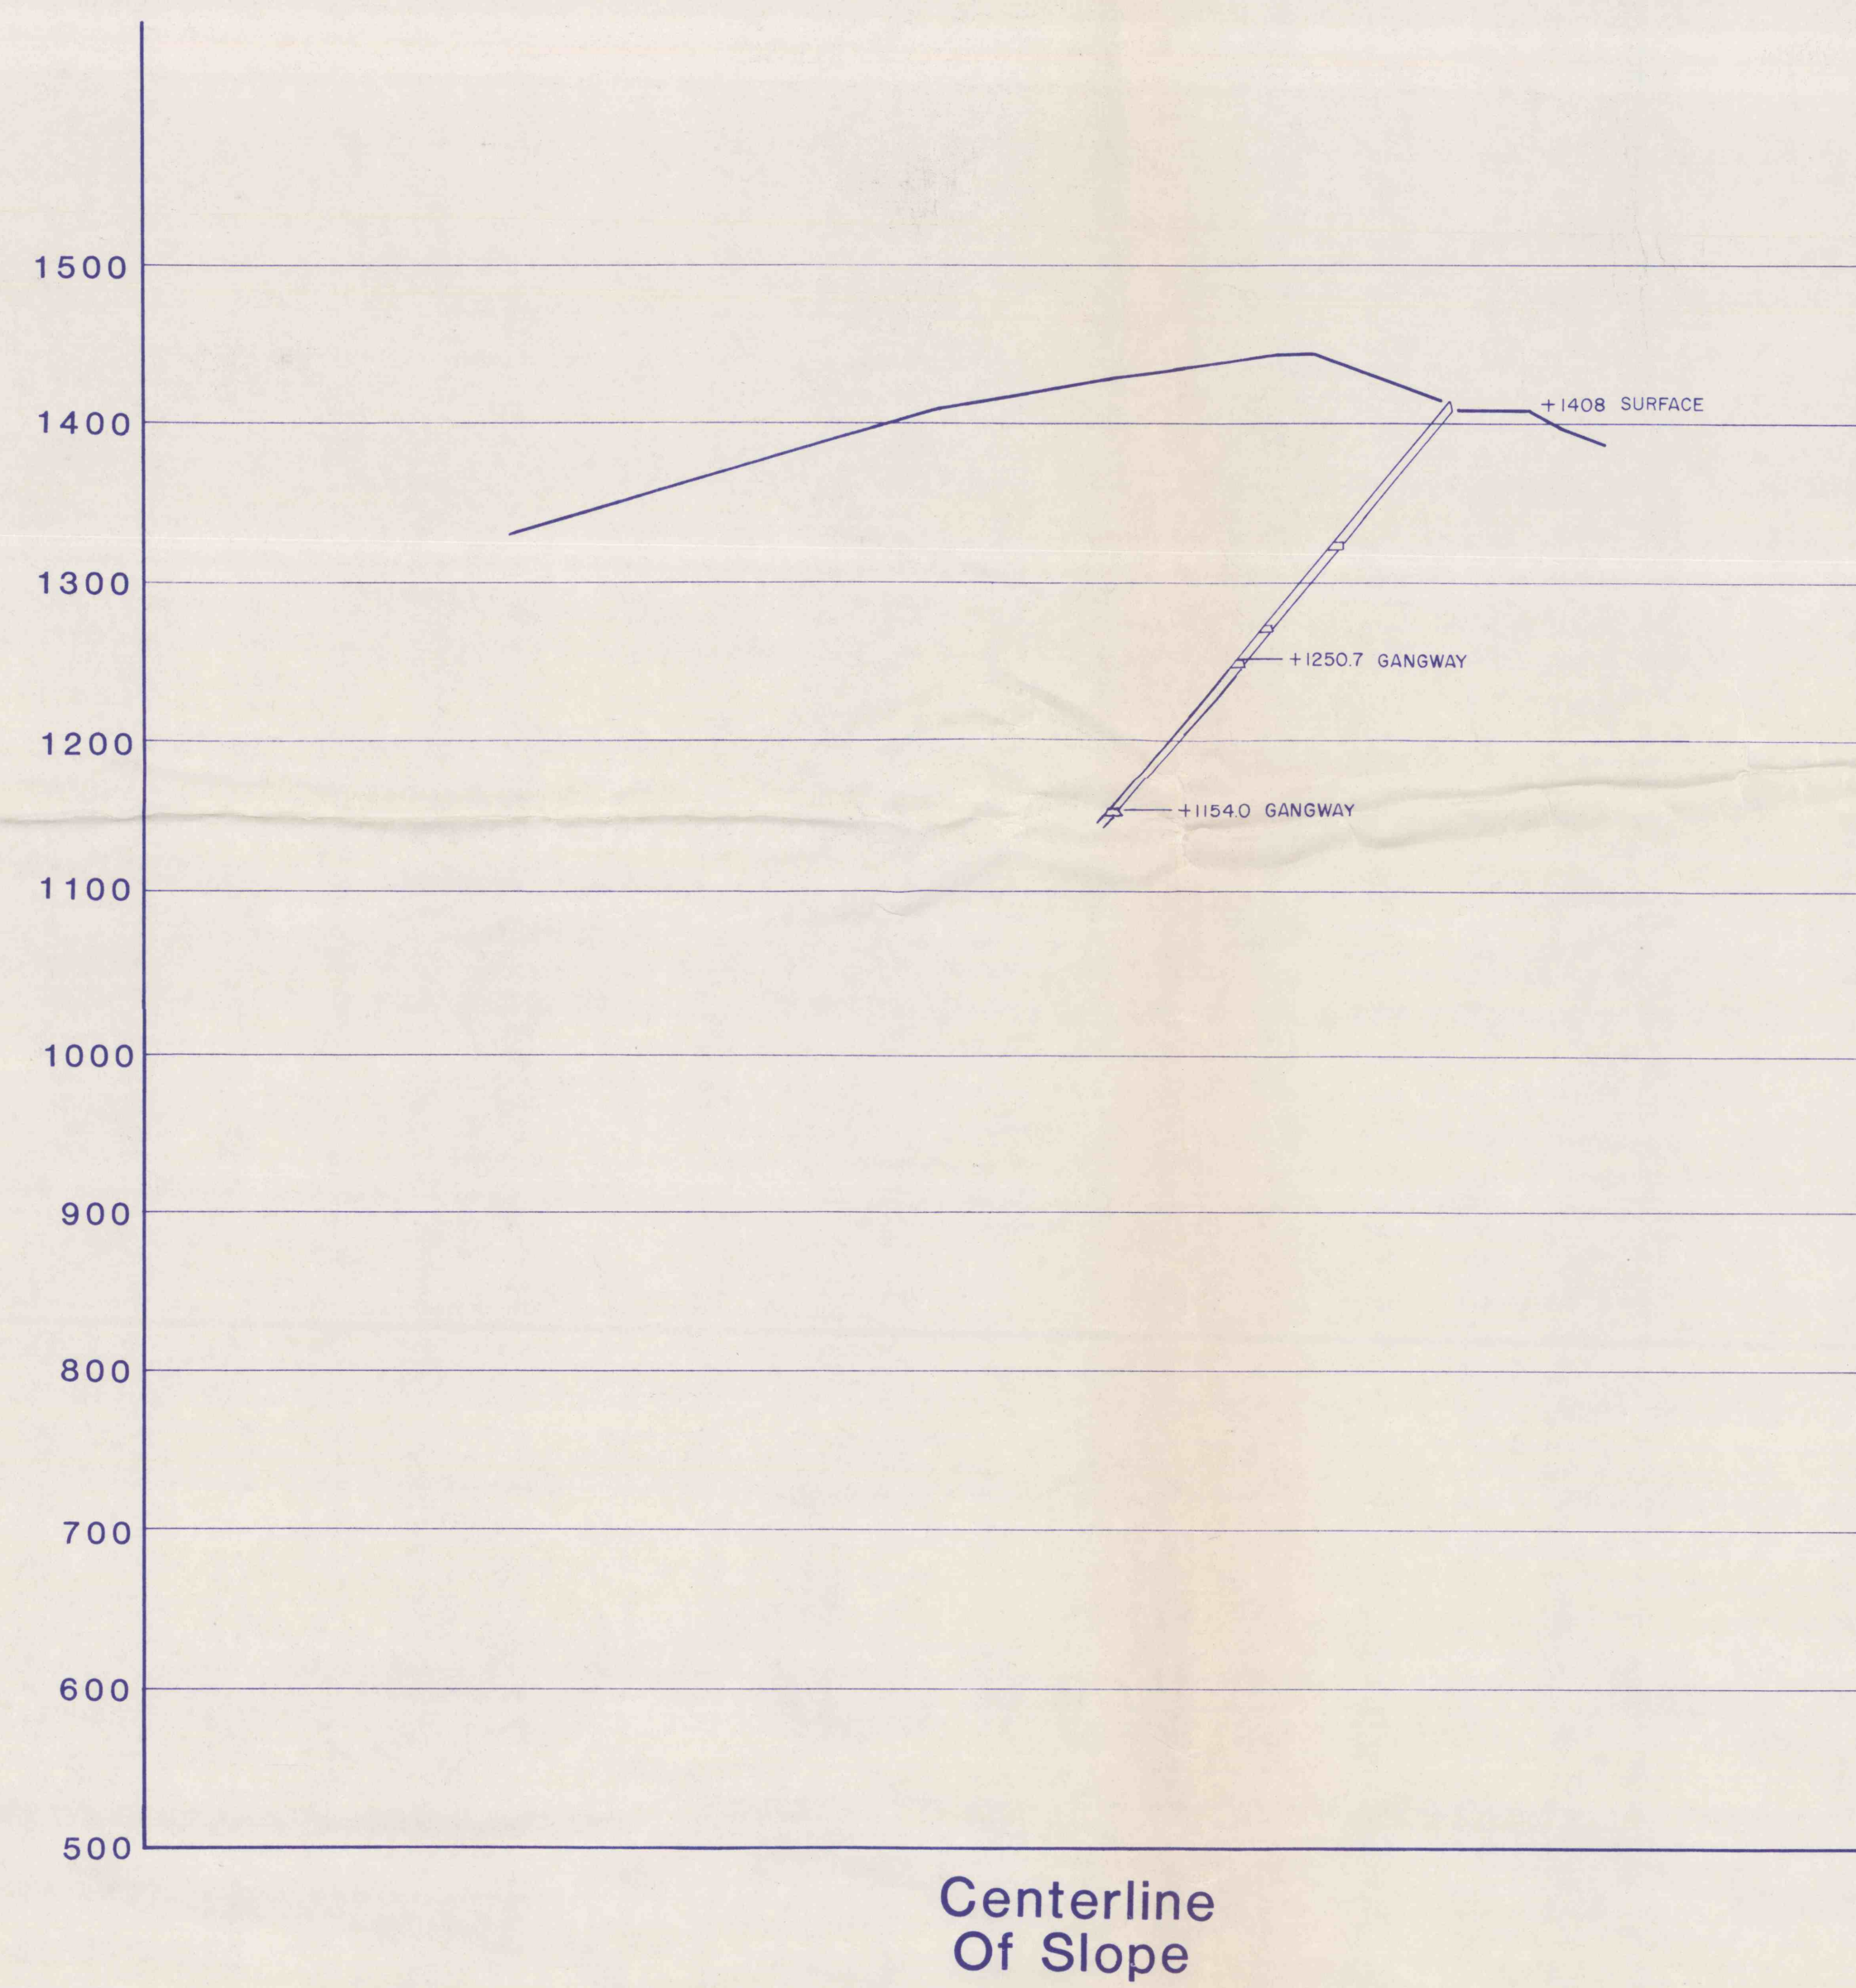


No. 2 Vein - South Dip

MINE SURVEY FOR
NORTH MOUNTAIN COAL CO.
 COAL TOWNSHIP, NORTHUMBERLAND COUNTY
 PENNSYLVANIA

SCALE: VERTICAL - 1 INCH = 100 FEET
 HORIZONTAL - 1 INCH = 100 FEET


OCTOBER 16, 1985
 REVISED: NOV. 6, 1987

M.S.H.A. I.D.#36-05873

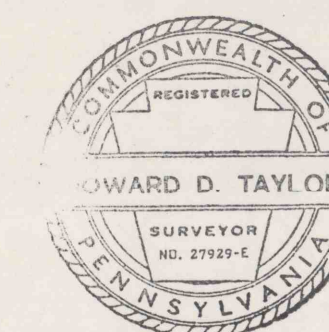

Howard D. Taylor

Taylor-Doberk Associates
 PROFESSIONAL LAND SURVEYORS
 RD#1 BOX 659
 SHAMOKIN, PA. 17872

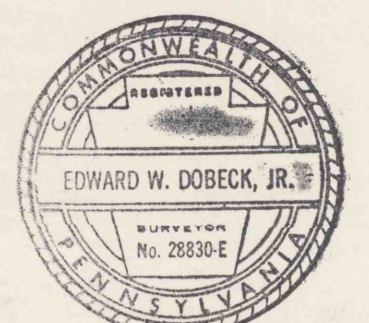

Edward W. Doberk, Jr.

Cross-Sections
 SHEET NO. 3 OF 4