


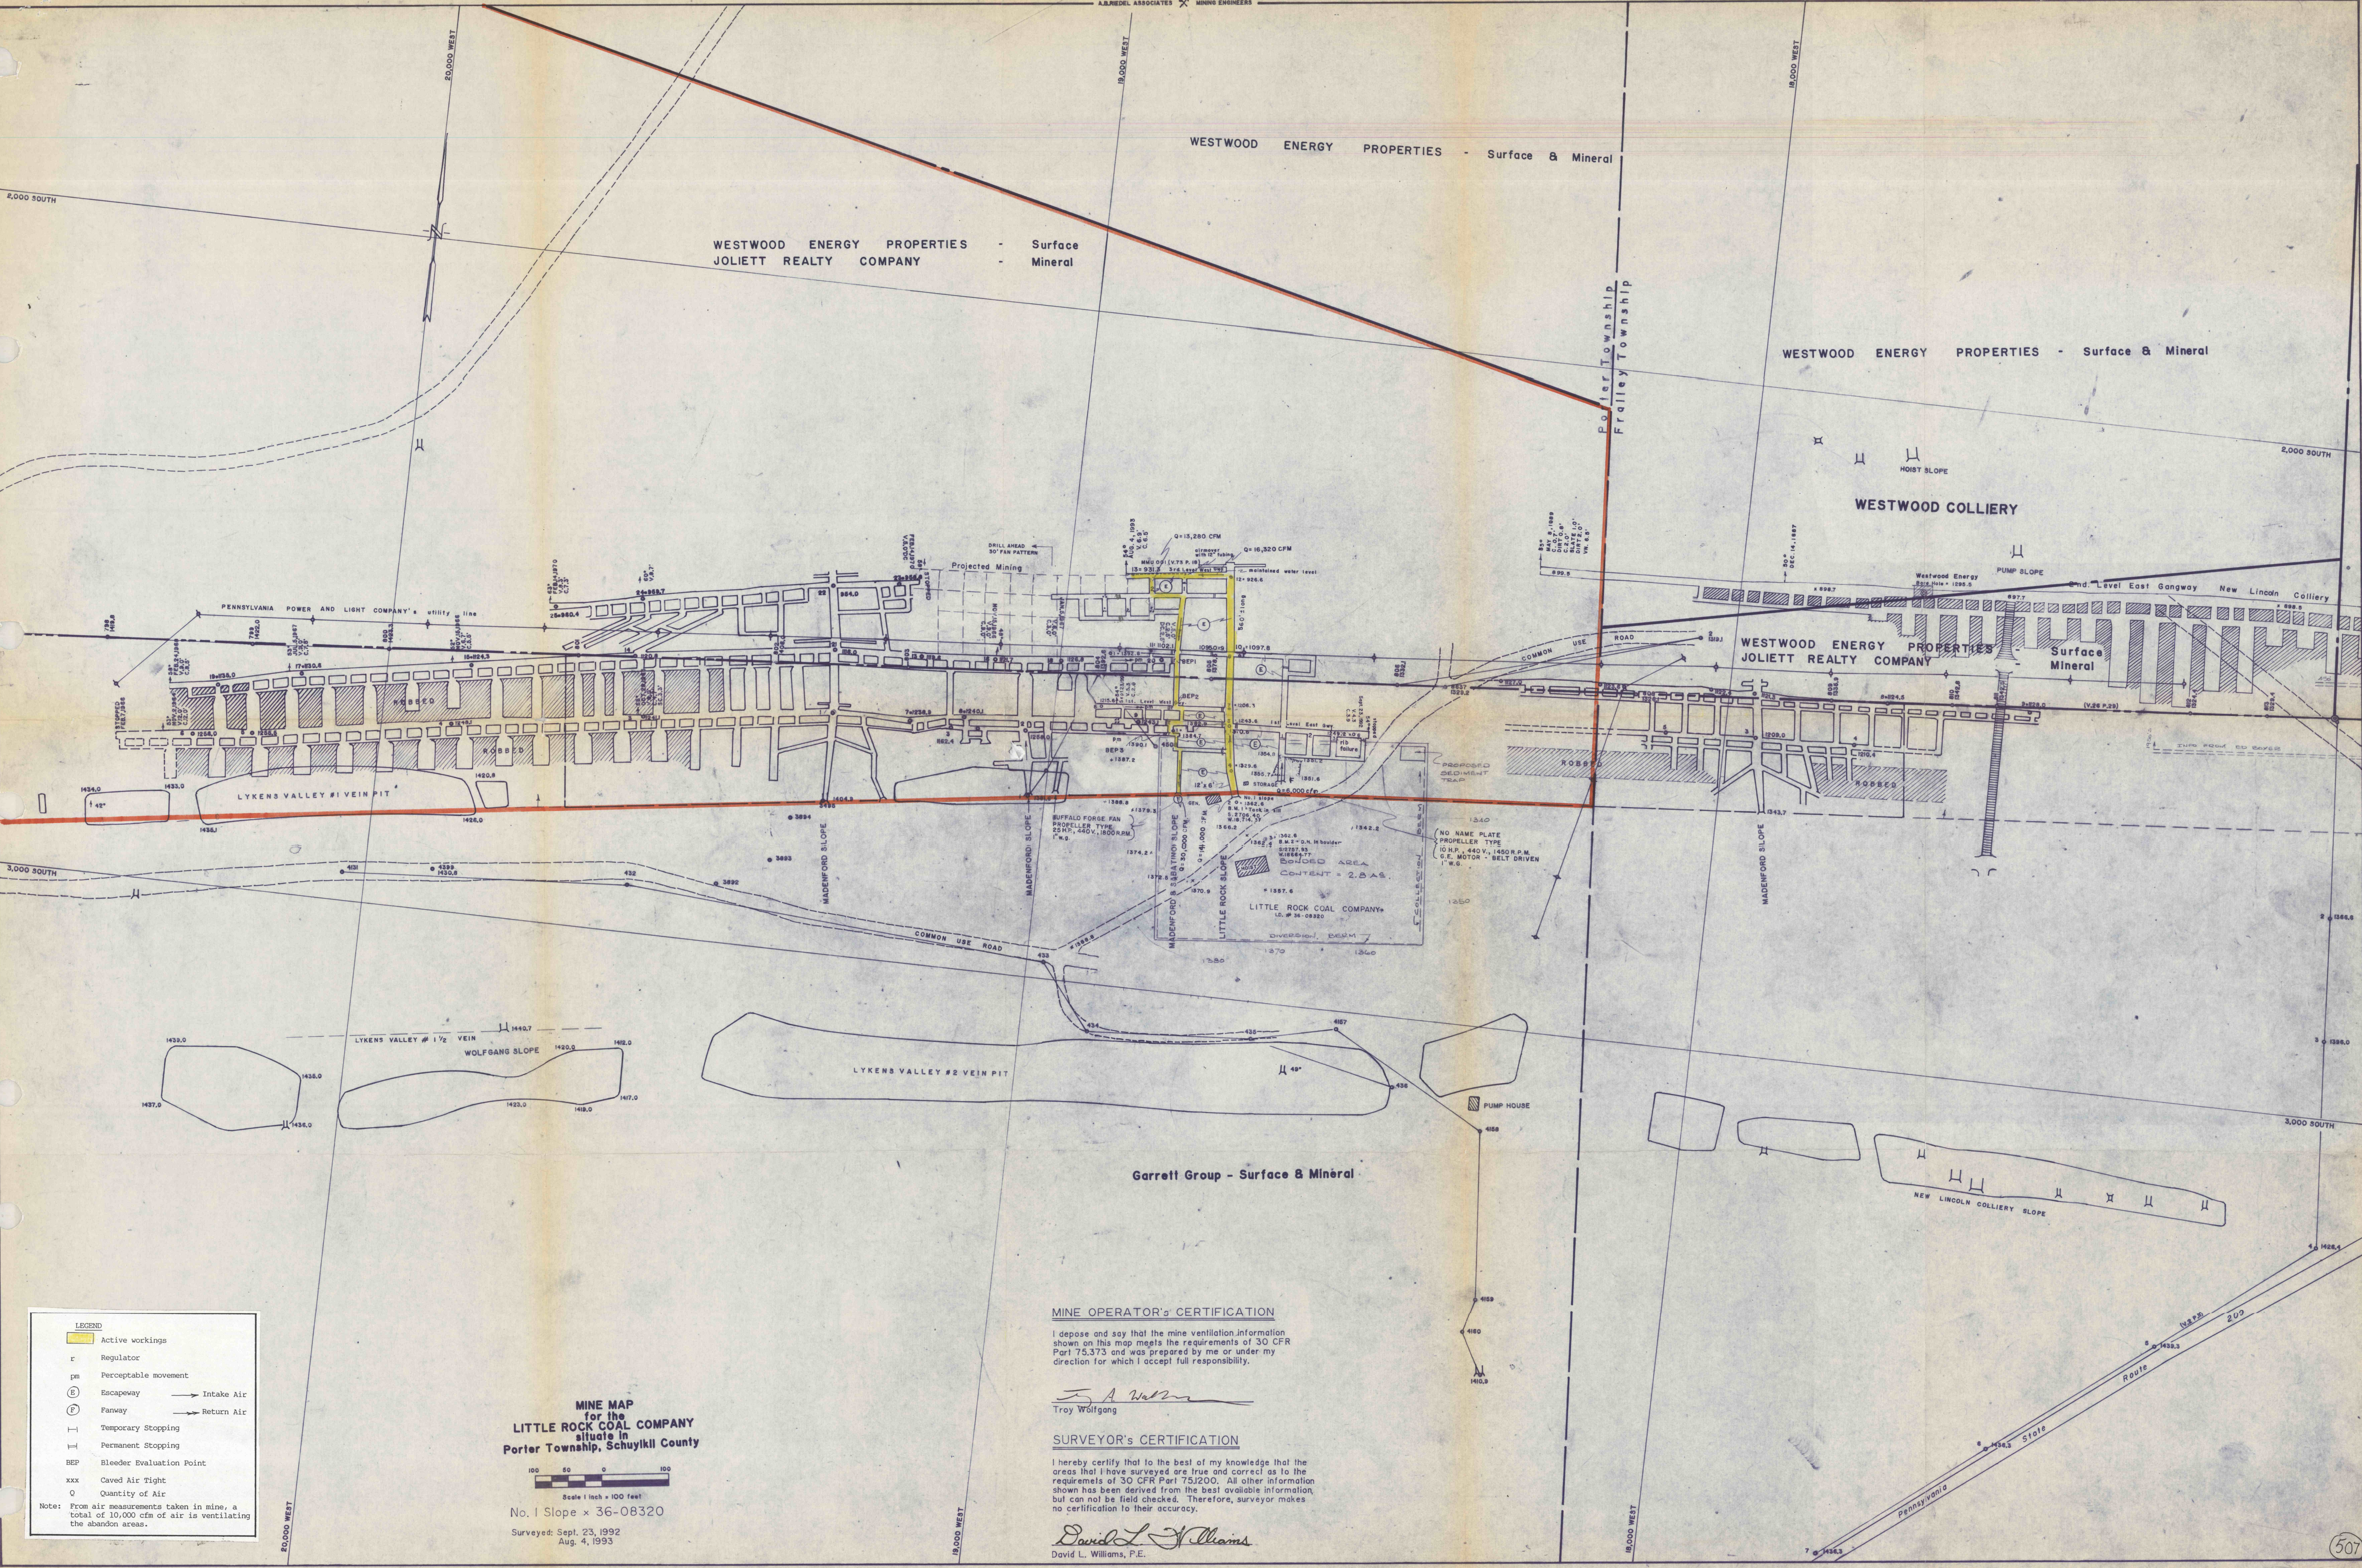

LEGEND

- Active workings
- Regulator
- Perceptible movement
- Escapeway
- Fanway
- Temporary Stopping
- Permanent Stopping
- Bleeder Evaluation Point
- Caved Air Tight
- Quantity of Air

Note: From air measurements taken in mine, a total of 10,000 cfm of air is ventilating the abandon areas.

MINE MAP
for the
LITTLE ROCK COAL COMPANY
situate in
Porter Township, Schuylkill County

Scale 1 inch = 100 feet

No. 1 Slope x 36-08320

Surveyed: Sept. 23, 1992
Aug. 4, 1993

MINE OPERATOR'S CERTIFICATION

I depose and say that the mine ventilation information shown on this map meets the requirements of 30 CFR Part 75.373 and was prepared by me or under my direction for which I accept full responsibility.

Troy Wolfgang
Troy Wolfgang

SURVEYOR'S CERTIFICATION

I hereby certify that to the best of my knowledge that the areas that I have surveyed are true and correct as to the requirements of 30 CFR Part 75.200. All other information shown has been derived from the best available information, but can not be field checked. Therefore, surveyor makes no certification to its accuracy.

David L. Williams
David L. Williams, P.E.