


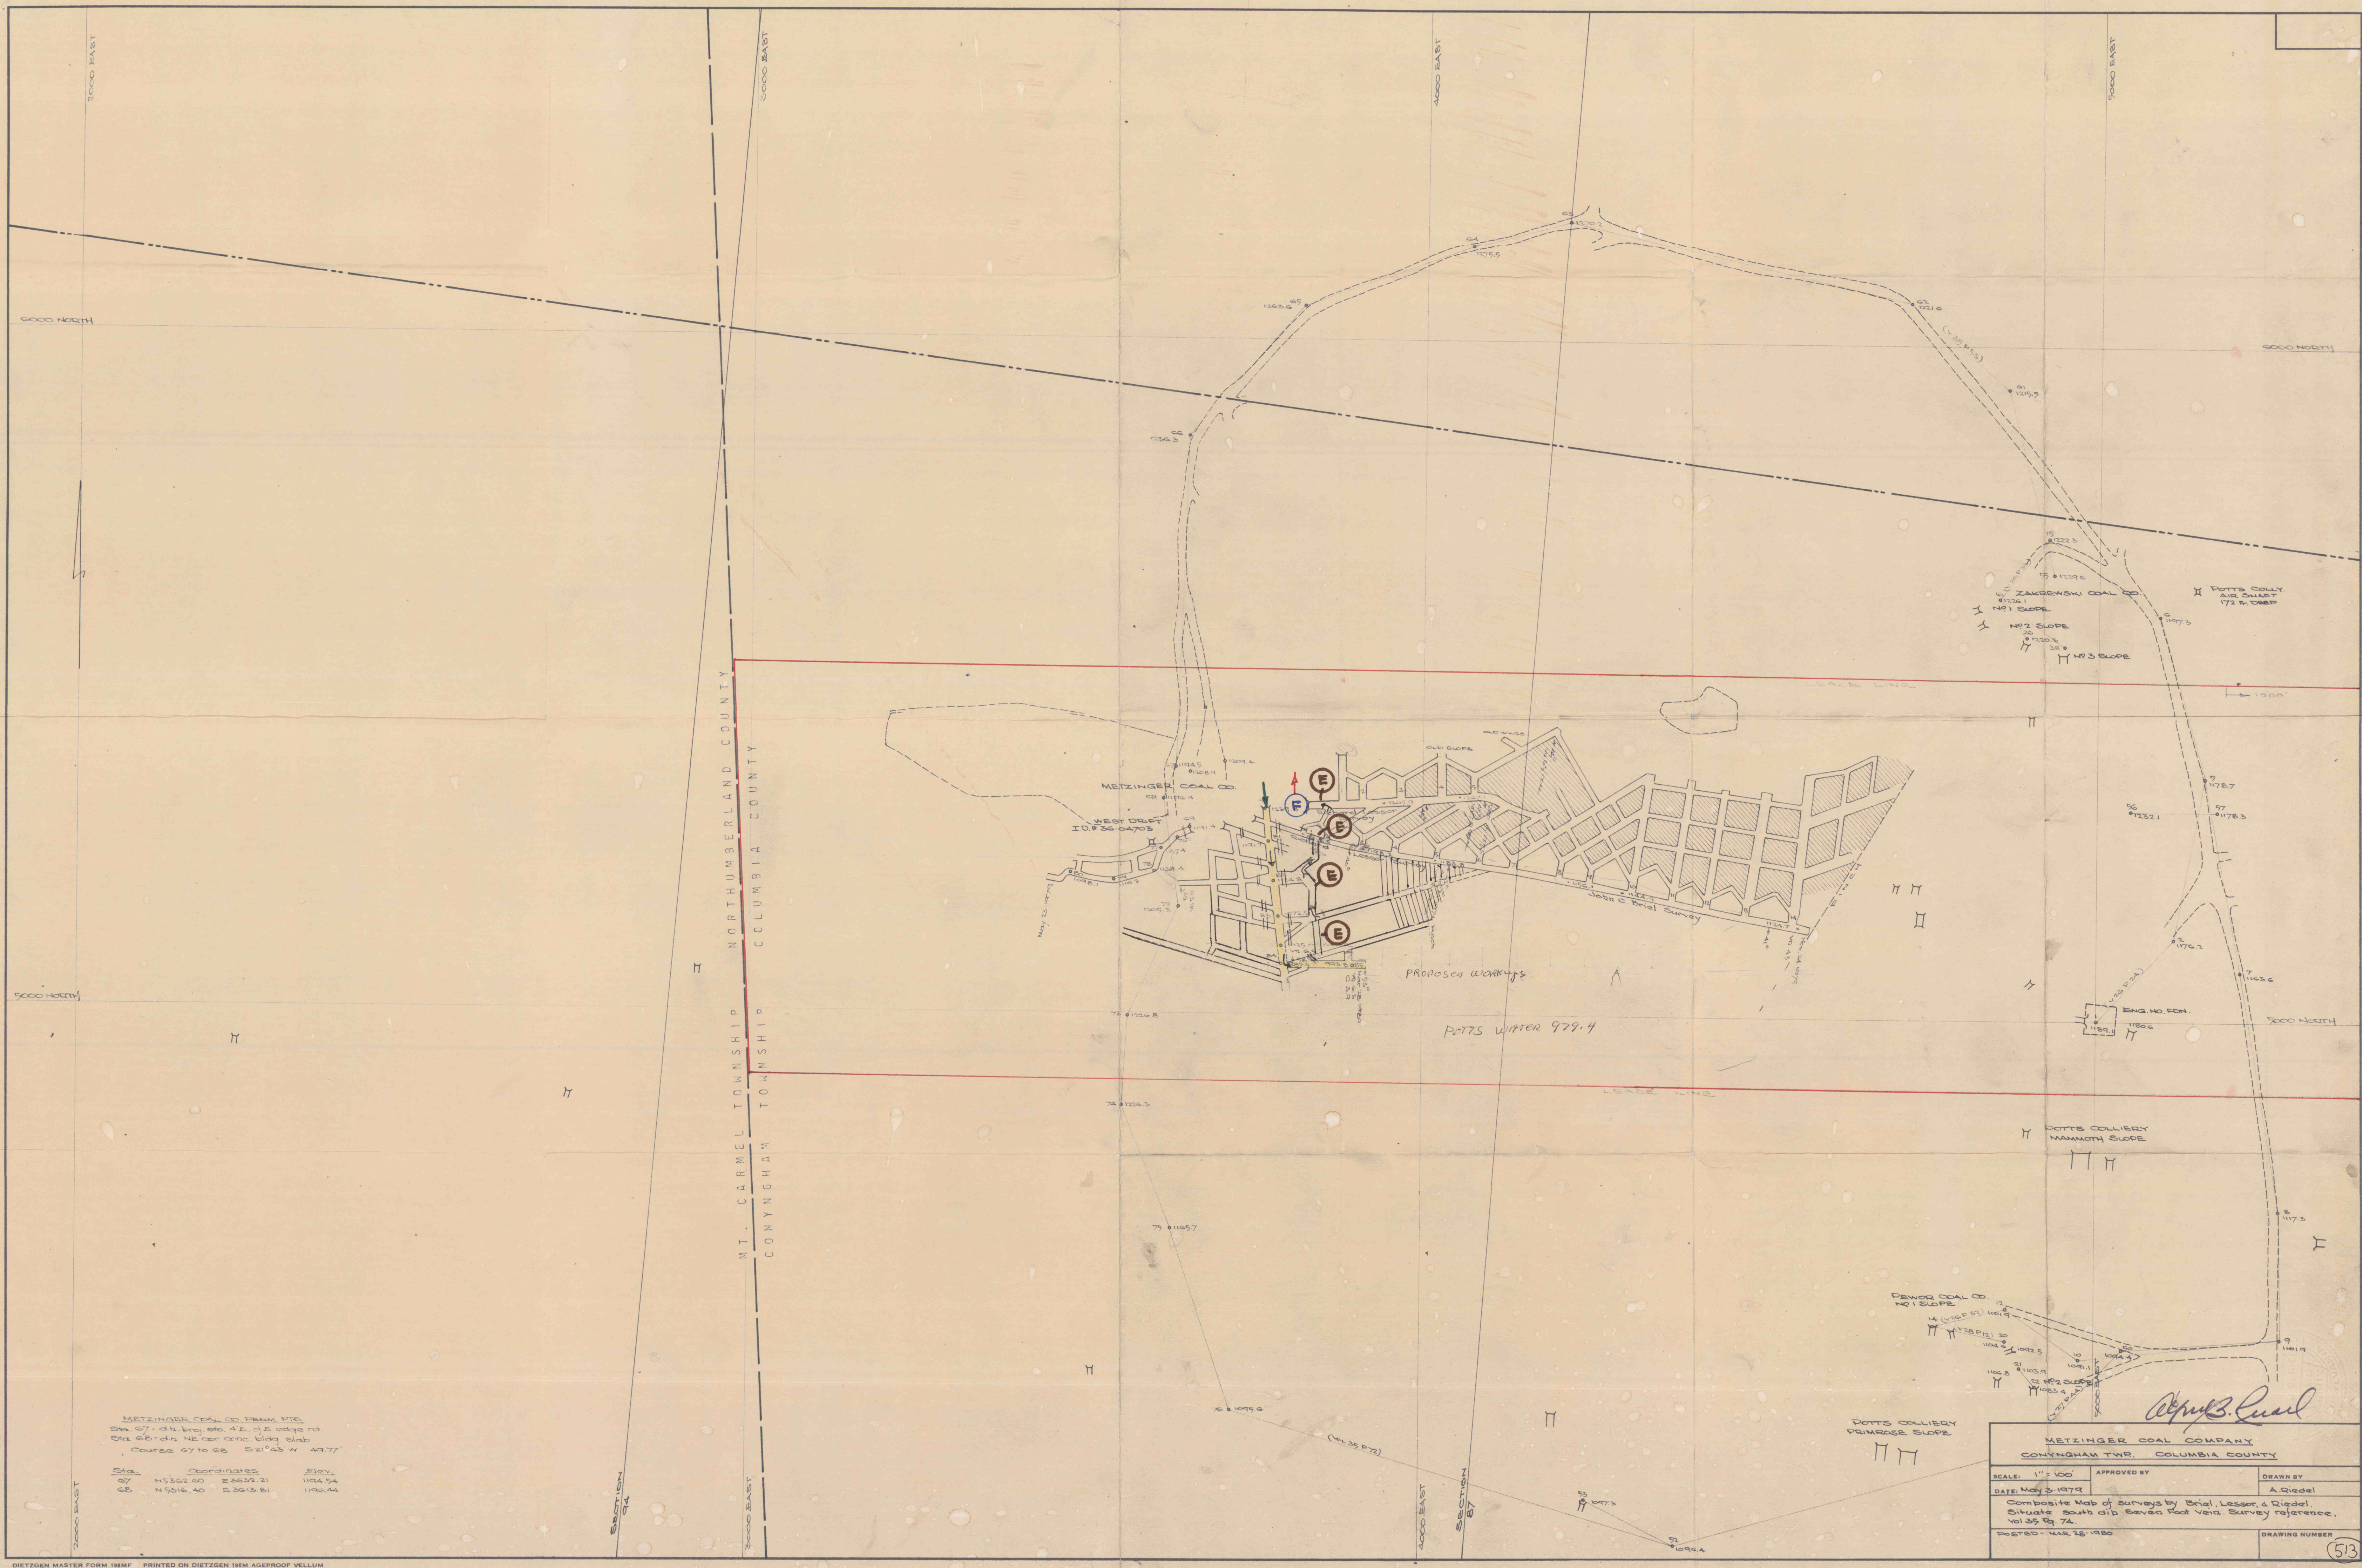

METZINGER COAL CO. DEWM. PIR.
Sta. 67: d.b. Proj. Sta. 4'E. of 1/2 sec. rd.
Sta. 68: d.b. NE cor. sec. bldg. slab
Course 67 to 68 S 21° 43' N 49.77'

Sta.	Coordinates	Elev.

METZINGER COAL COMPANY CONYNGHAM TWP. COLUMBIA COUNTY		
SCALE: 1" = 100'	APPROVED BY	DRAWN BY
DATE: May 3, 1979		A. Riedel
Composite Map of surveys by Briel, Lesser, & Riedel. Situate south dip Seven Foot Vena. Survey reference. Vol. 35 Pg. 74.		
POSTED - MAR. 28, 1980	DRAWING NUMBER	