


TO WEST ROCK SLOPE

TRACED FROM A MAP OF
BEAR VALLEY COLLIERY
 • N^o 14 VEIN, ZERBE, COAL TWP.,
 SHAMOKIN, PA., WESTERN MIDDLE FIELD
 NORTHUMBERLAND COUNTY

14 VEIN
 MOORE COAL
 SCALE 1"=100'

MICHAEL KROLL TRACT

ASSOCIATE LANDS

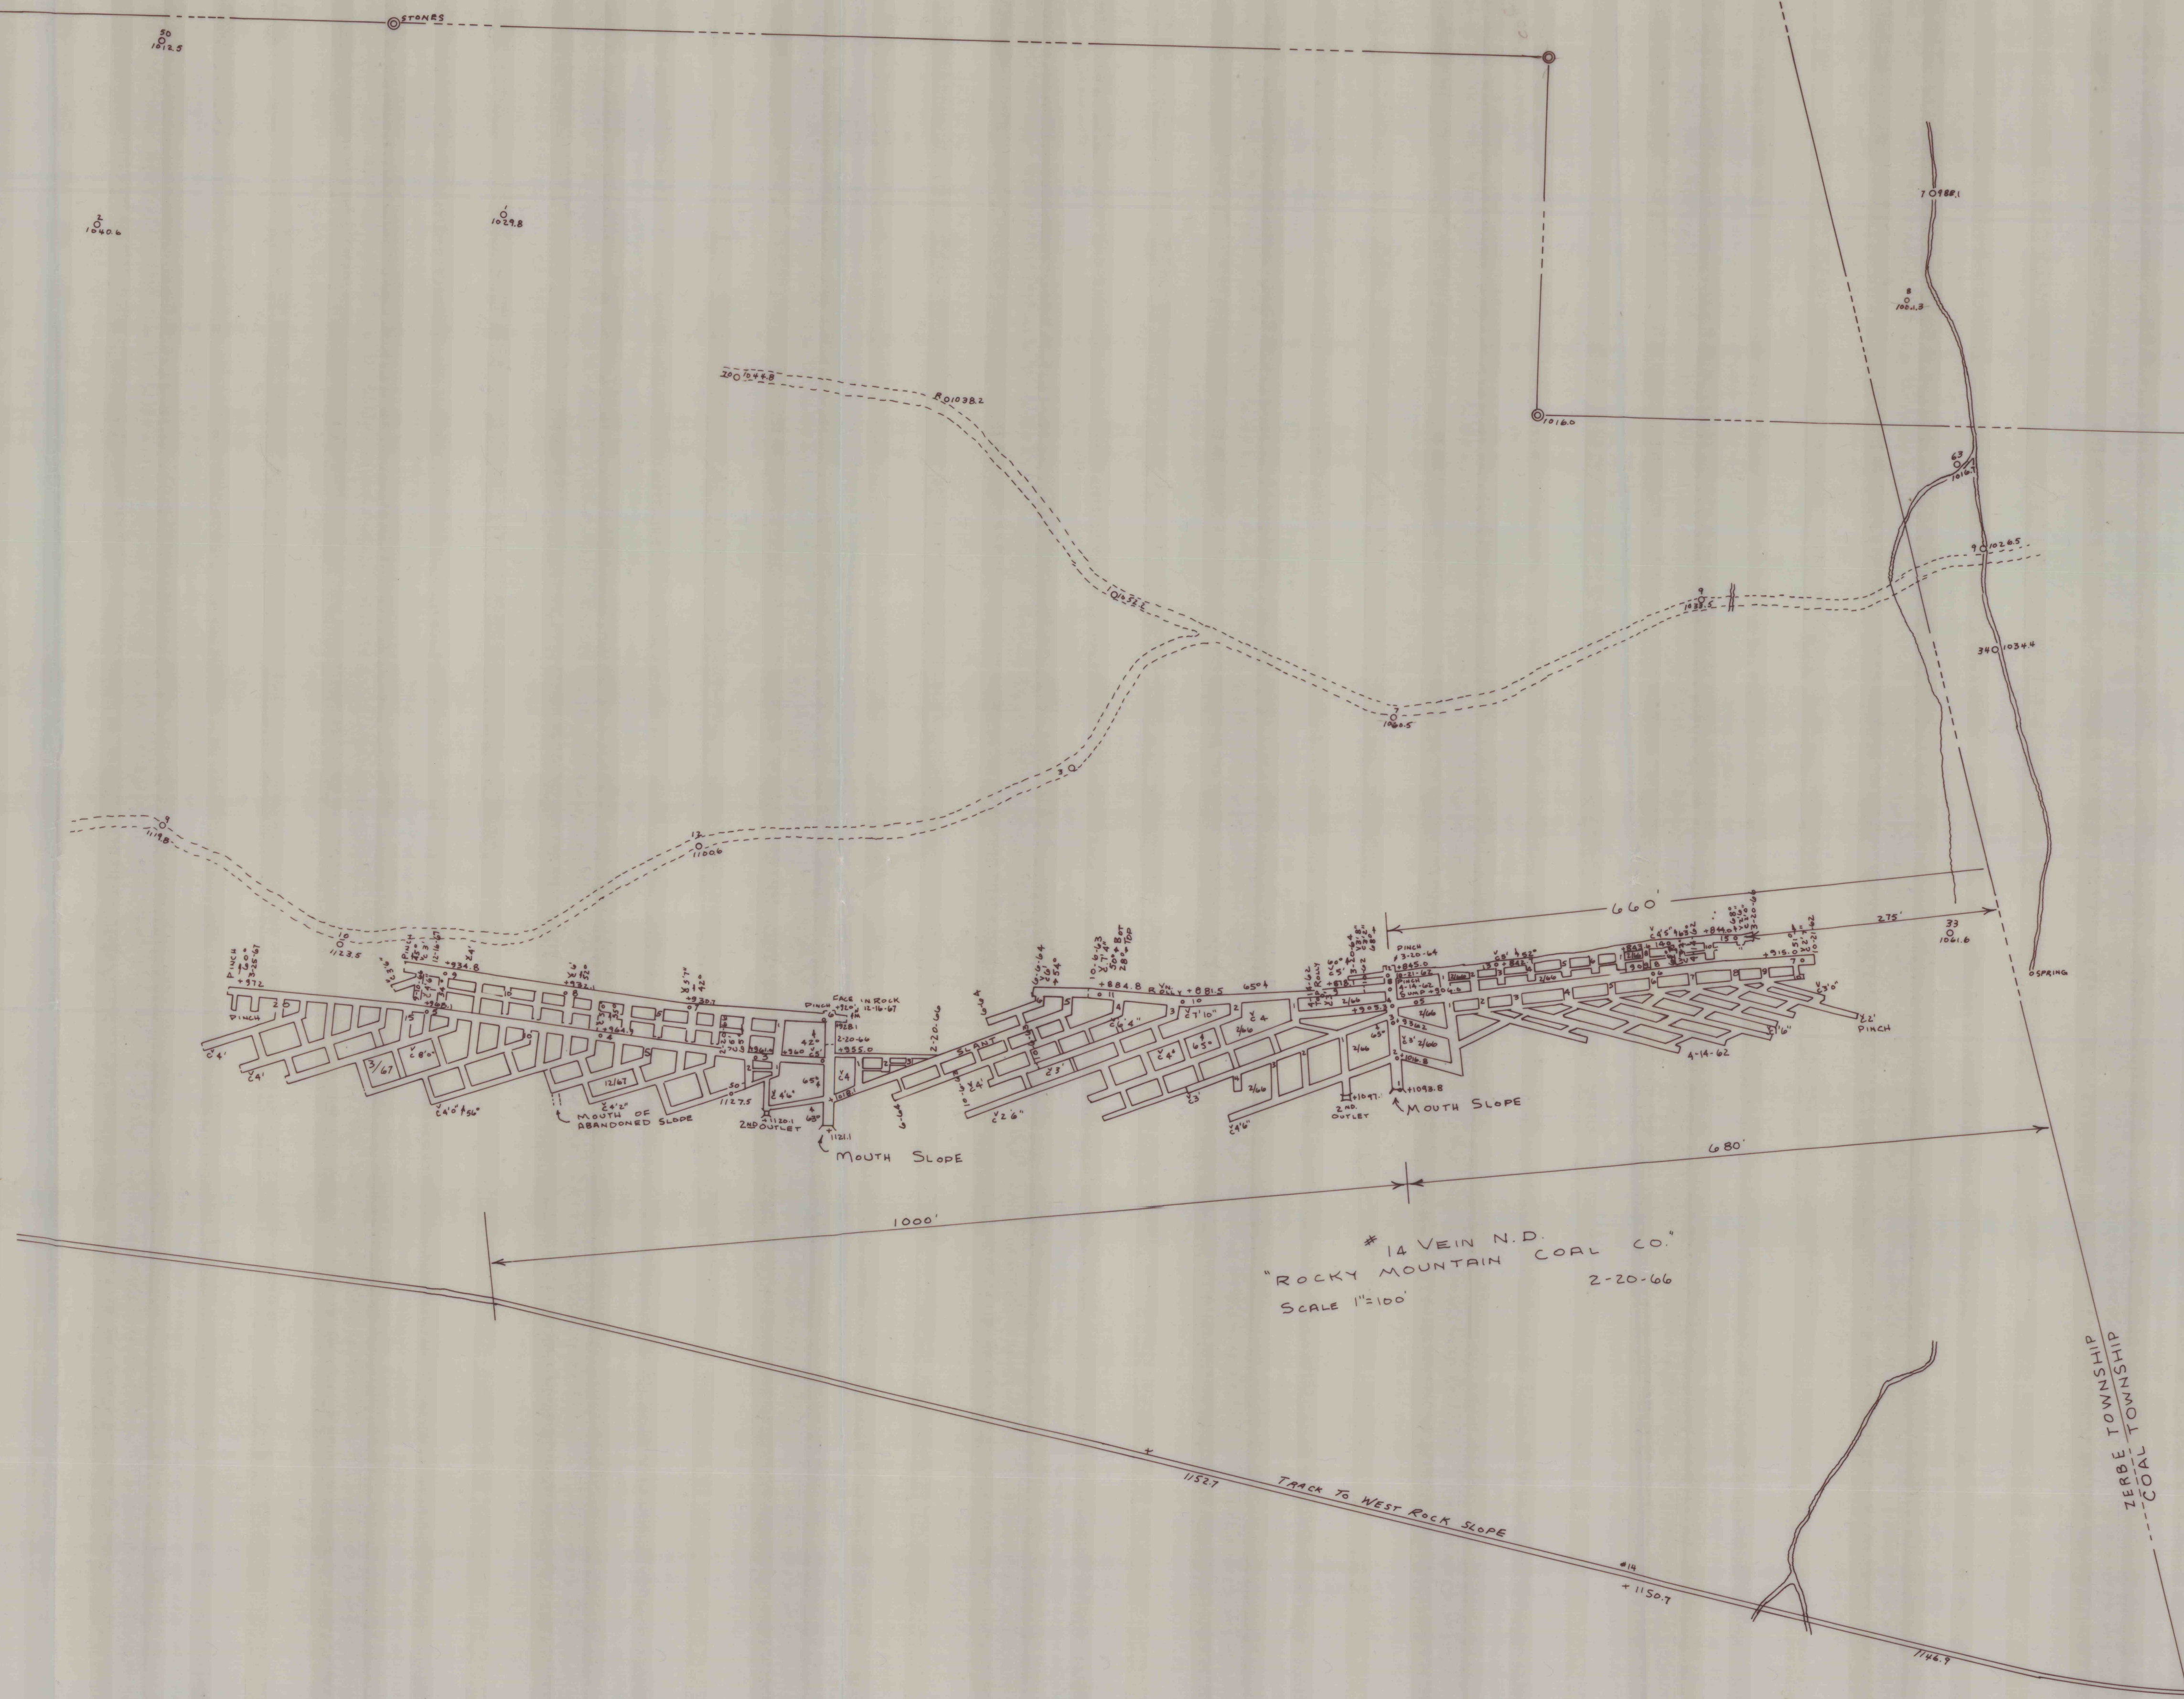

14 VEIN N.D. COAL CO.
 "ROCKY MOUNTAIN"
 SCALE 1"=100'

ZERBE TOWNSHIP
 COAL TOWNSHIP

BERNARD HUBLEY TRACT

RECEIVED
 MAR 20 1961
 U.S. DEPT. OF LABOR
 WASHINGTON, D.C.