


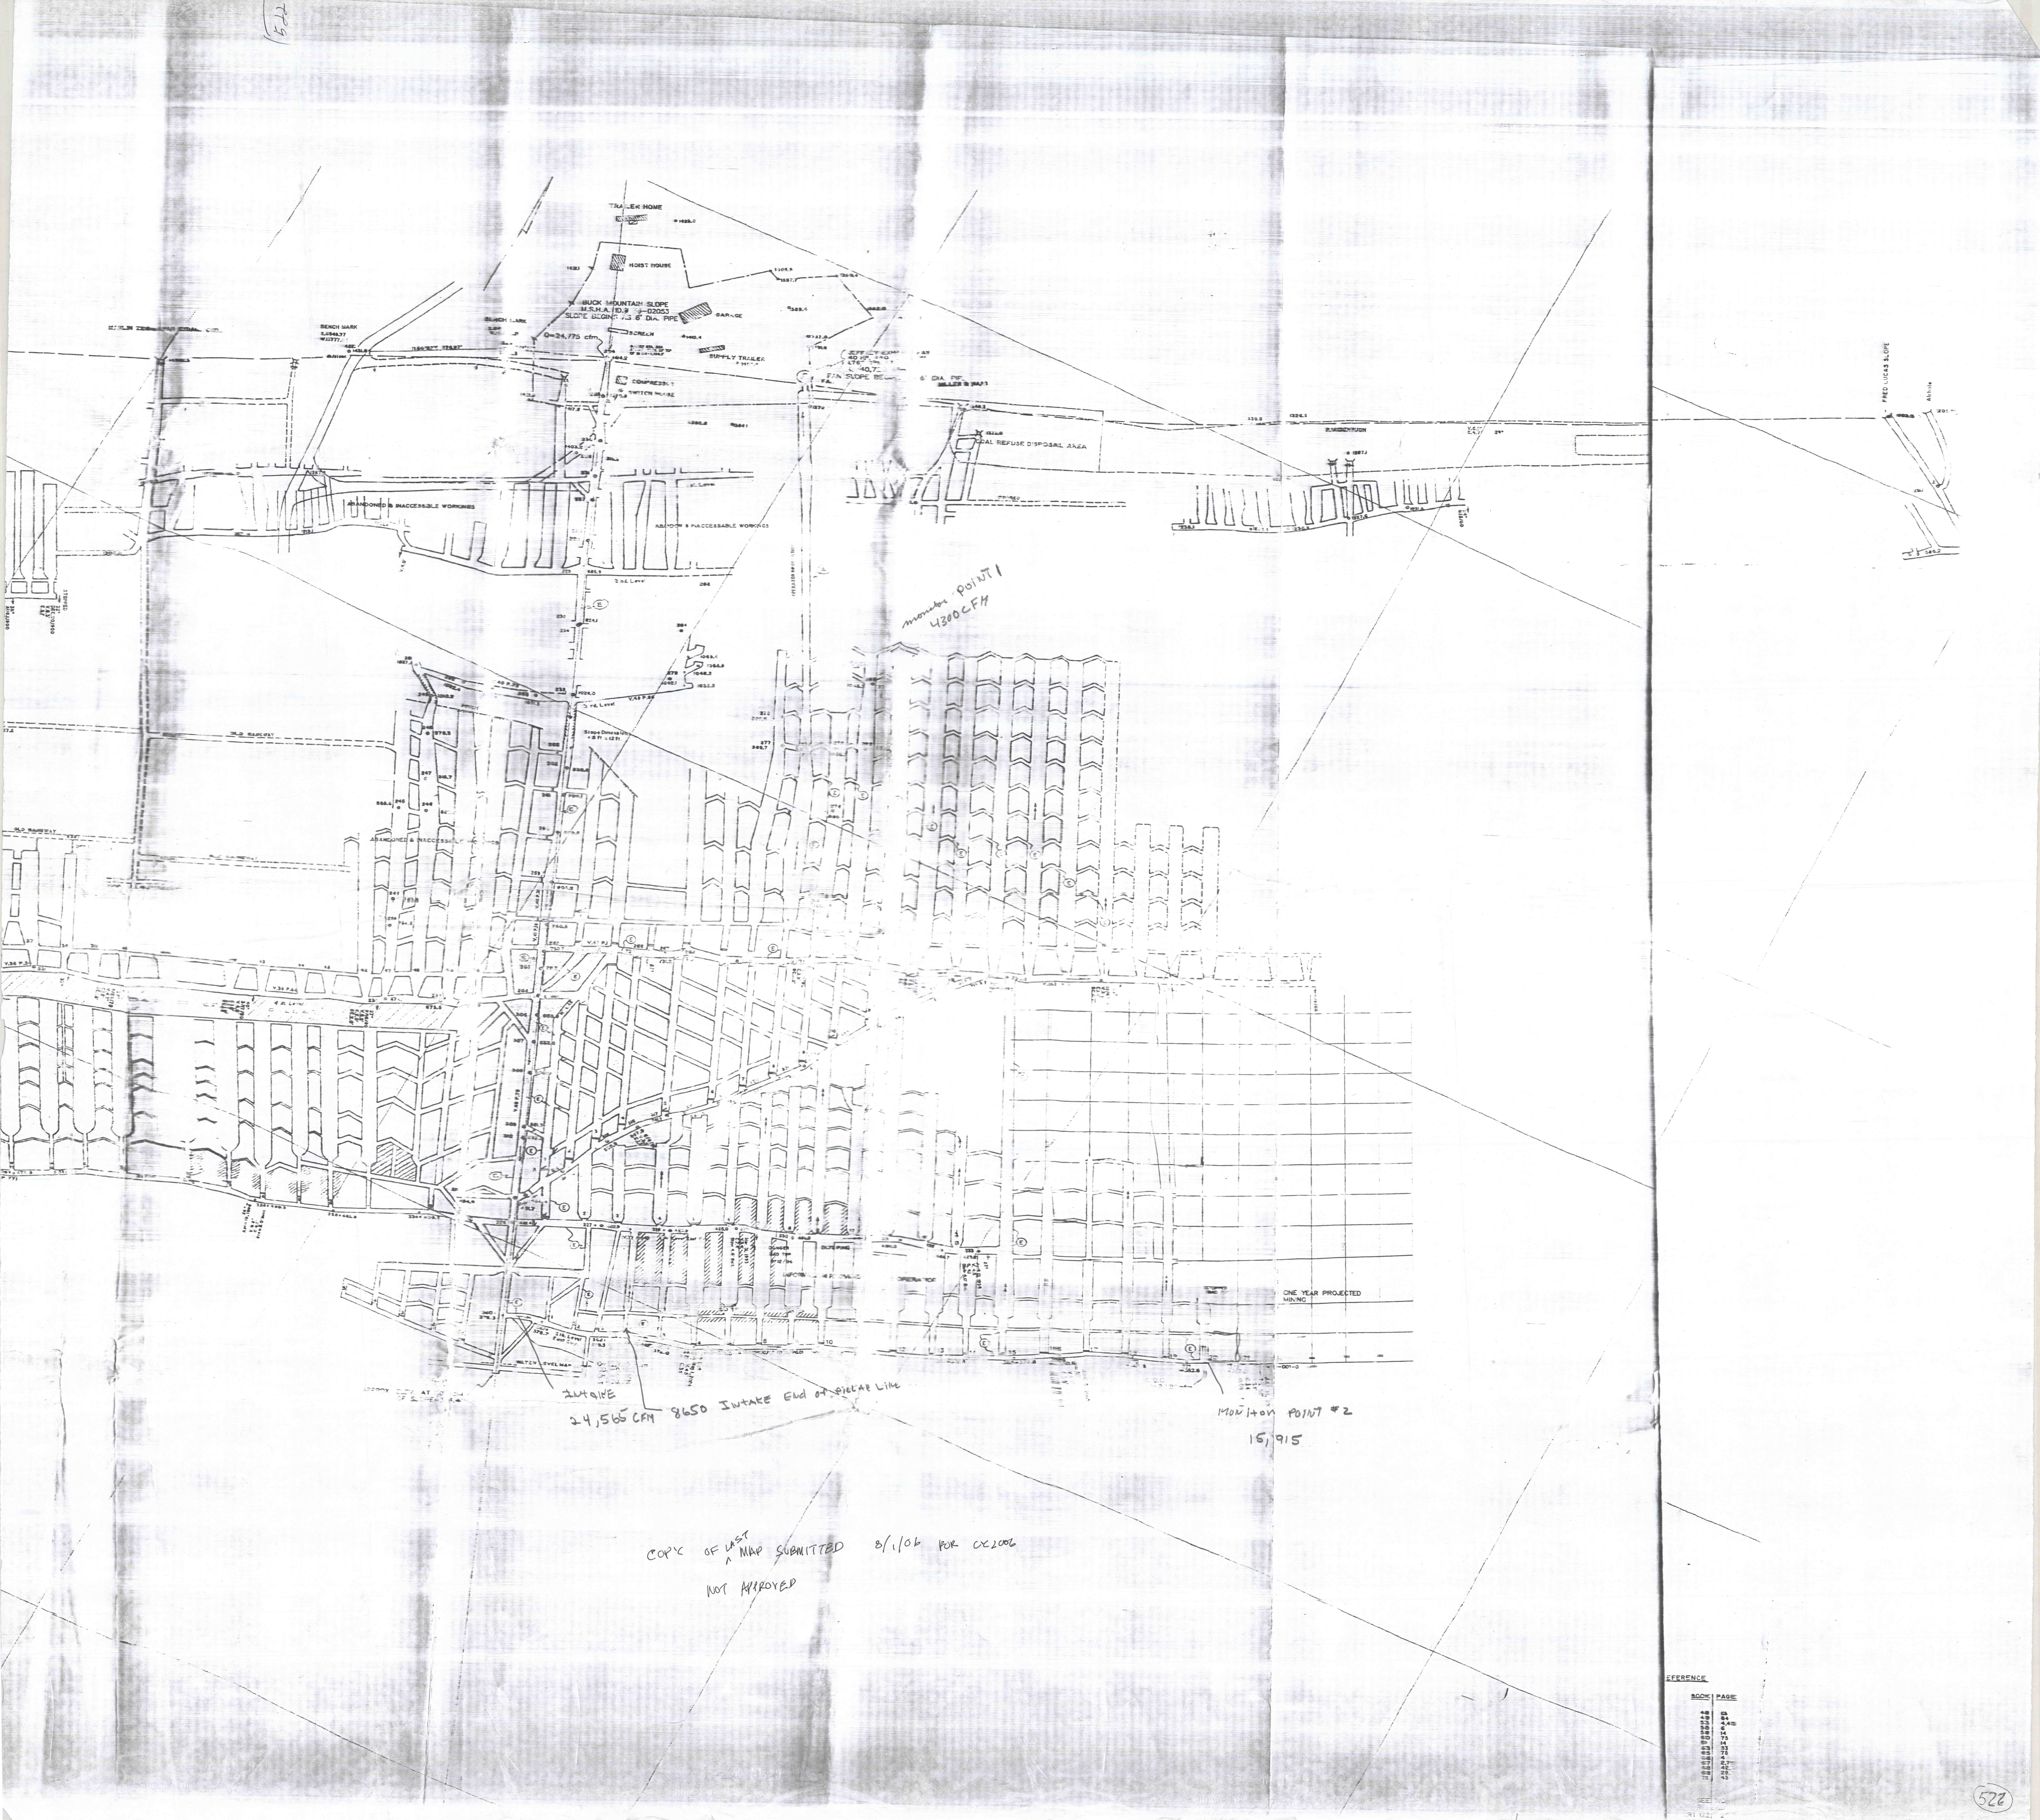

COPY OF LAST
A MAP SUBMITTED 8/1/06 FOR CC2006
NOT APPROVED

BOOK	PAGE
