
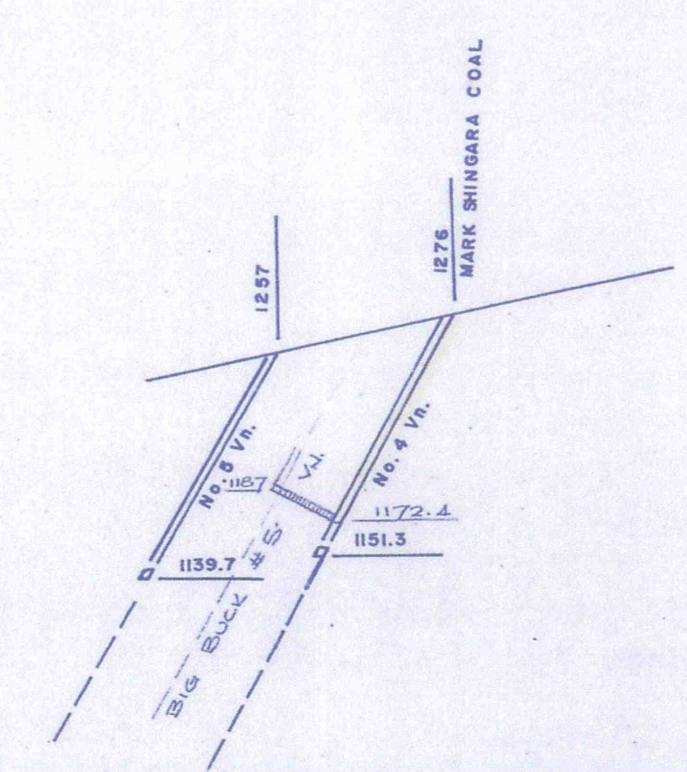


Ventilation Symbols

- Main Fan
- Auxiliary Fan
- Intake Air
- Return Air
- Stoppings
- Air Ridge
- Regulator
- Fan Door
- Quantity of Air
- Water Gauge
- Backsight
- Meander Evaluation Point
- Station
- Active Workings (yellow)

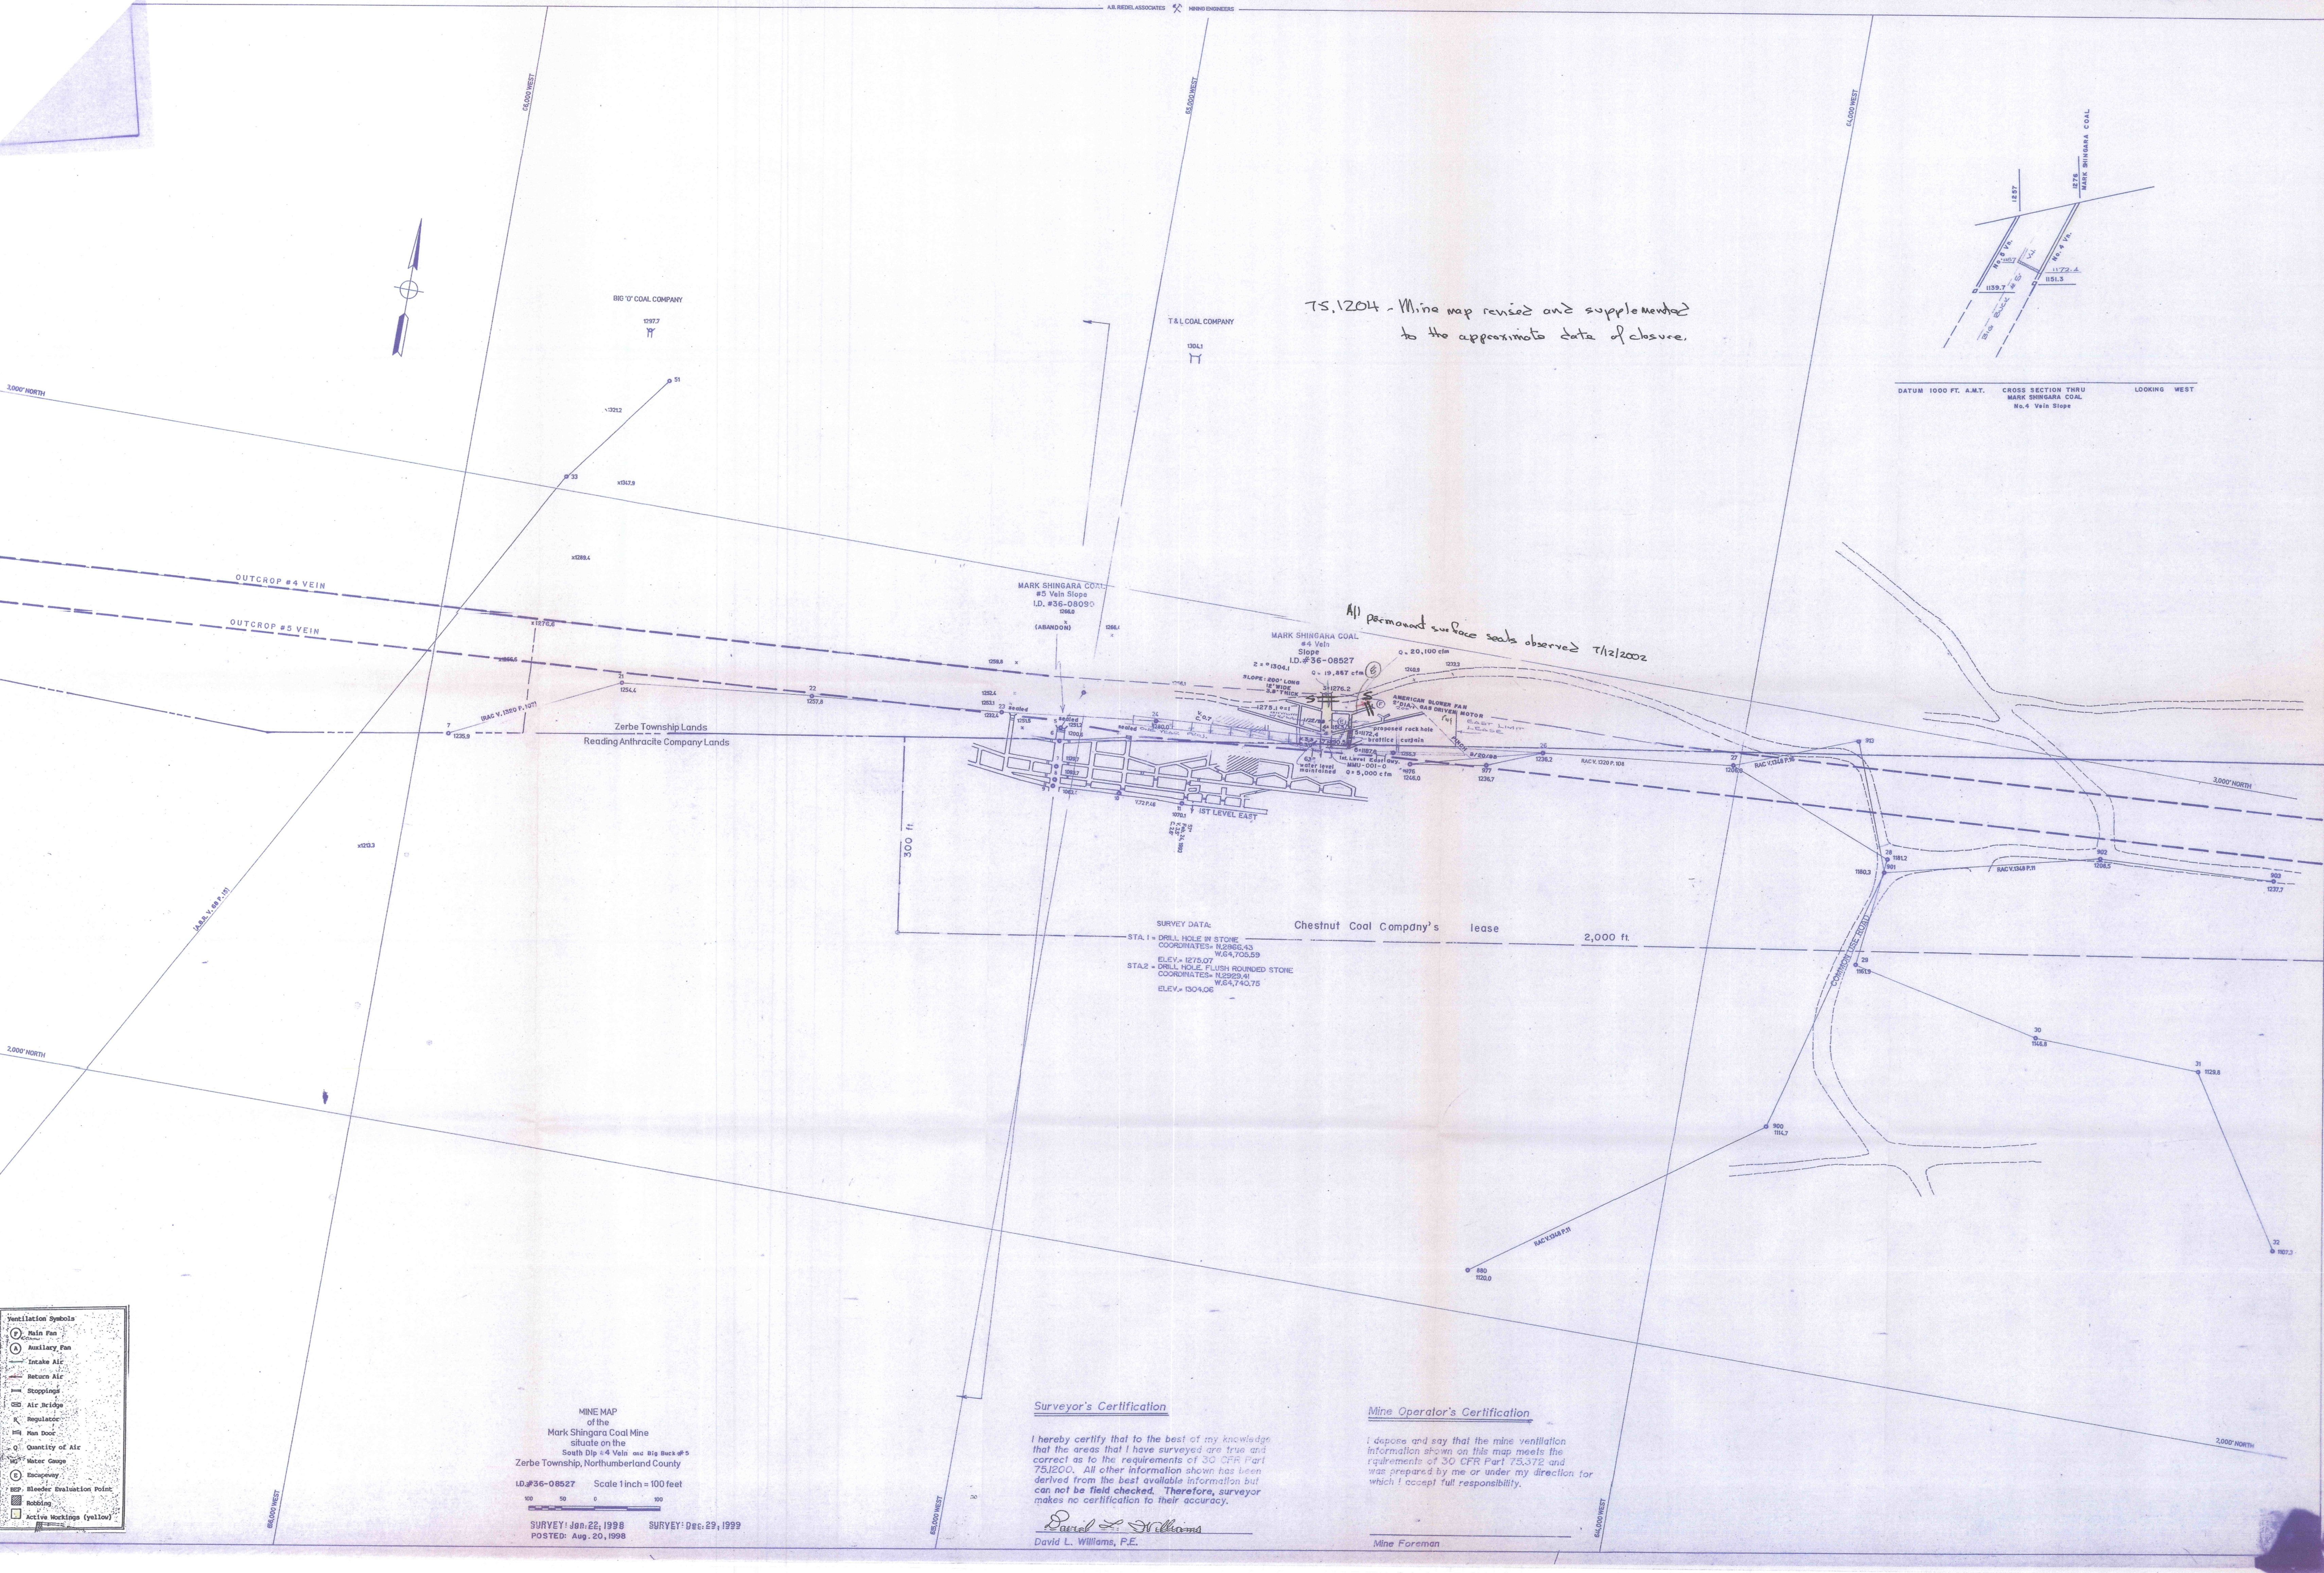

DATUM 1000 FT. A.M.T. CROSS SECTION THRU MARK SHINGARA COAL No. 4 Vein Slope LOOKING WEST

TS. 1204 - Mine map revised and supplemented to the approximate date of closure.

All permanent surface seals observed 7/12/2002

SURVEY DATA:
 STA. 1 - DRILL HOLE IN STONE
 COORDINATES: N. 2966.43
 W. 64703.59
 ELEV. - 1275.07
 STA. 2 - DRILL HOLE, FLUSH ROUNDED STONE
 COORDINATES: N. 2929.41
 W. 64743.75
 ELEV. - 1304.06

MINE MAP
 of the
 Mark Shingara Coal Mine
 situated on the
 South Dip #4 Vein and Big Buck #5
 Zerbe Township, Northumberland County
 ID. #36-08527 Scale 1 inch = 100 feet
 SURVEY: Jan. 22, 1998 SURVEY: Dec. 29, 1999
 POSTED: Aug. 20, 1998

Surveyor's Certification
 I hereby certify that to the best of my knowledge that the areas that I have surveyed are true and correct as to the requirements of 30 CFR Part 75.1200. All other information shown has been derived from the best available information but can not be field checked. Therefore, surveyor makes no certification to their accuracy.
David L. Williams
 David L. Williams, P.E.

Mine Operator's Certification
 I depose and say that the mine ventilation information shown on this map meets the requirements of 30 CFR Part 75.372 and was prepared by me or under my direction for which I accept full responsibility.

 Mine Foreman