Shamokin office
Files - 10-26-76

N

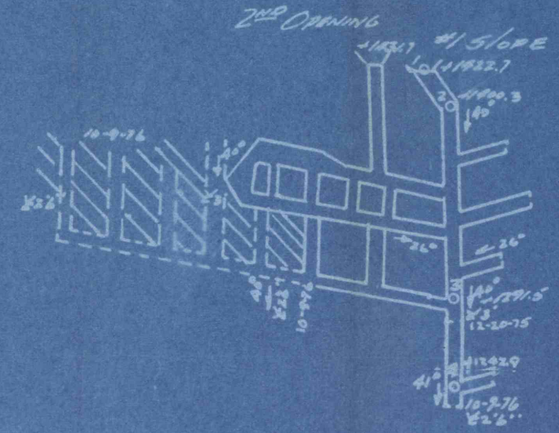

CRESS COAL CO #1 SLOPE
SEVEN FOOT VEIN

1" = 100'

~~12-20-75~~
10-9-76

567