


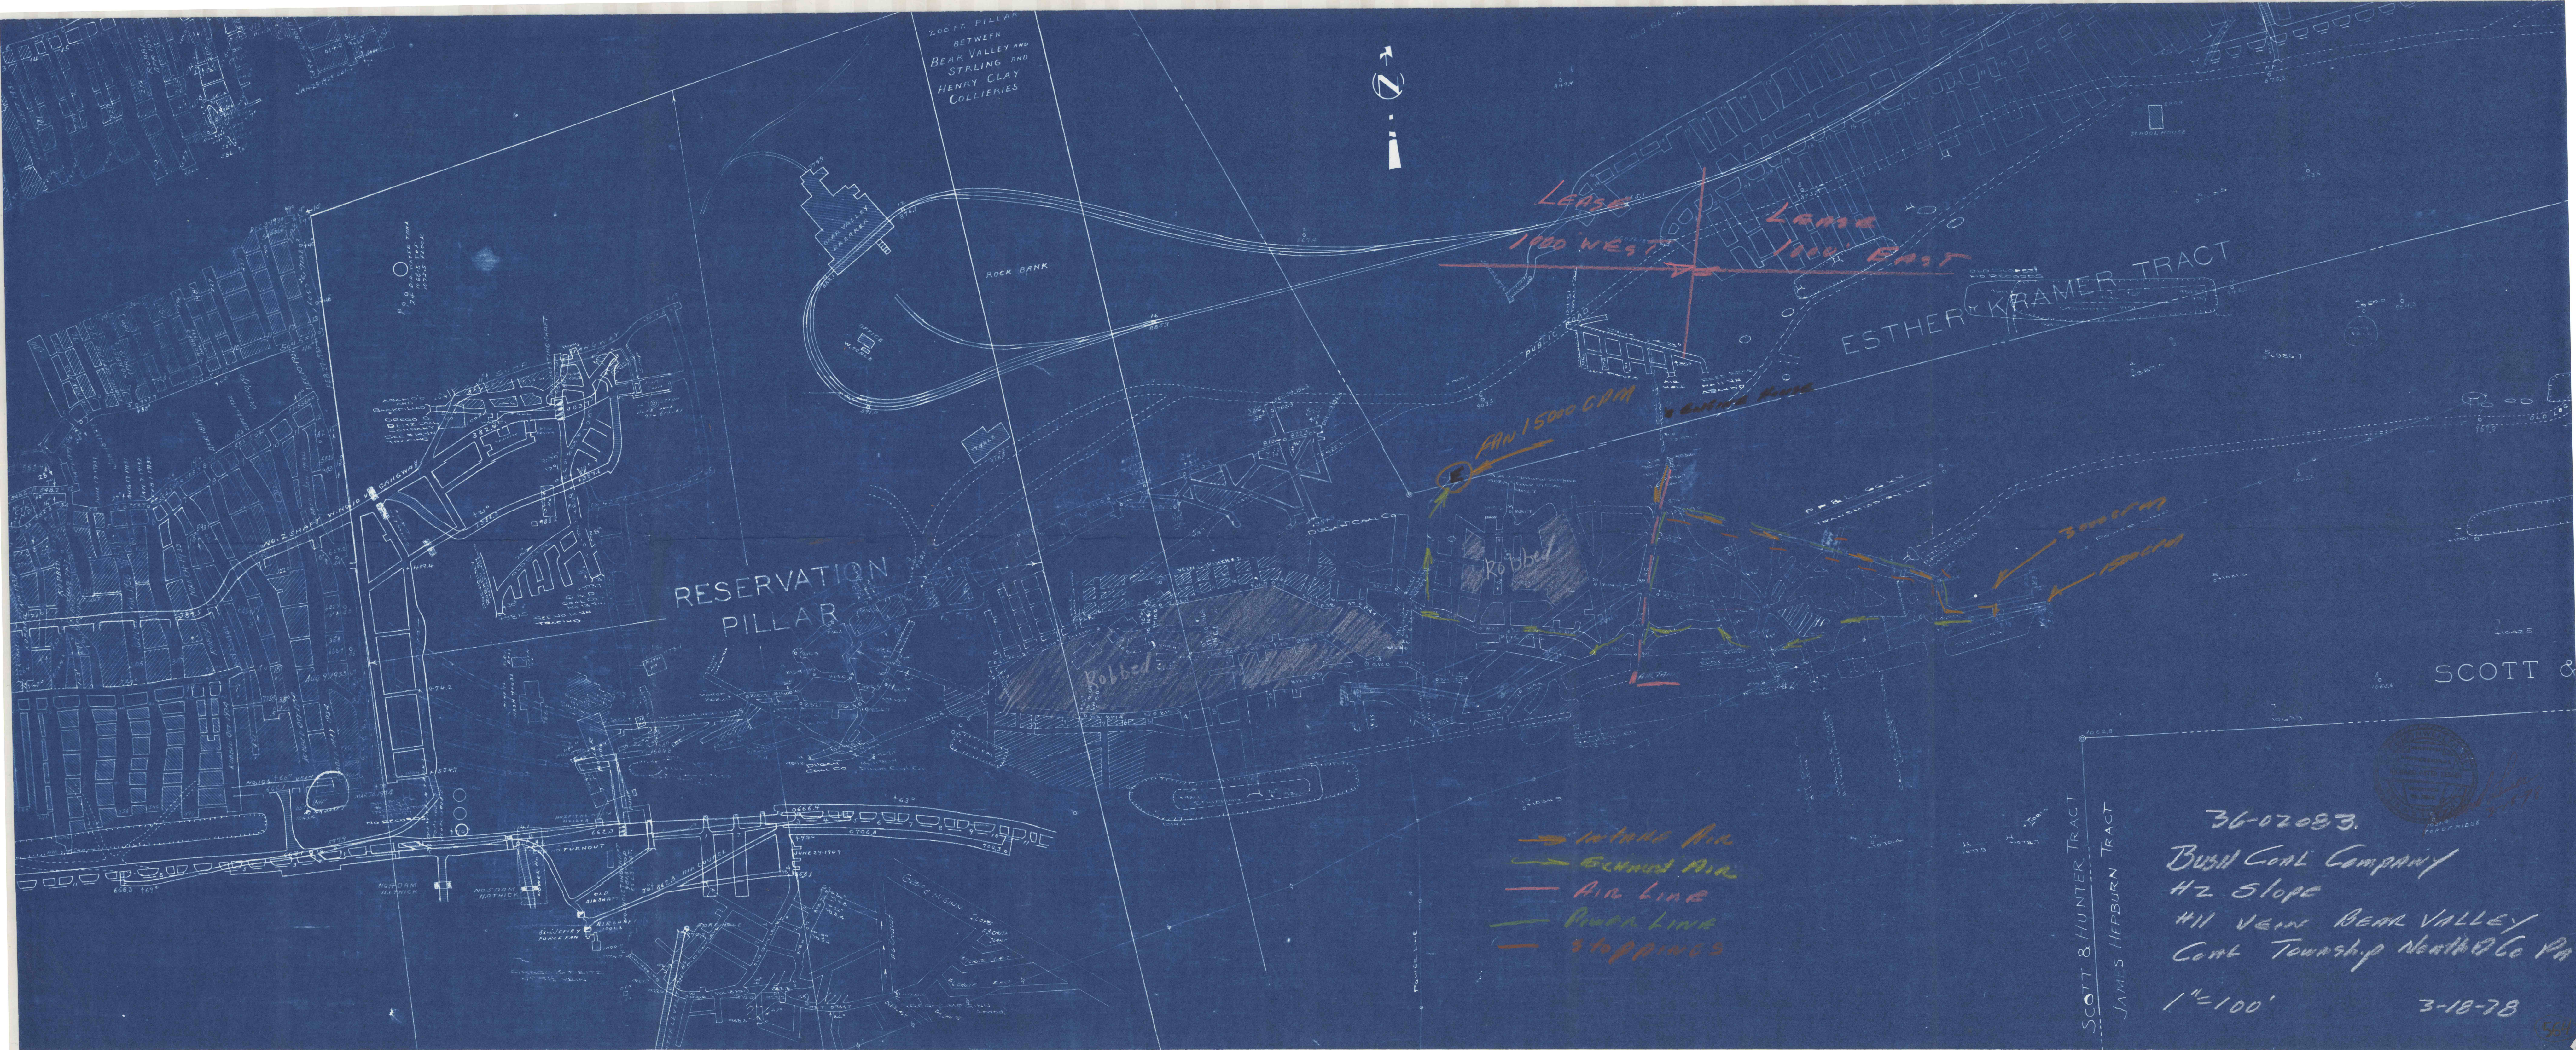

200 FT. PILLAR
BETWEEN
BEAR VALLEY AND
STRLING AND
HENRY CLAY
COLLIERIES



LEASE
1000 WEST
1000 EAST

ESTHER KRAMER TRACT

FAN 15000 CPM

3000 CPM
10000 CPM

RESERVATION
PILLAR

Robbed

- Intake Air
- Exhaust Air
- Air Line
- Pneum. Line
- Shoppings

SCOTT &

SCOTT & HUNTER TRACT
JAMES HEPBURN TRACT

36-02083.
BUSH COAL COMPANY
#2 Slope
#11 VEIN BEAR VALLEY
Coal Township North 26 Co Pa
1"=100'
3-18-78

