

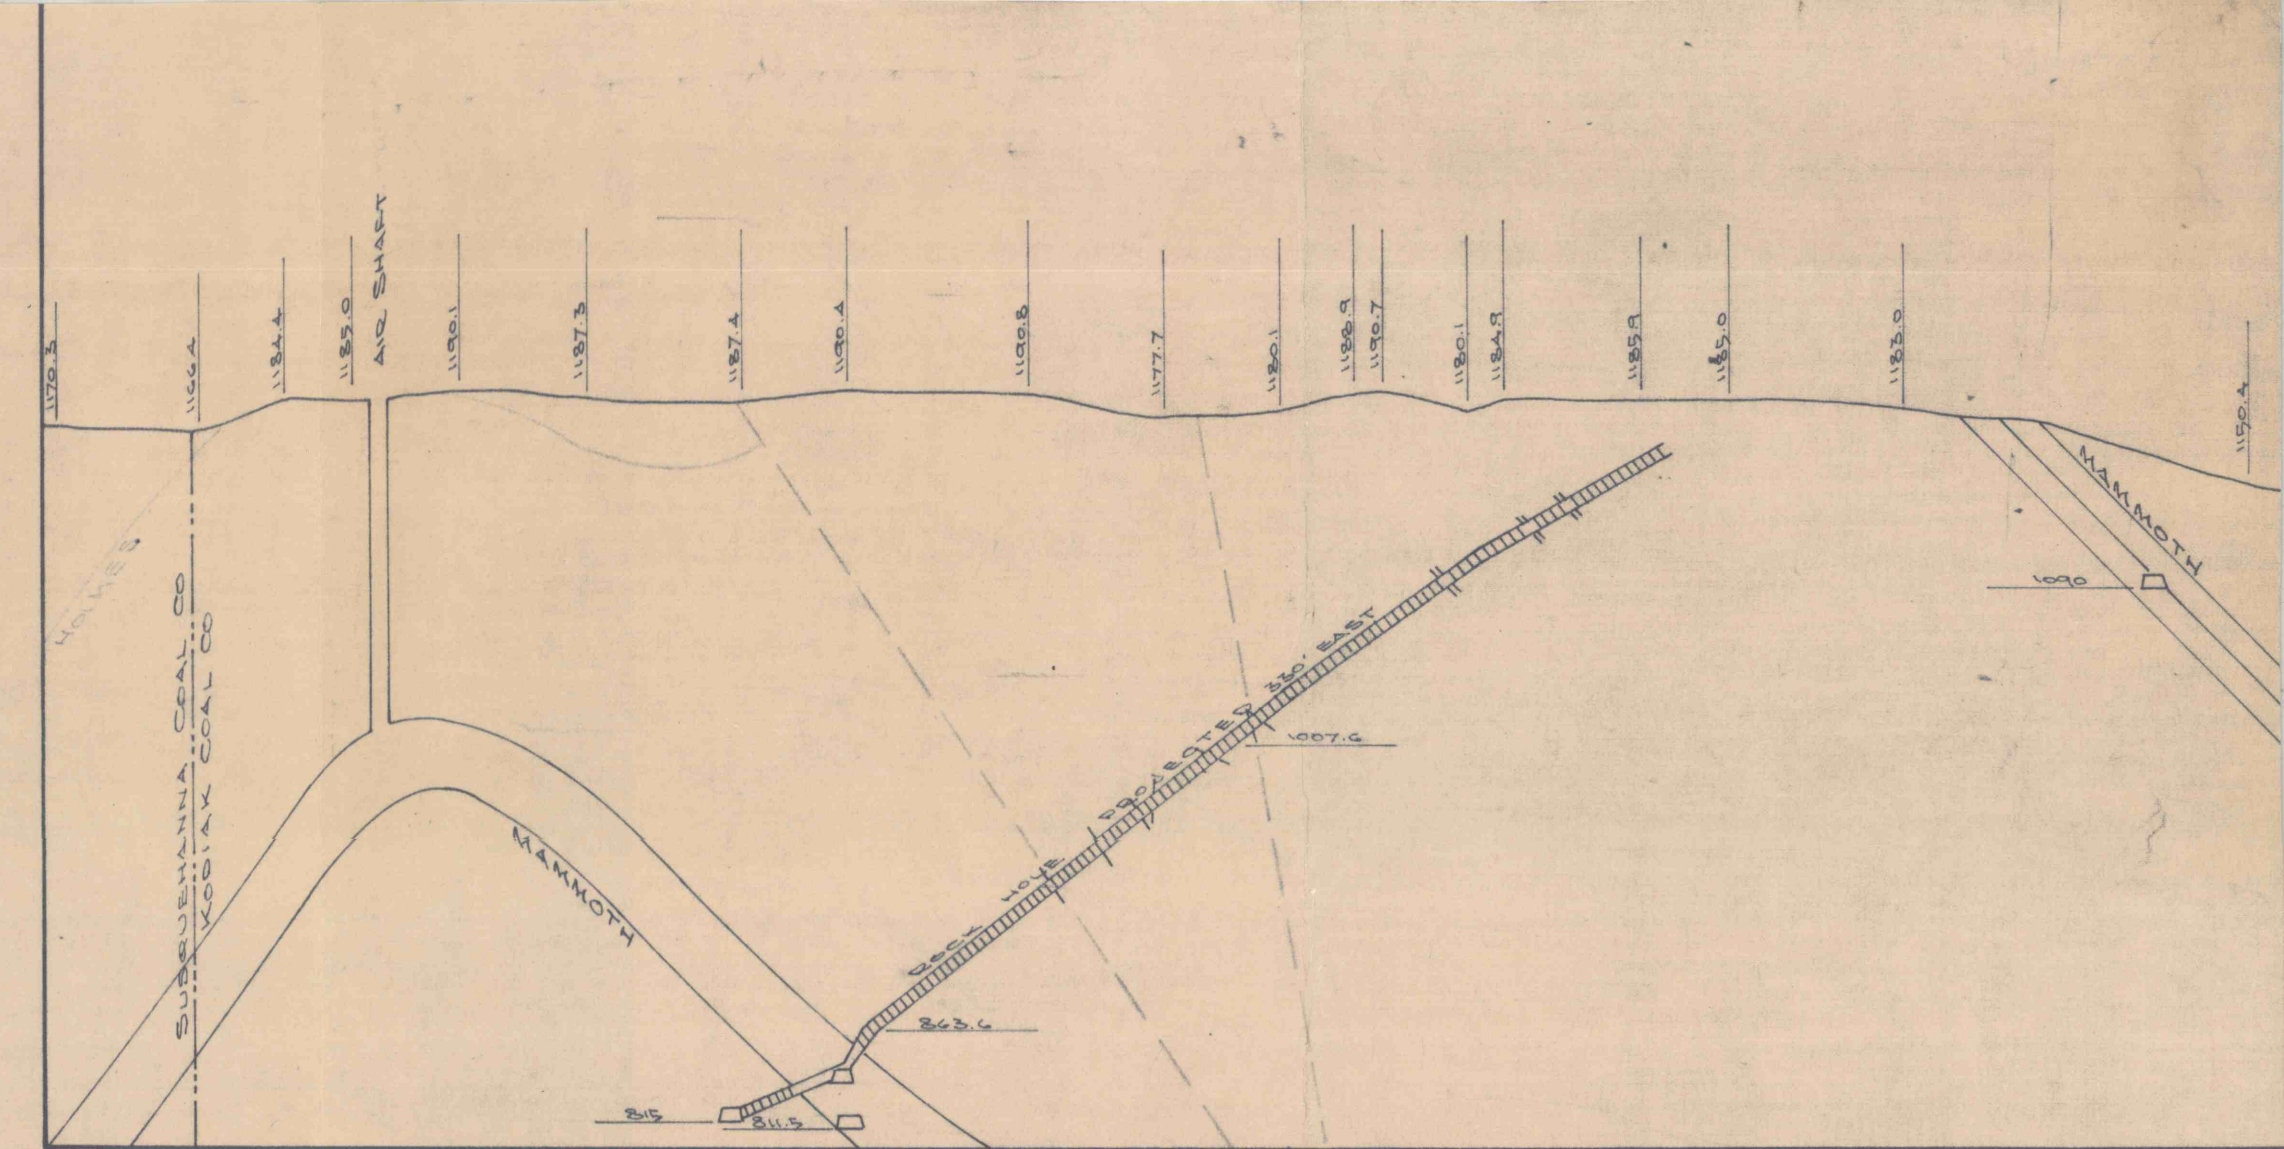


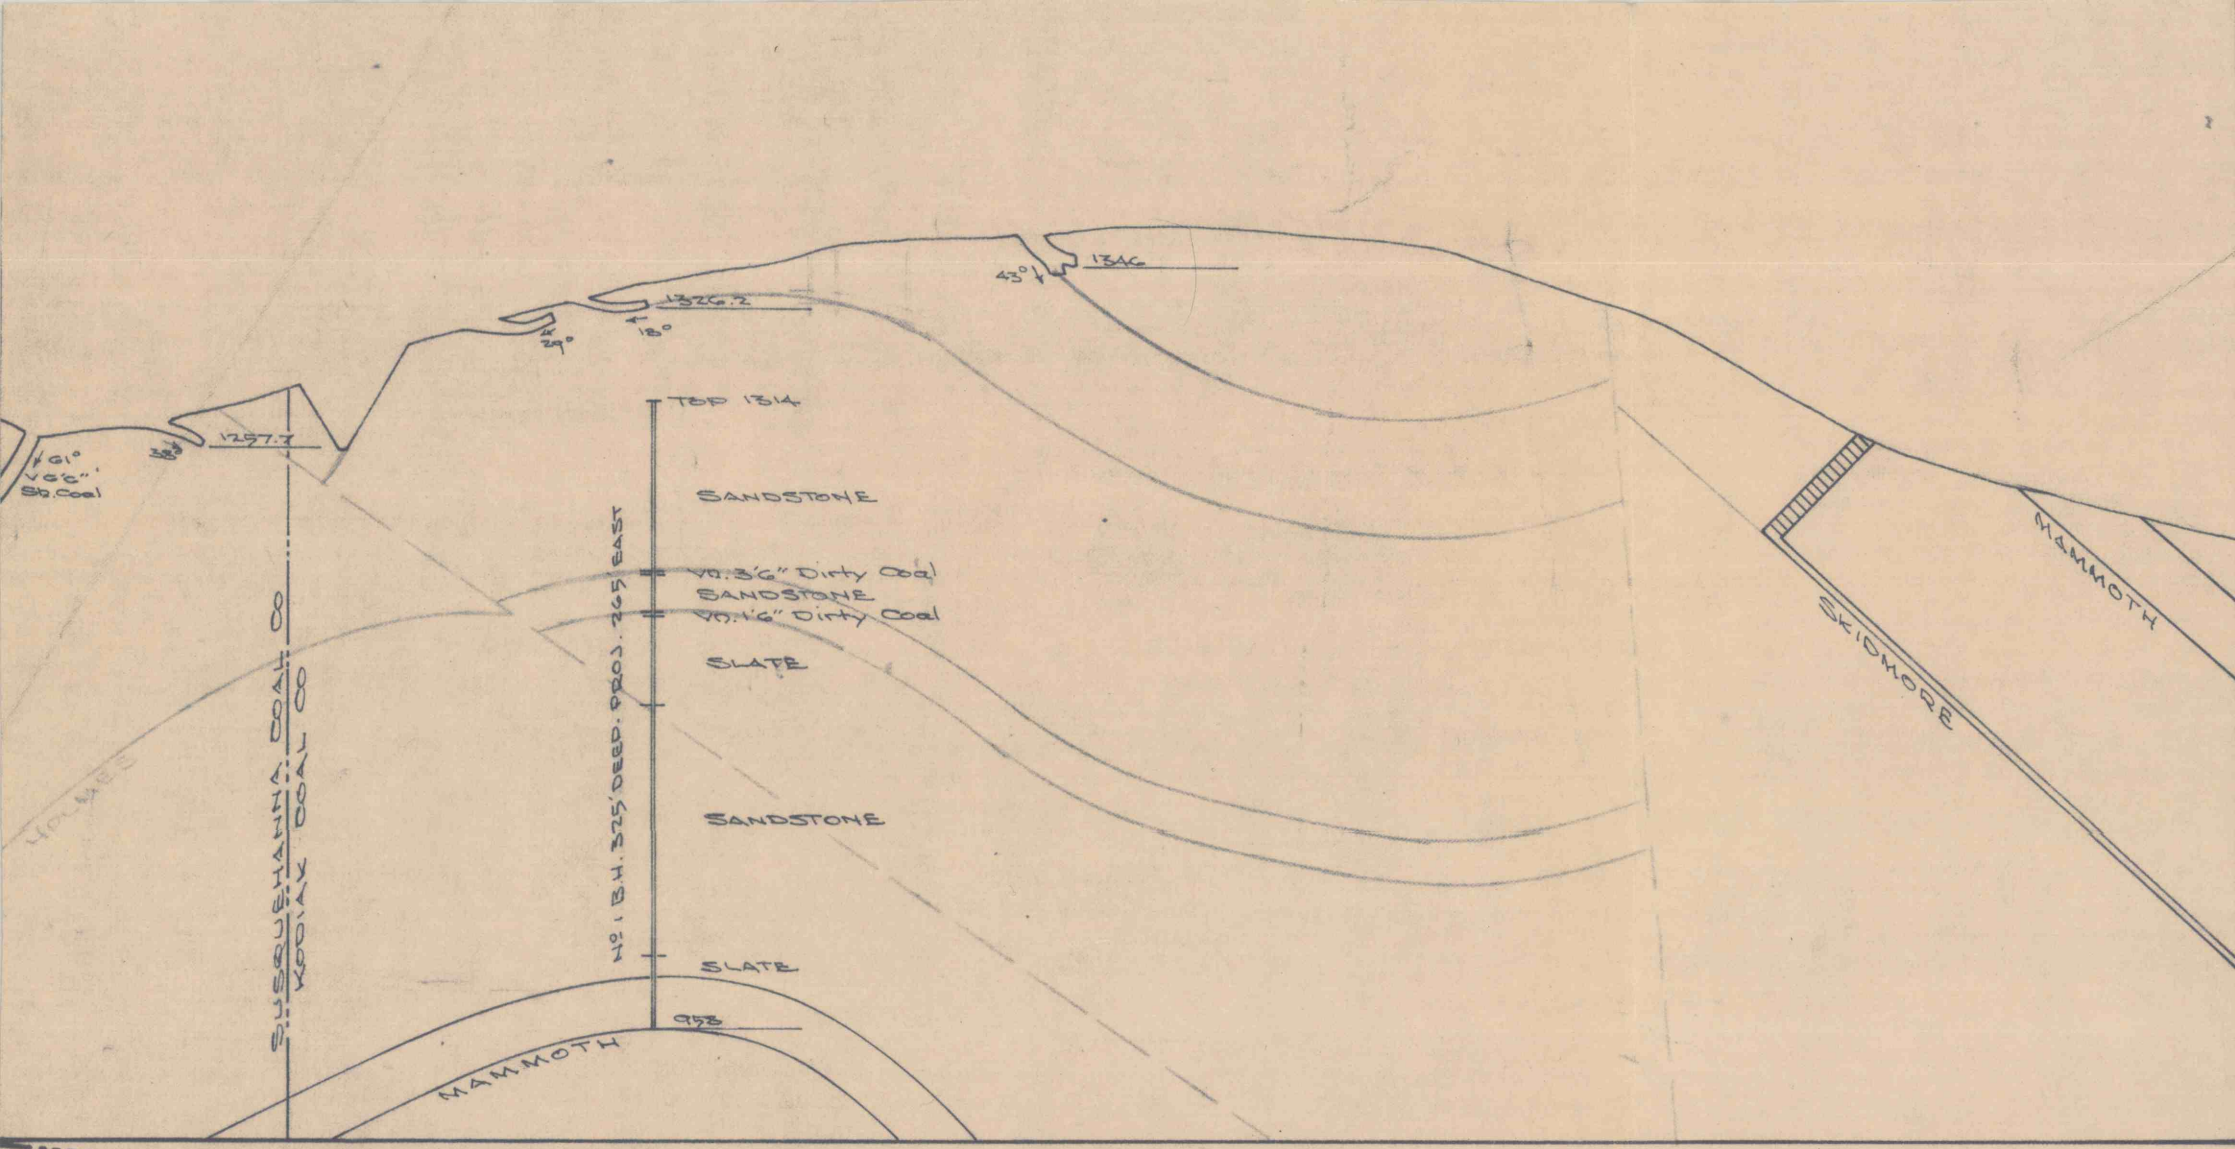

S U S Q U E H A N N A C O A L C O

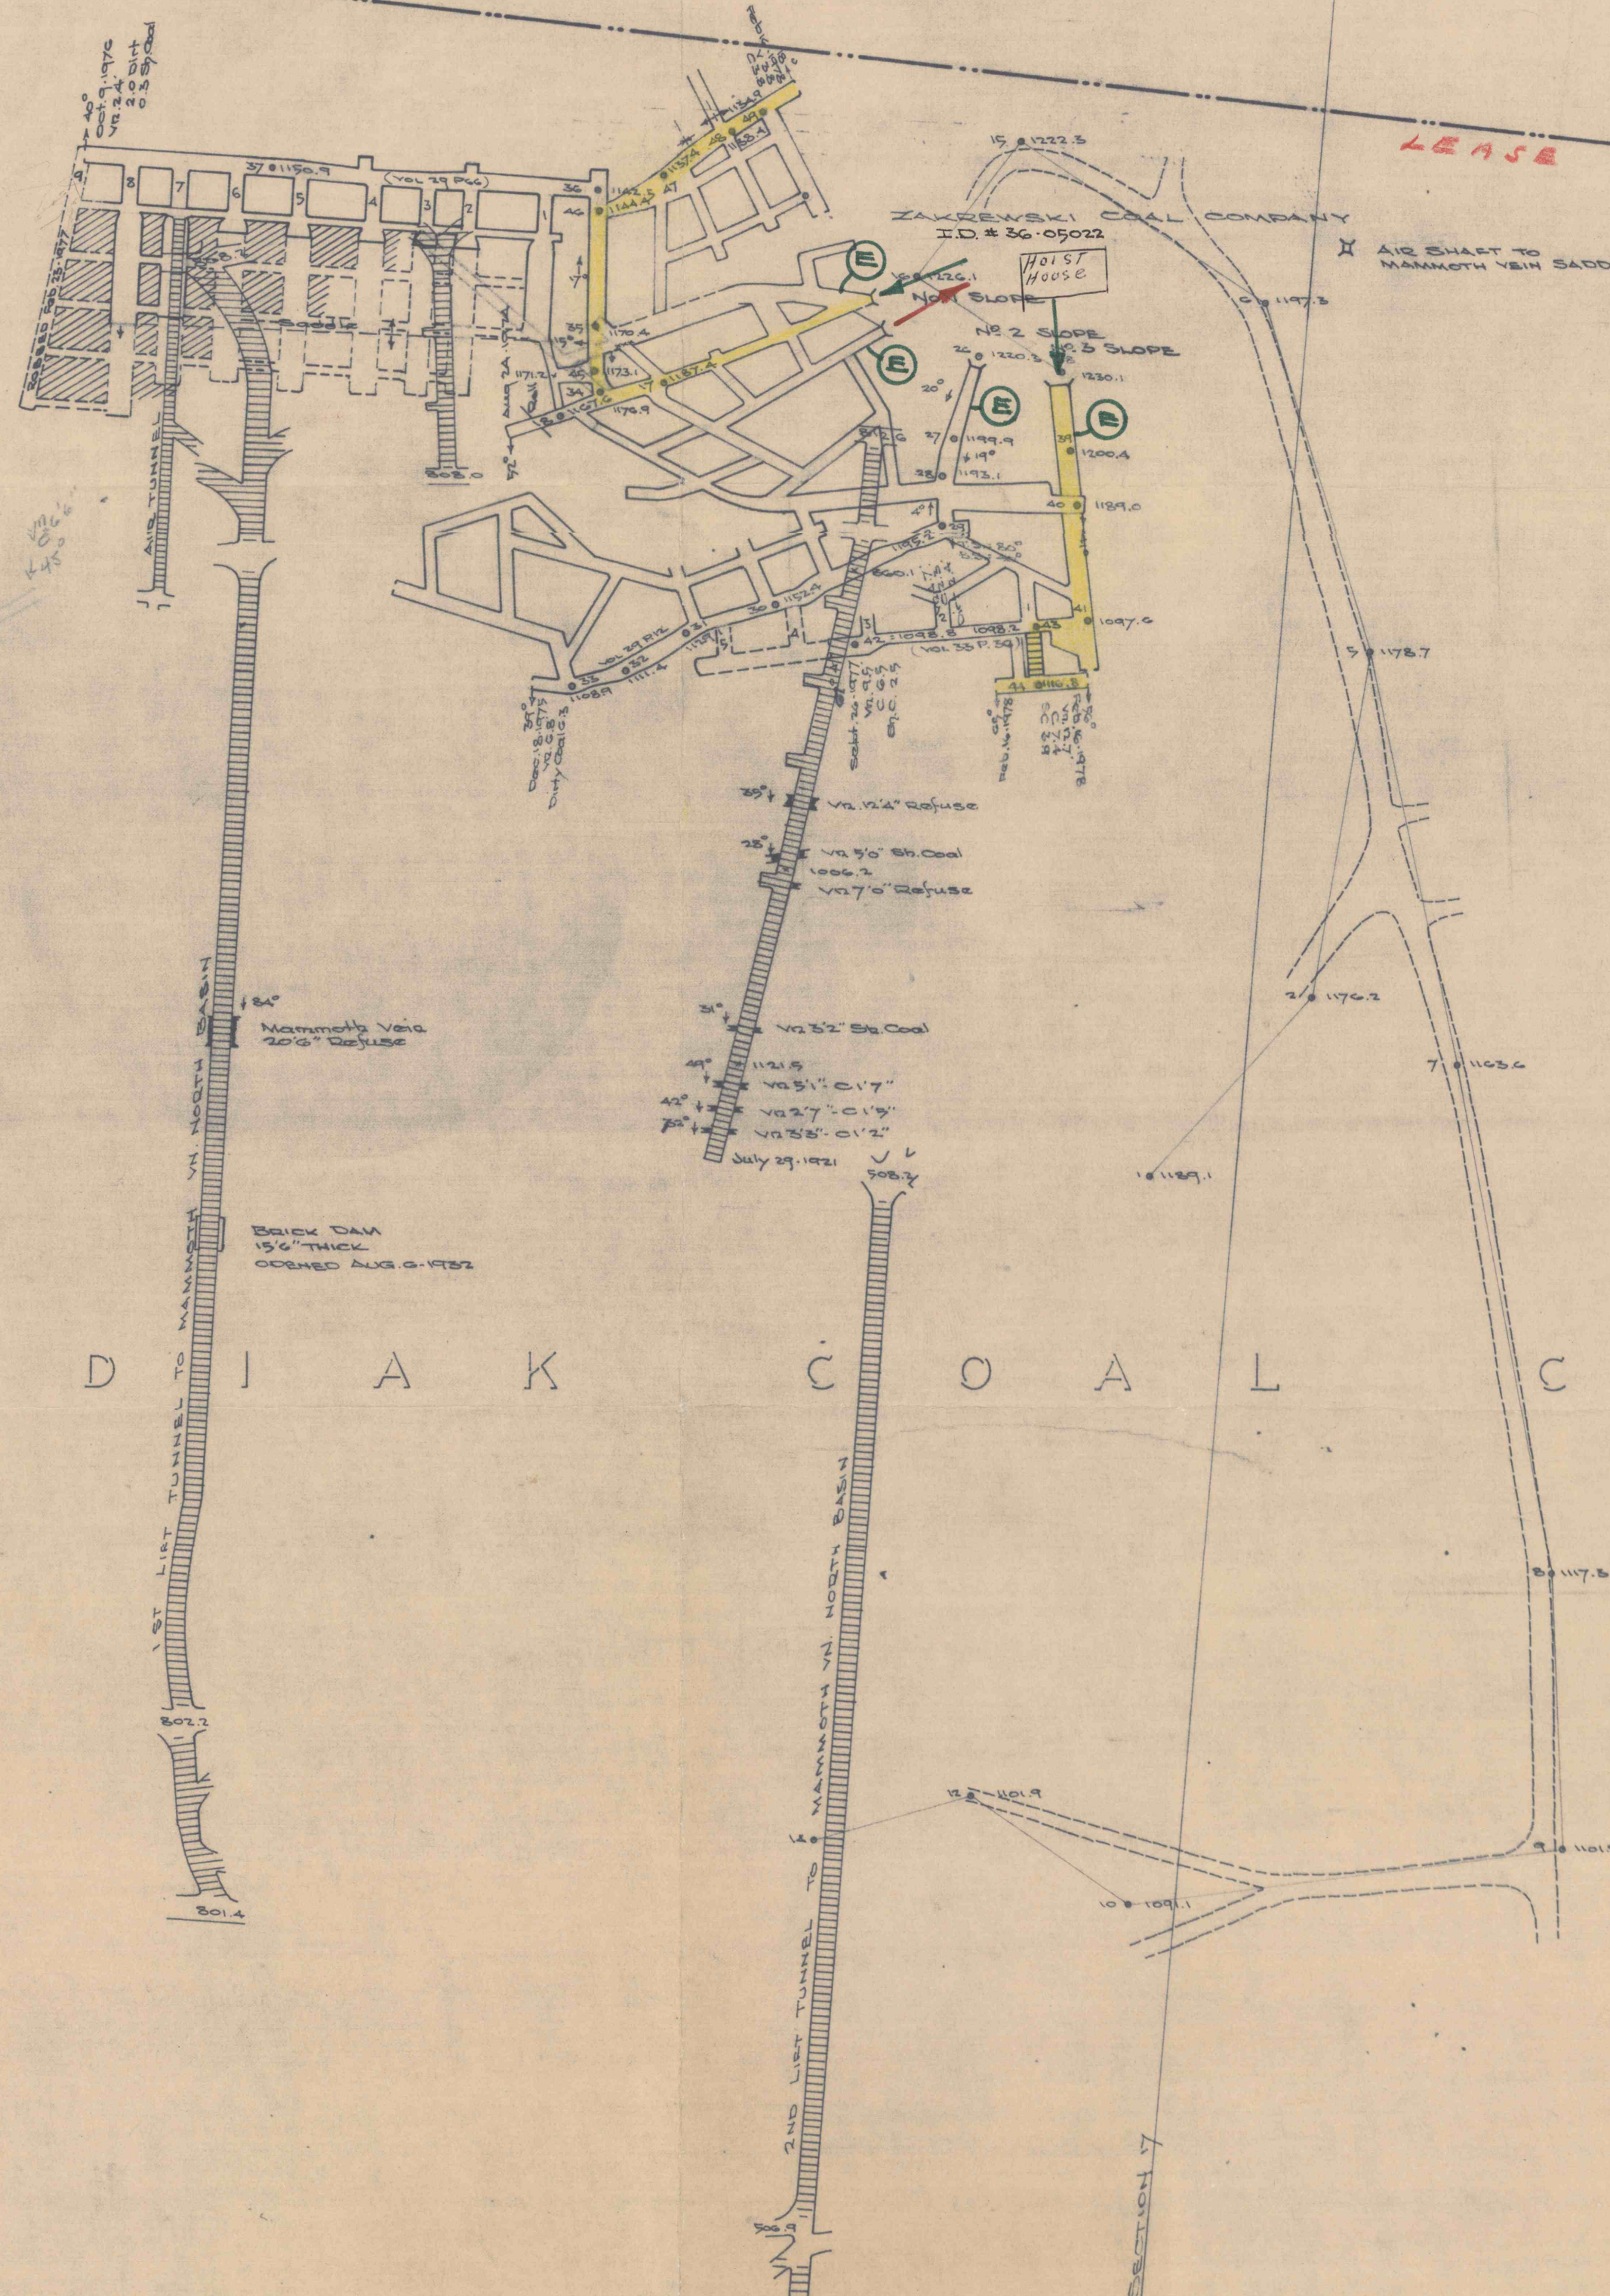

K O D I A K C O A L C O

I.D. #36-05022

MINE MAP

Showing the location and extent of development of the Zakrewski Coal Co. Slope Mine. Situate on the No. and So. dips of the Primrose Vein, Conyngham Twp., Columbia County, Pa.

A.B. Riedel, P.E. Feb. 16, 1978
Scale 1"=100'

Handwritten signature: Riedel