

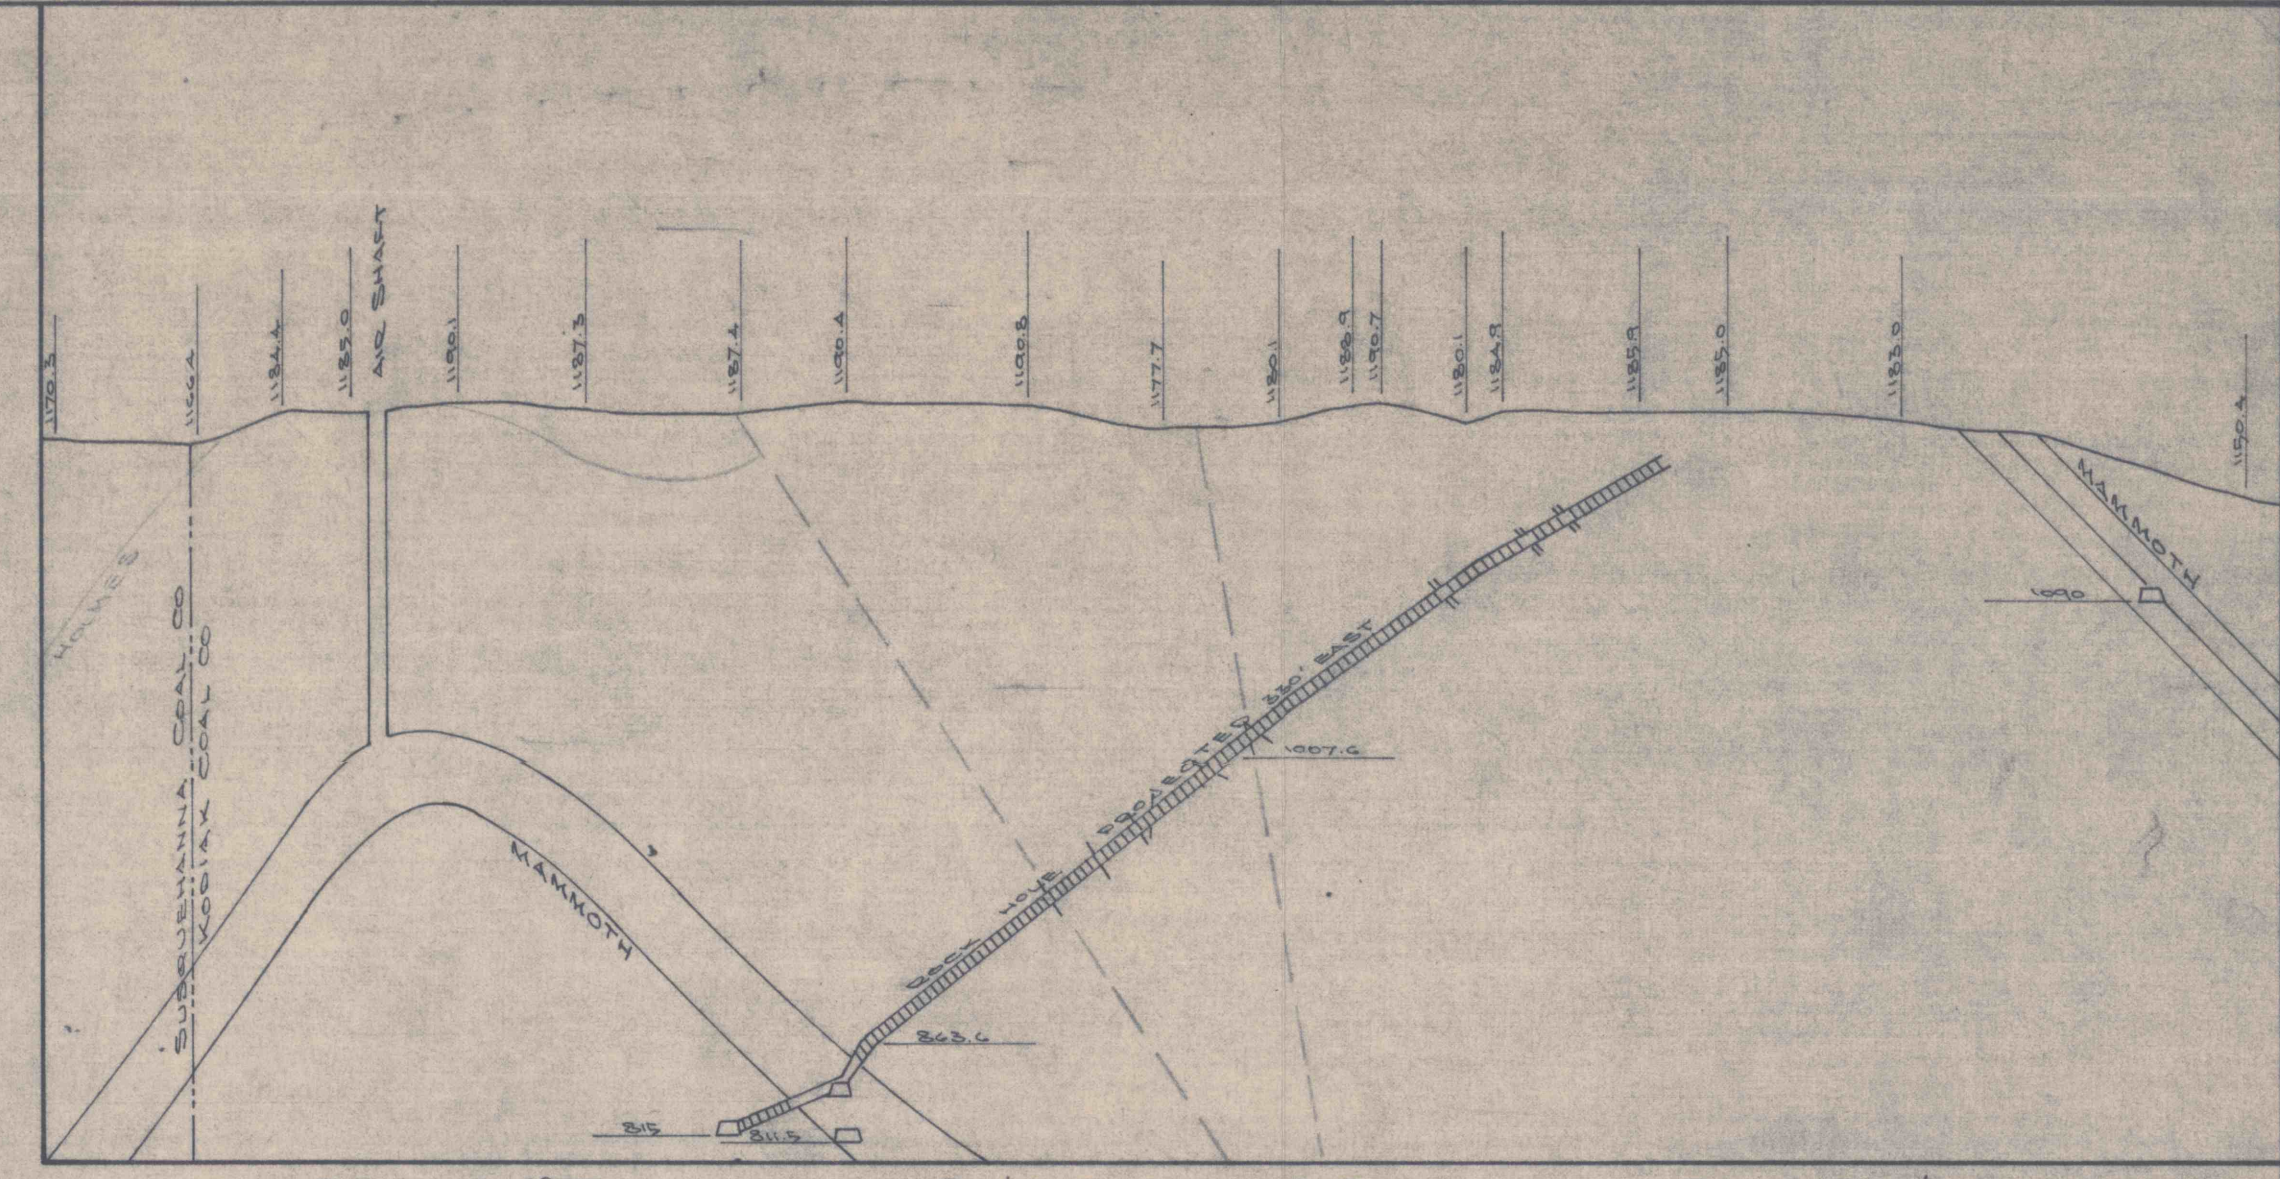


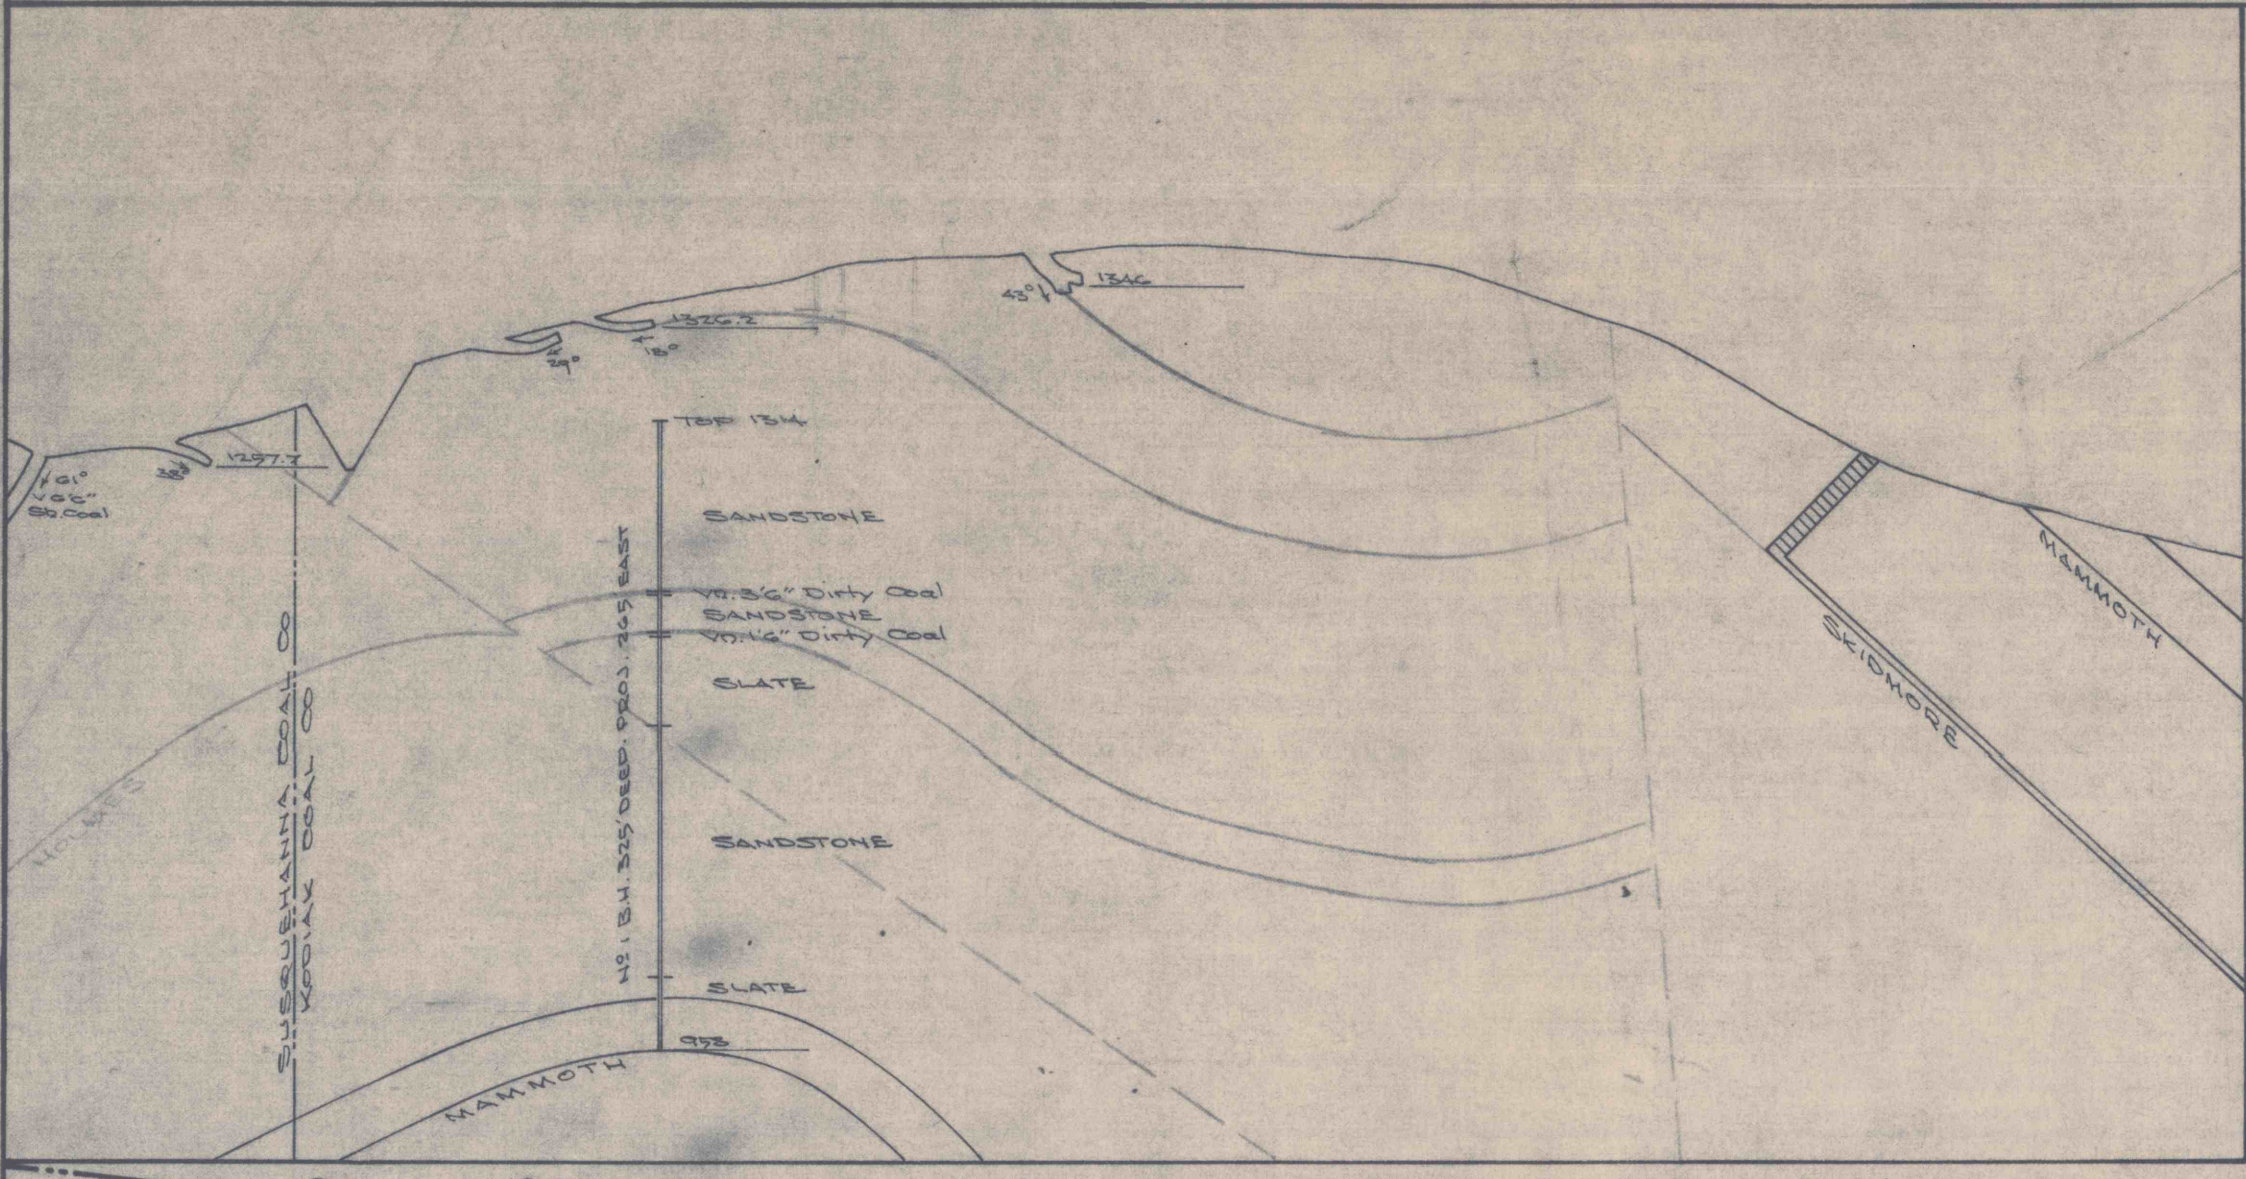

S U S Q U E H A N N A C O A L , C O

K O D I A K C O A L C O

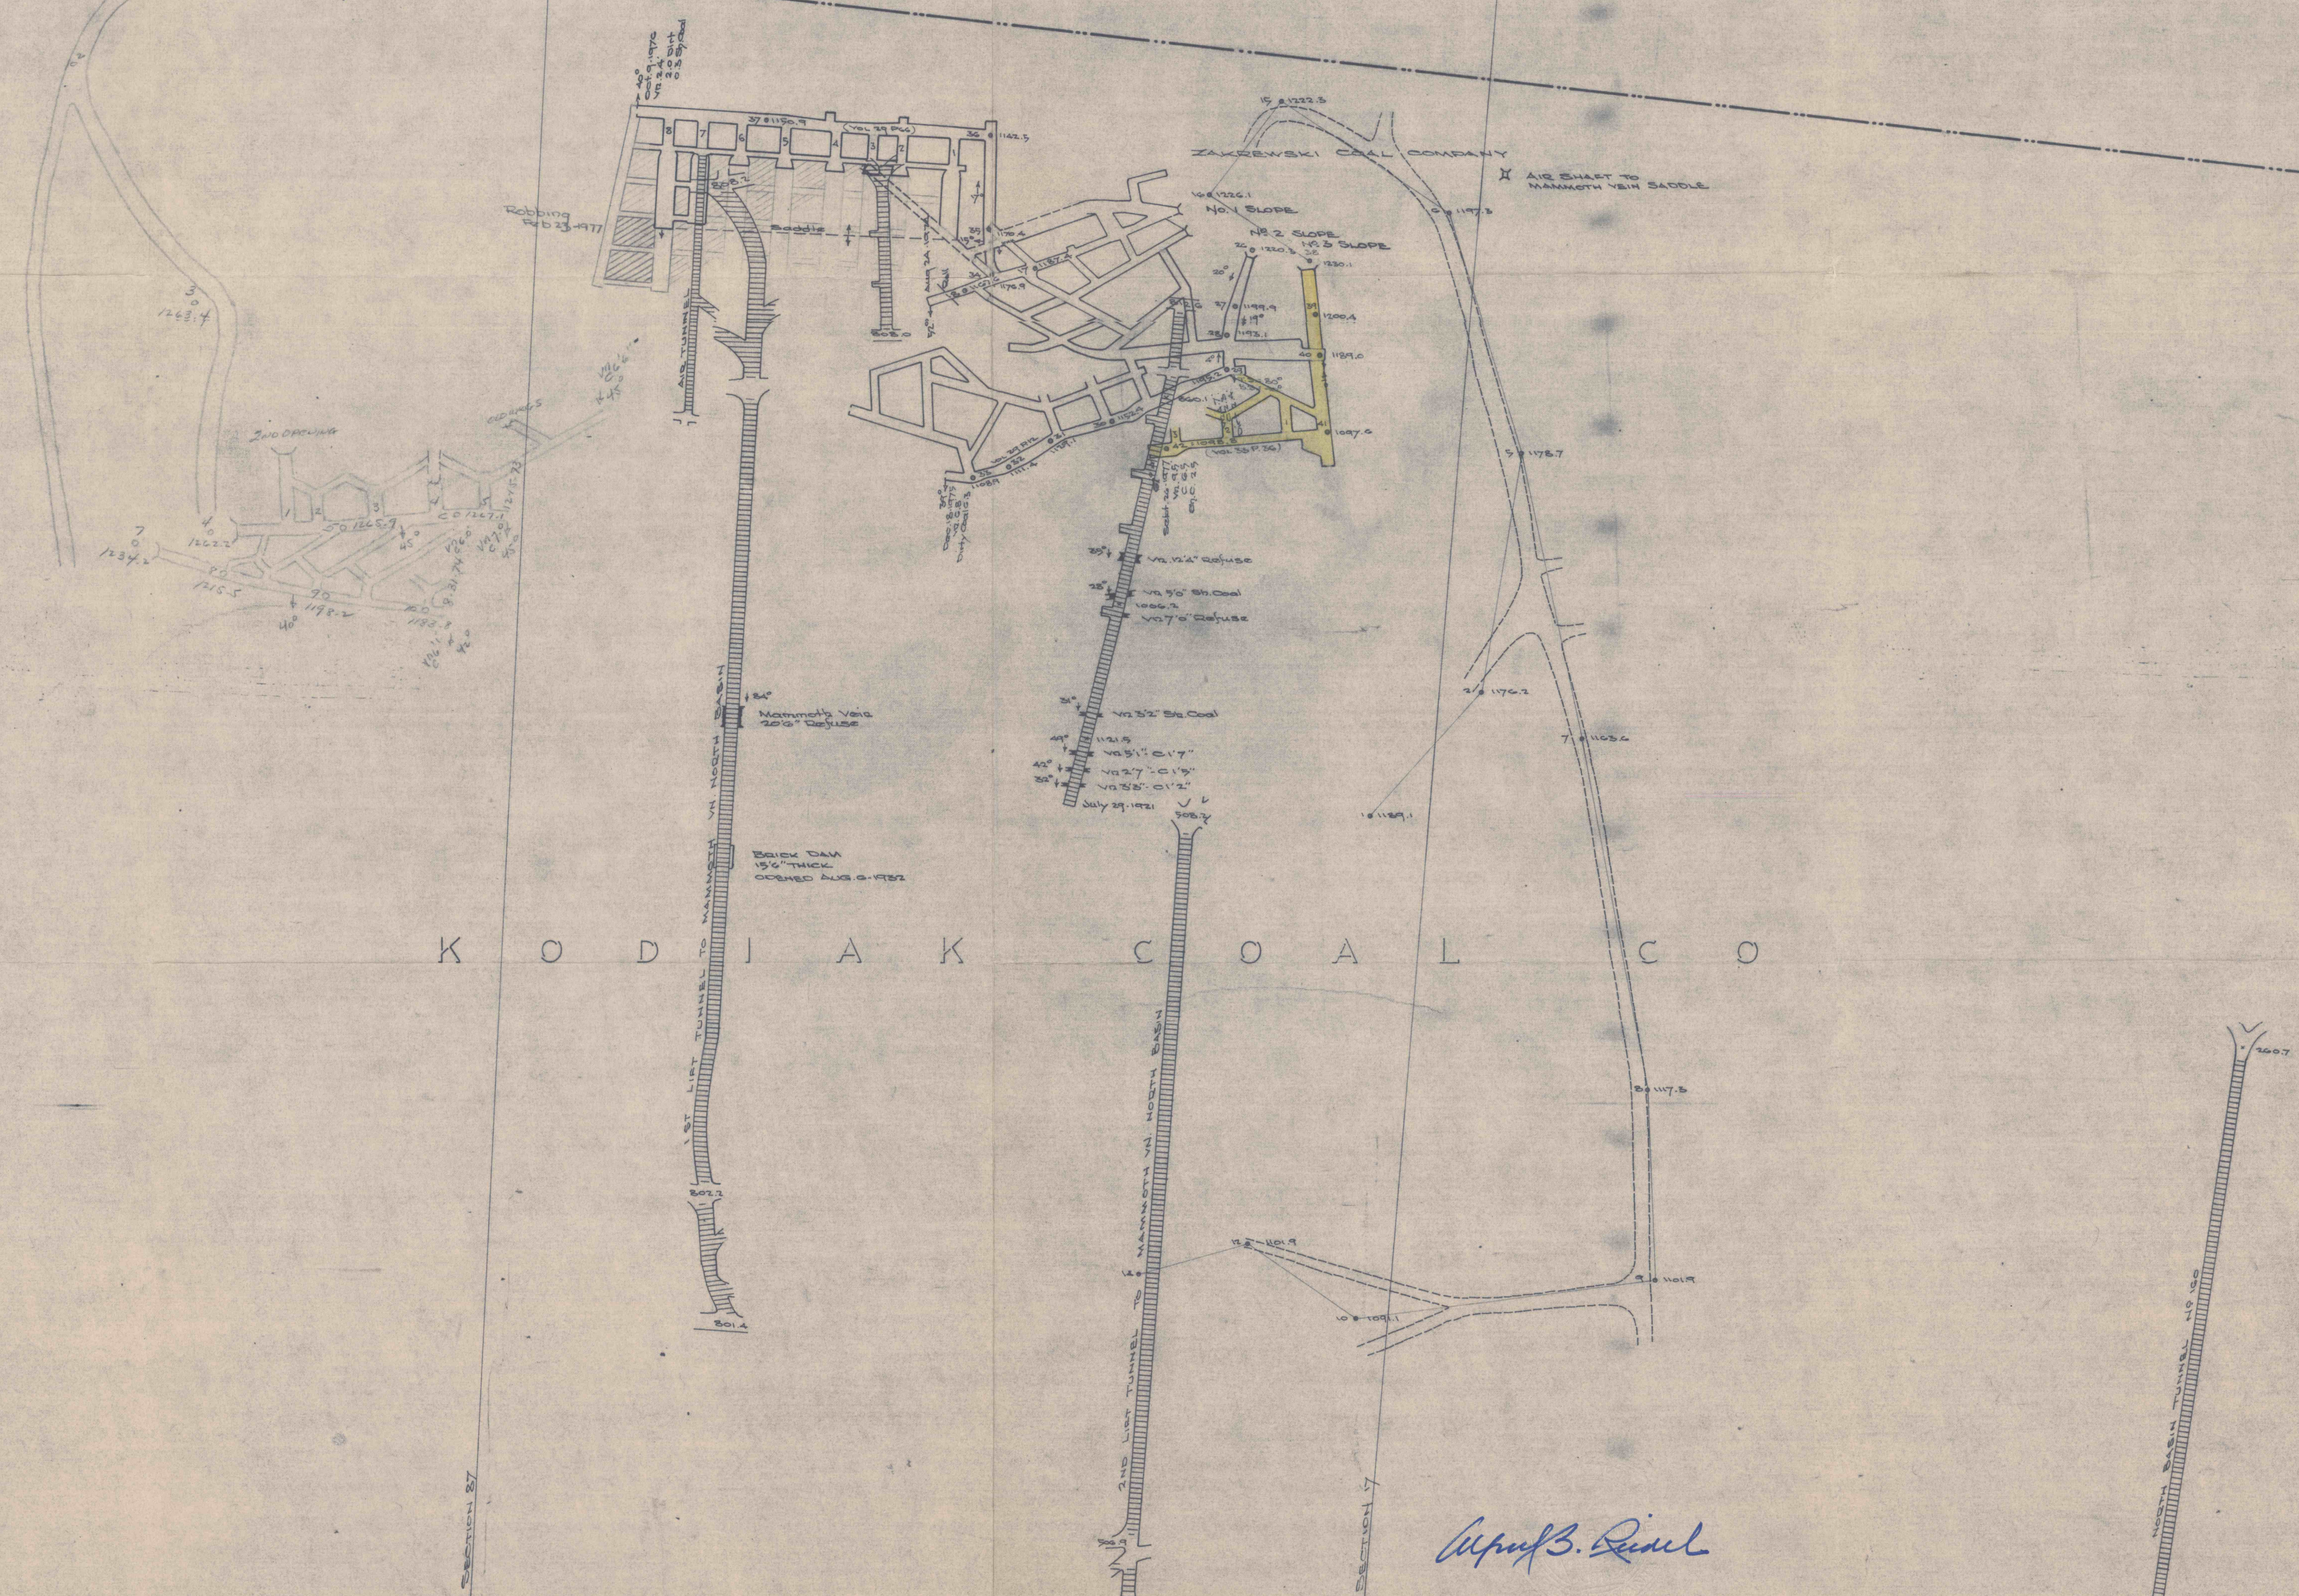

*A. B. Riedel*

MINE MAP  
 Showing the location and extent of development of the Zakrewski Coal Co. Slope Mine. Situate on the So. dip Primrose Vein, Conyngham Twp., Columbia County, Pa.  
 A.B. Riedel, P.E. Sept. 27, 1977  
 1"=100'