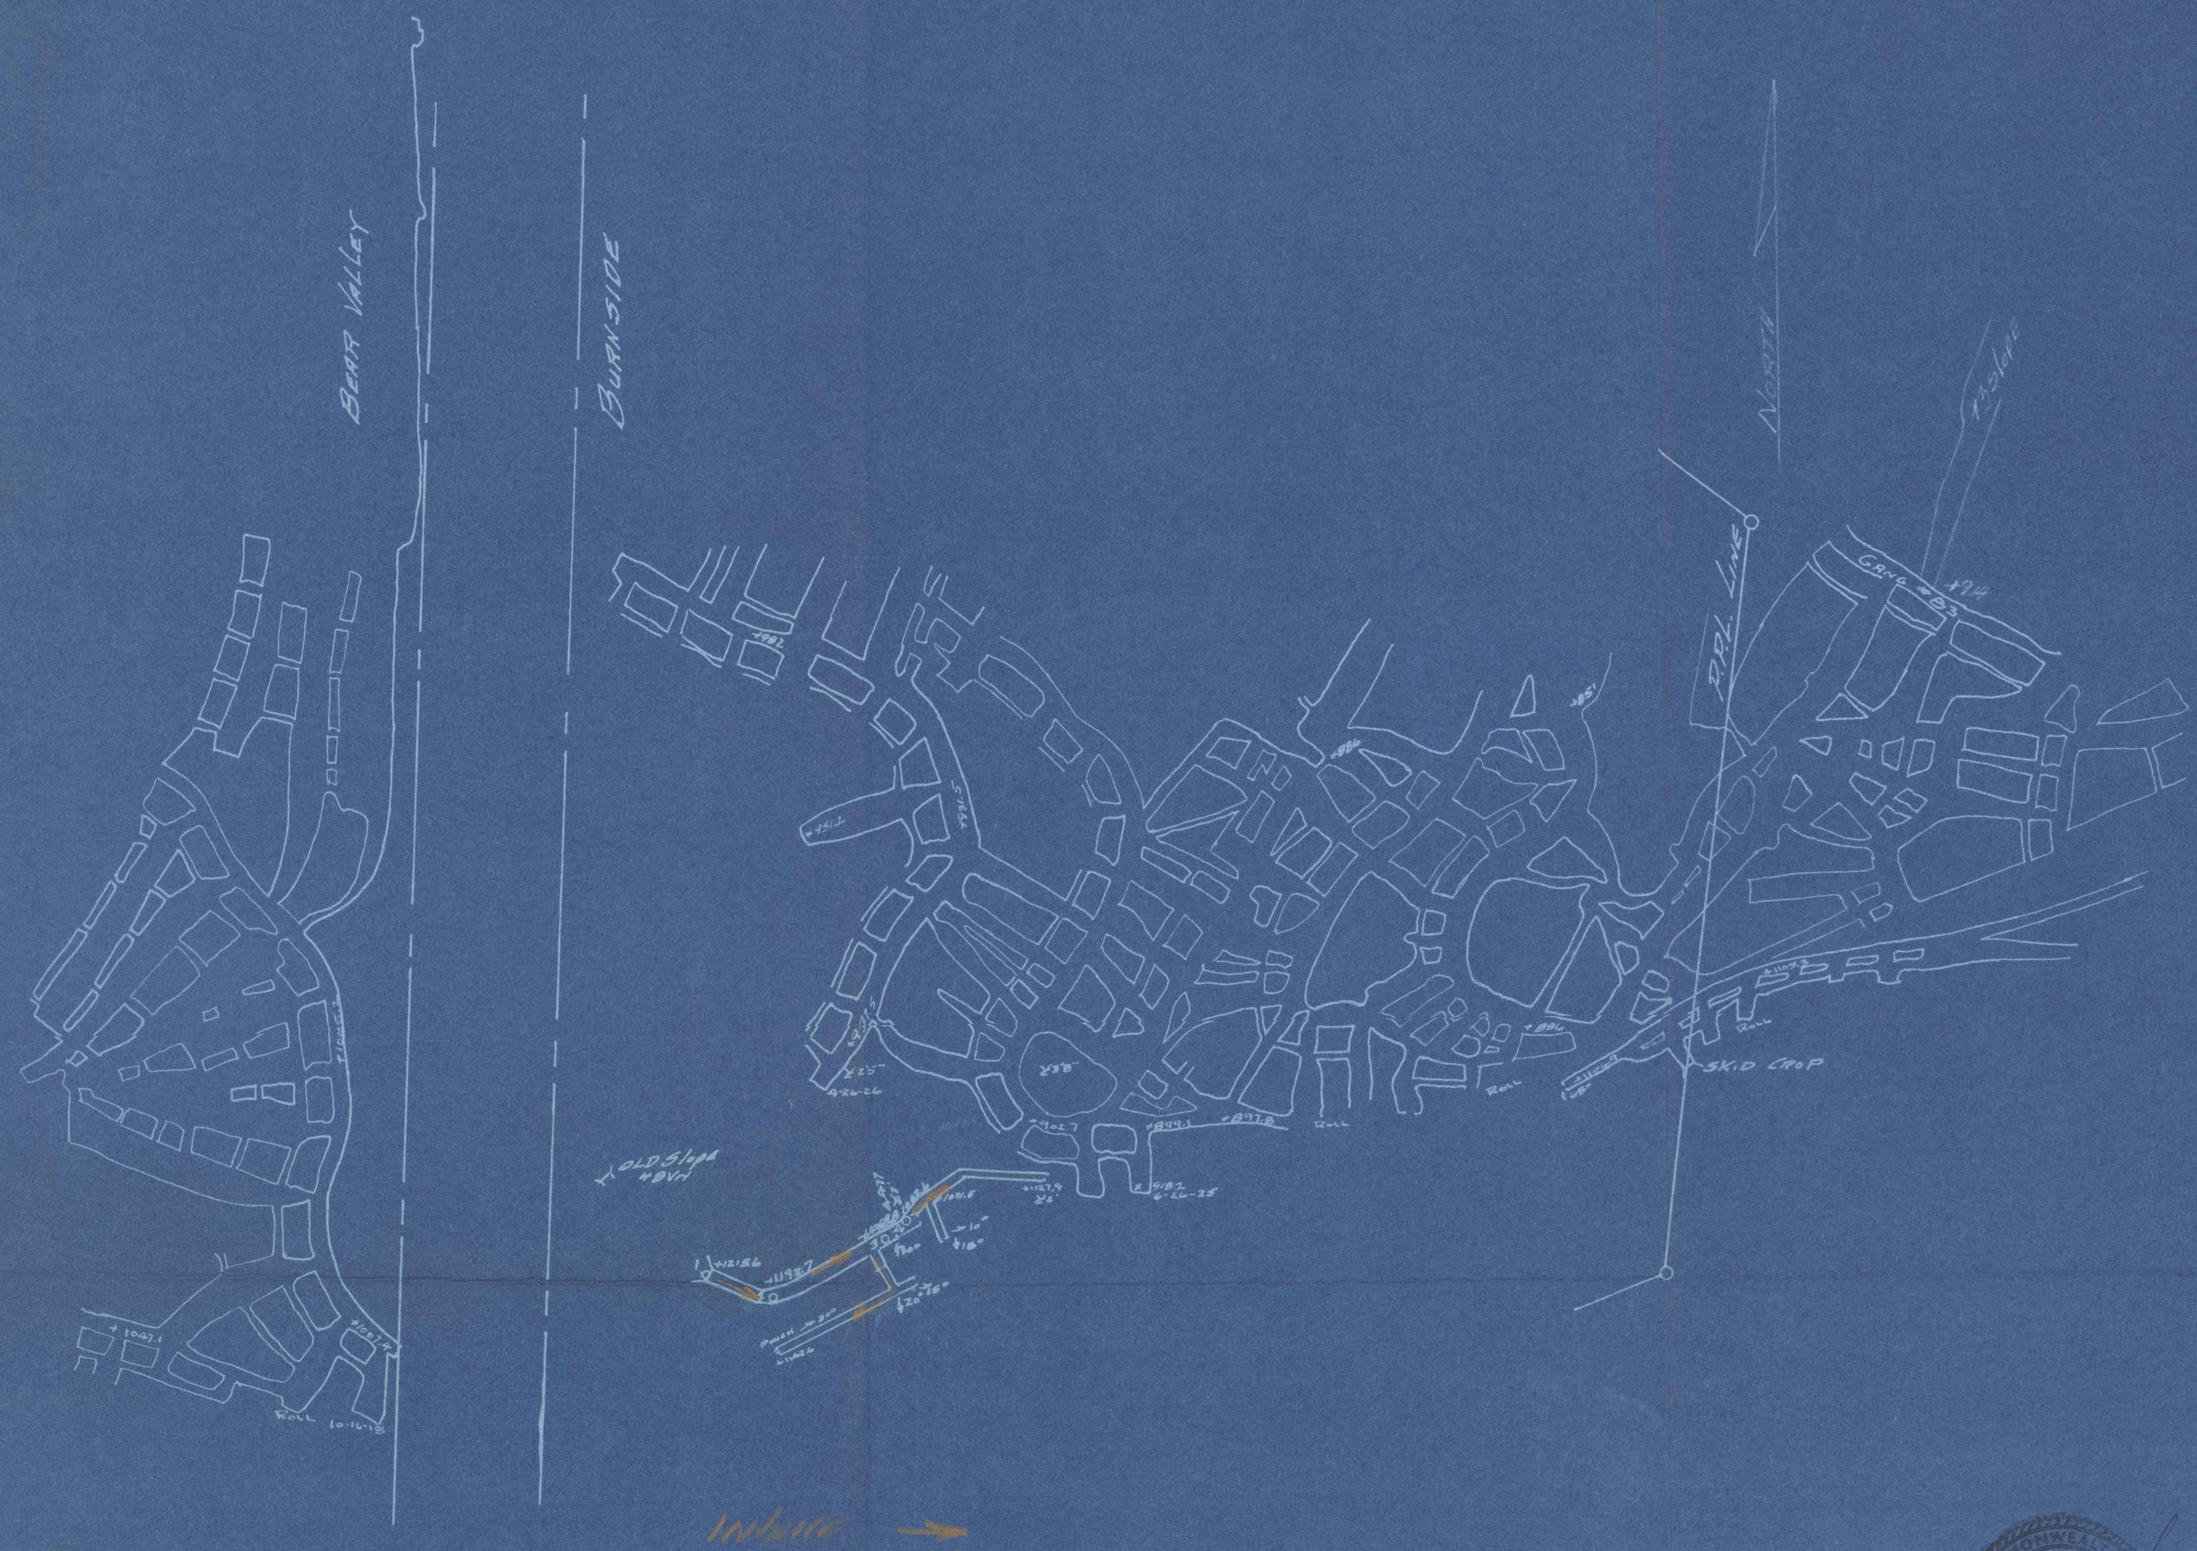

RICHARD PETER LESSER
ENGINEER
No. 796-E
PENNSYLVANIA
10-1-77

K. & W. COAL CO
#7 VEIN
BURNSIDE COLLIERY WORKINGS
CORL TOWNSHIP PENNA
NORTHUMBERLAND CO.
1" = 100'
4-9-77
10-1-77

590